



POOR ORIGINAL COPY
 POOR ORIGINAL COPY

NRH
 101-N 1934 7 37
 (1935)

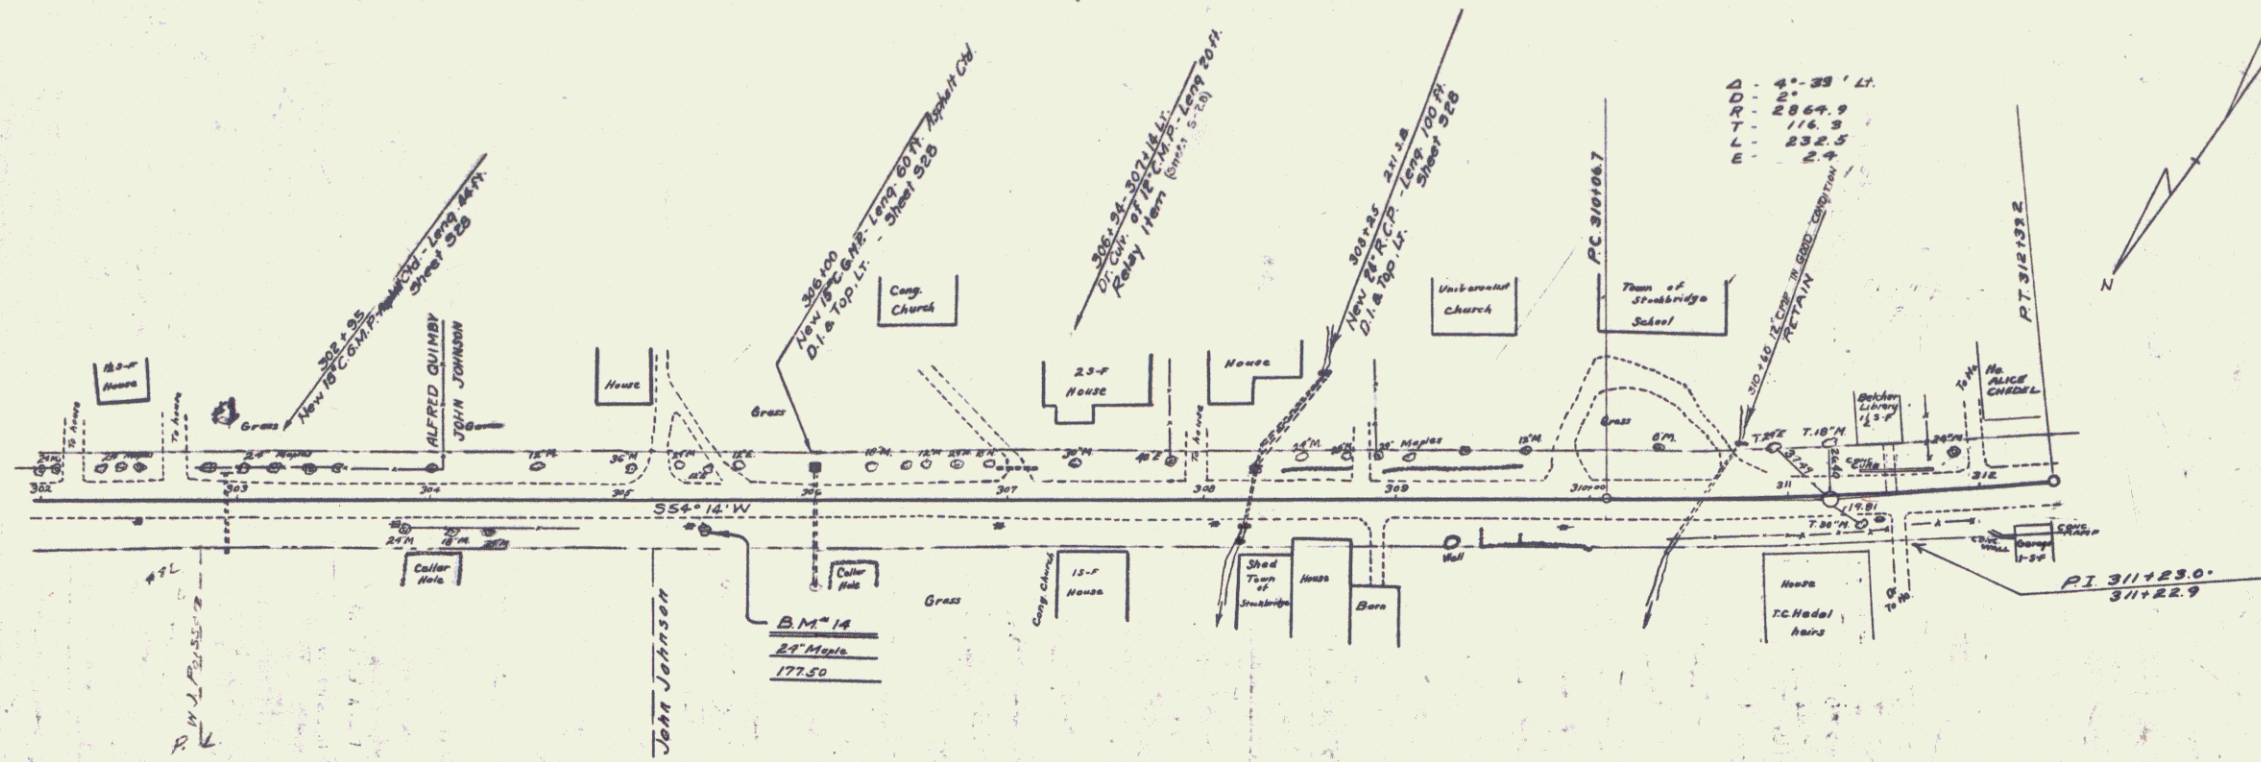

Parcel	Kind of	Date of	Grantor	Grantee	Recorded	Remarks
		Instrument			Stationing	
Col. #1	M.D.	12-25-34	M.J. Poisson	Sh. g. H.	27 547	DRW FILE DATE CUL STA. 14-35 302+95

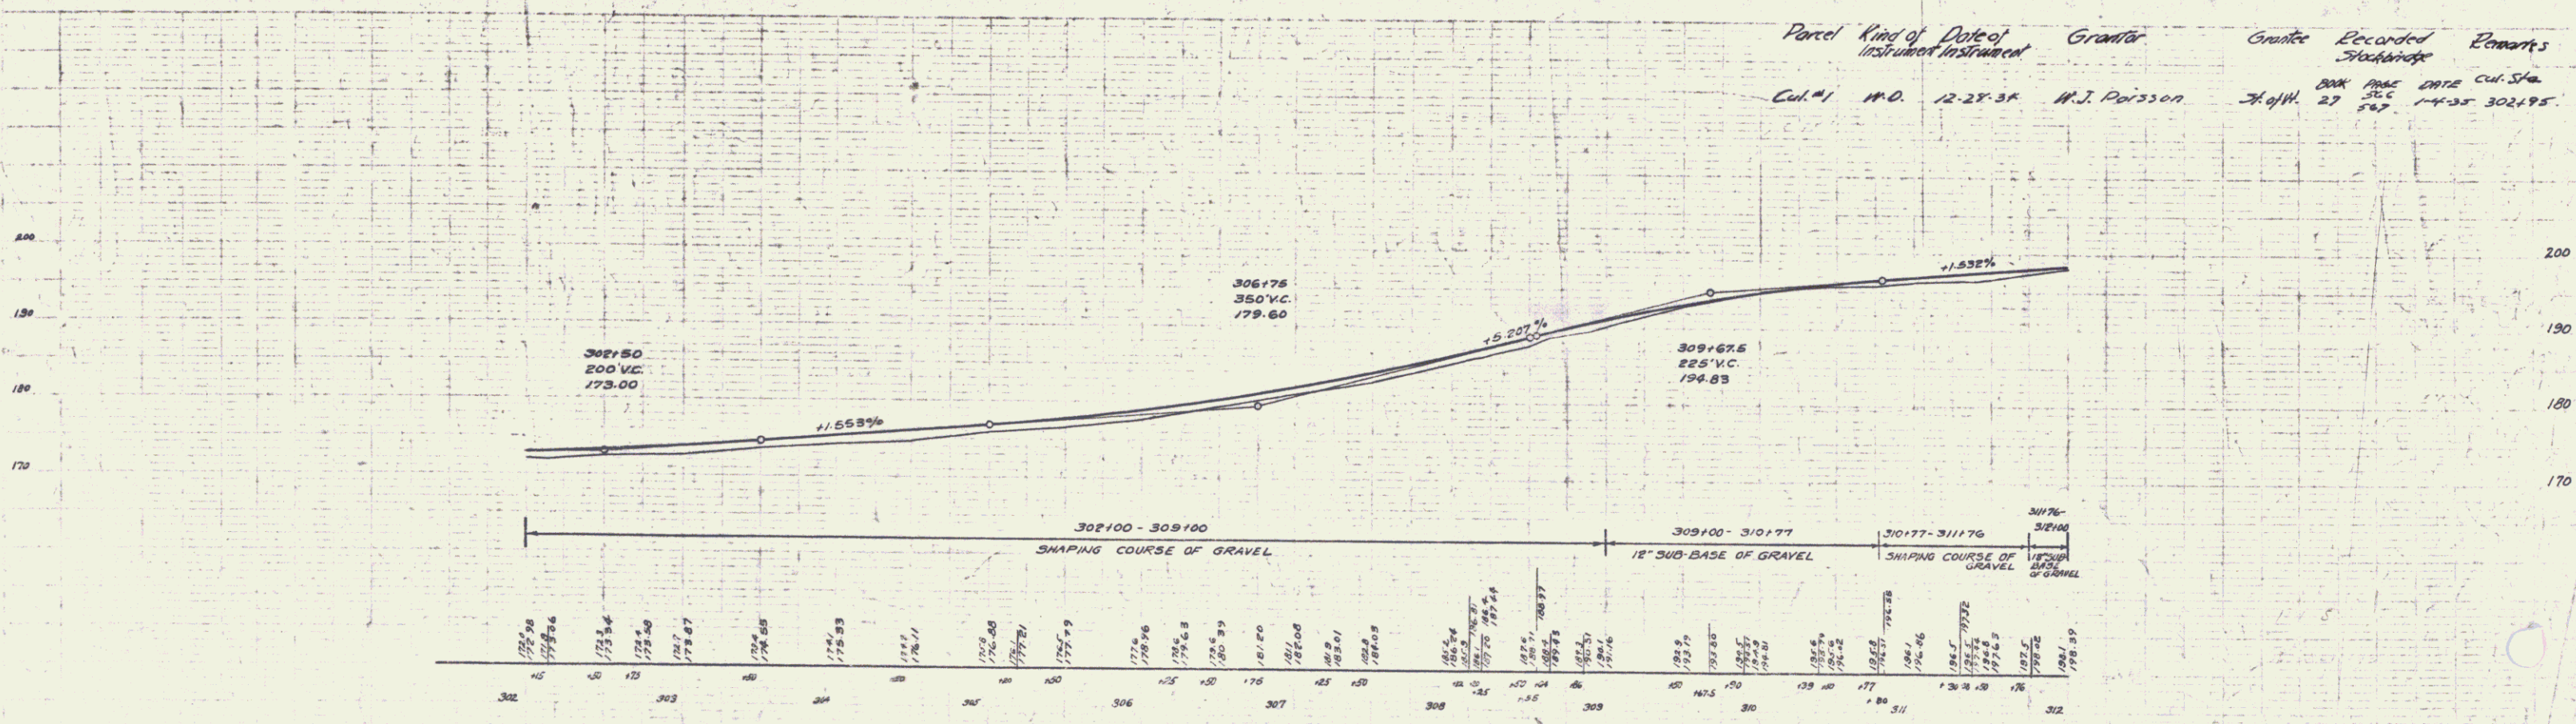

BM 14 SPIKE IN ROOT 24 MAPLE STA. 305+38.14 RT EL. 171.50

SERIES NO. 101-N (1935)
 SHEET 7 OF 37

5