

INDEX OF SHEETS

SHEET NO. 1	TITLE PAGE
" 2	TYPICAL CROSS-SECTION OF IMPROVEMENT
3	PLAN AND PROFILE STA. 0+00 TO 11+00
4	" " " " 11+00 " 26+00
5	" " " " 26+00 " 40+00
6	" " " " 40+00 " 55+00
7-9	STANDARD STRUCTURE SHEETS
10-24	CROSS SECTIONS

PLAN NO.	STATE	FED. AID	PROJECT NO.	SHEET NO.	TOTAL SHEETS
9	Vt.	101C	1920	1	24

STATE OF VERMONT
STATE HIGHWAY DEPARTMENT

PLAN AND PROFILE OF PROPOSED
STATE HIGHWAY

FEDERAL AID PROJECT


BETHEL-STOCKBRIDGE ROAD

TOWNS OF BETHEL AND STOCKBRIDGE

BEGINNING 1200± FEET NORTHERLY OF BETHEL-STOCKBRIDGE


TOWN LINE AND EXTENDING SOUTHERLY 1.0± MILES

LENGTH 5483.3 FEET=1.038 MILES

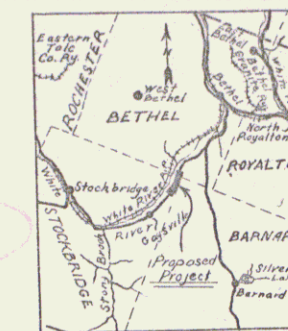

Scale
1 inch = 4 miles

(To Be Returned To R.O.W. Division)
Town of Bethel
PERPETUAL
TOWN FILE
RIGHT-OF-WAY DIVISION

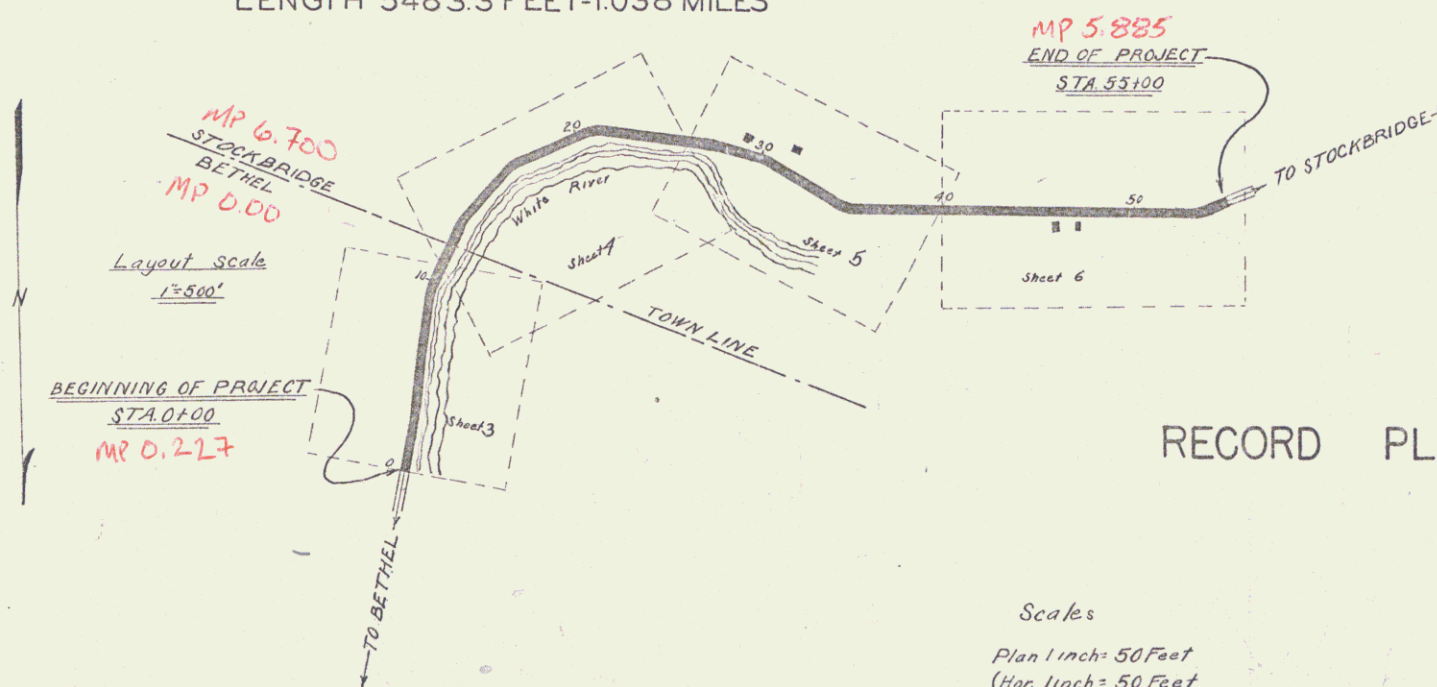

THIS PROJECT WAS SURVEYED DURING THE WINTER OF 1927-28 AND THE ENTIRE PROJECT IS TO BE RECONSTRUCTED WHEN STAKED OUT.
THE GRADES AND QUANTITIES ARE SUBJECT TO REVISION IN ORDER TO ADEQUATELY TAKE CARE OF CONDITIONS AS THEY NOW EXIST.
BORROW AS REQUIRED ON THIS PROJECT TO BE TAKEN FROM THE RIVER BED IN SUCH QUANTITIES AND IN SUCH LOCATIONS AS MAY BE ORDERED BY THE ENGINEER.

RECORD PLANS

RIGHT-OF-WAY DIVISION
TOWN FILE
PERPETUAL

Town of Bethel
(To Be Returned To R.O.W. Division)
APPROVED: MAY 28, 1928

Scales
Plan 1 inch = 50 Feet
Profile (Hor. 1 inch = 50 Feet
Ver. 1 inch = 10 Feet
Cross Sec. 1 inch = 5 Feet

H. S. August
CHIEF ENGINEER

SUBMITTED BY ORDER OF THE STATE HIGHWAY BOARD
MAY 28, 1928

S. B. Bates
COMMISSIONER OF HIGHWAYS

Pin # DOR011
Route VT 107

THIS PROJECT TO BE CONSTRUCTED IN ACCORDANCE WITH STANDARD SPECIFICATIONS ON FILE WITH THE U.S. BUREAU OF PUBLIC ROADS AS APPROVED JULY 7, 1926

THESE PLANS SUBJECT TO SUCH REVISIONS AS MAY BE REQUIRED BY THE BUREAU OF PUBLIC ROADS OR THE CHIEF ENGINEER.

CONVENTIONAL SIGNS	
COUNTY LINE	GROUND ELEVATION..... DATUM..... LINE
TOWN LINE	GRADE ELEVATION..... DATUM..... LINE
FENCE LINE	
STONE WALL	
UNFENCED PROPERTY	
GUARD RAIL	
TRAVELED WAY	
RAILROAD	
RETAINING WALL	
CENTER LINE	
SURVEY LINE	
CULVERT	
DROP INLET	
TROLLEY POLE	
POWER POLE	
TELEPHONE POLE	
TREES	
HEDGE	

CURVE DATA	
DEFLECTION ANGLE..... Δ	
DEGREE OF CURVE..... D	
RADIUS OF CURVE..... R	
TANGENT DISTANCE..... T	
LENGTH OF CURVE..... L	
EXTERNAL DISTANCE..... E	
POINT OF INTERSECTION..... P. I.	
POINT OF CURVE..... P. C.	
POINT OF TANGENT..... P. T.	
POINT ON TANGENT..... P. O. T.	

BETHEL-STOCKBRIDGE FR 3B ICI-C
RECORD PLANS
CONTRACTOR ATWOOD THOMAS CONSTRUCTION CO.
FISCAL YEAR 1928

SERIES F. No. 101C FILED
SHEET 1 OF 211