


PLAN
 DATE
 DRAWN BY
 CHECKED BY

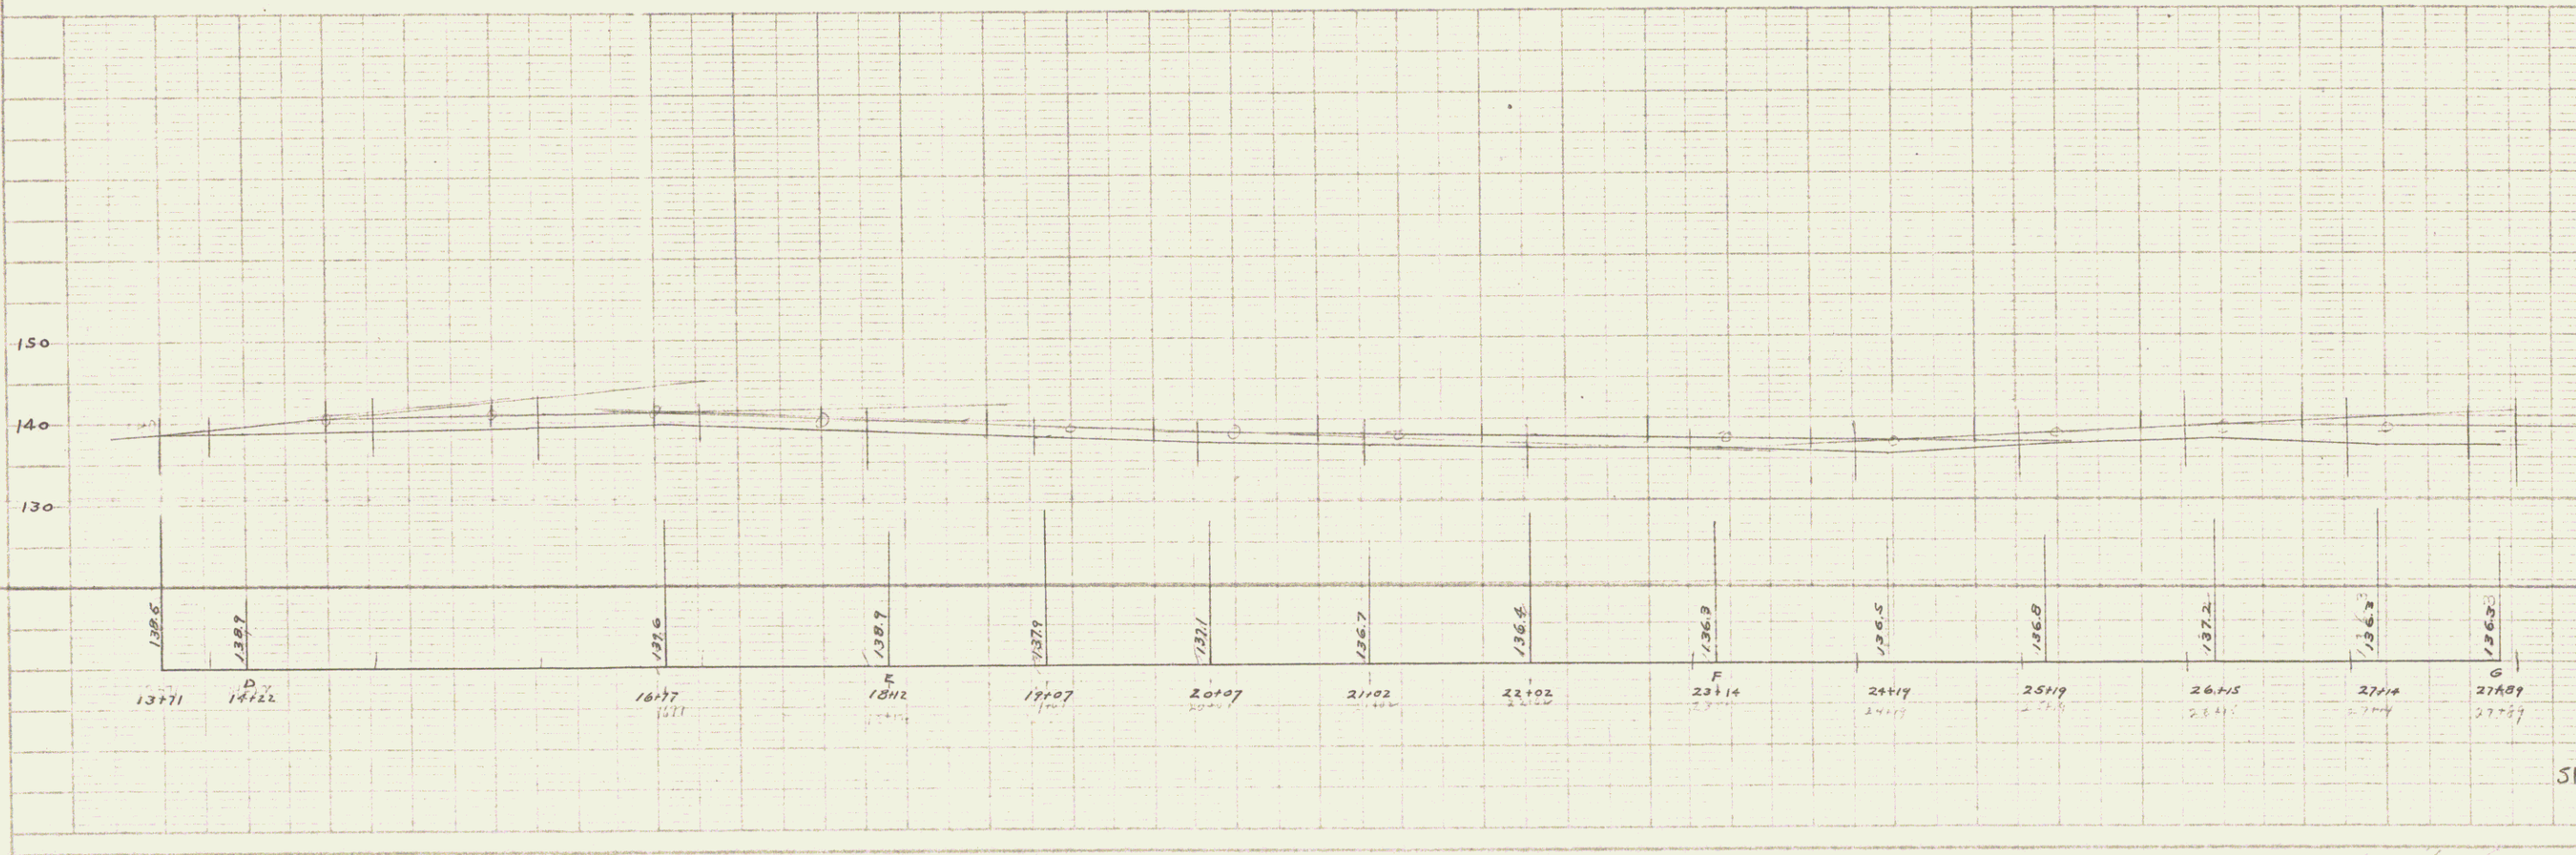

SHEET 7D

10