



Parcel	Kind of Instrument	Date of Instrument	Grantor	Grantee	Recorded Book	Remarks
A, B, C, D	G.C.D.	6-8-33	J.A. Graham	St. of Yt.	36 Wiley, 7-11-33	Elev. Sta. 2144 (2140, 2142, 2145)

101-M 1933 5 48

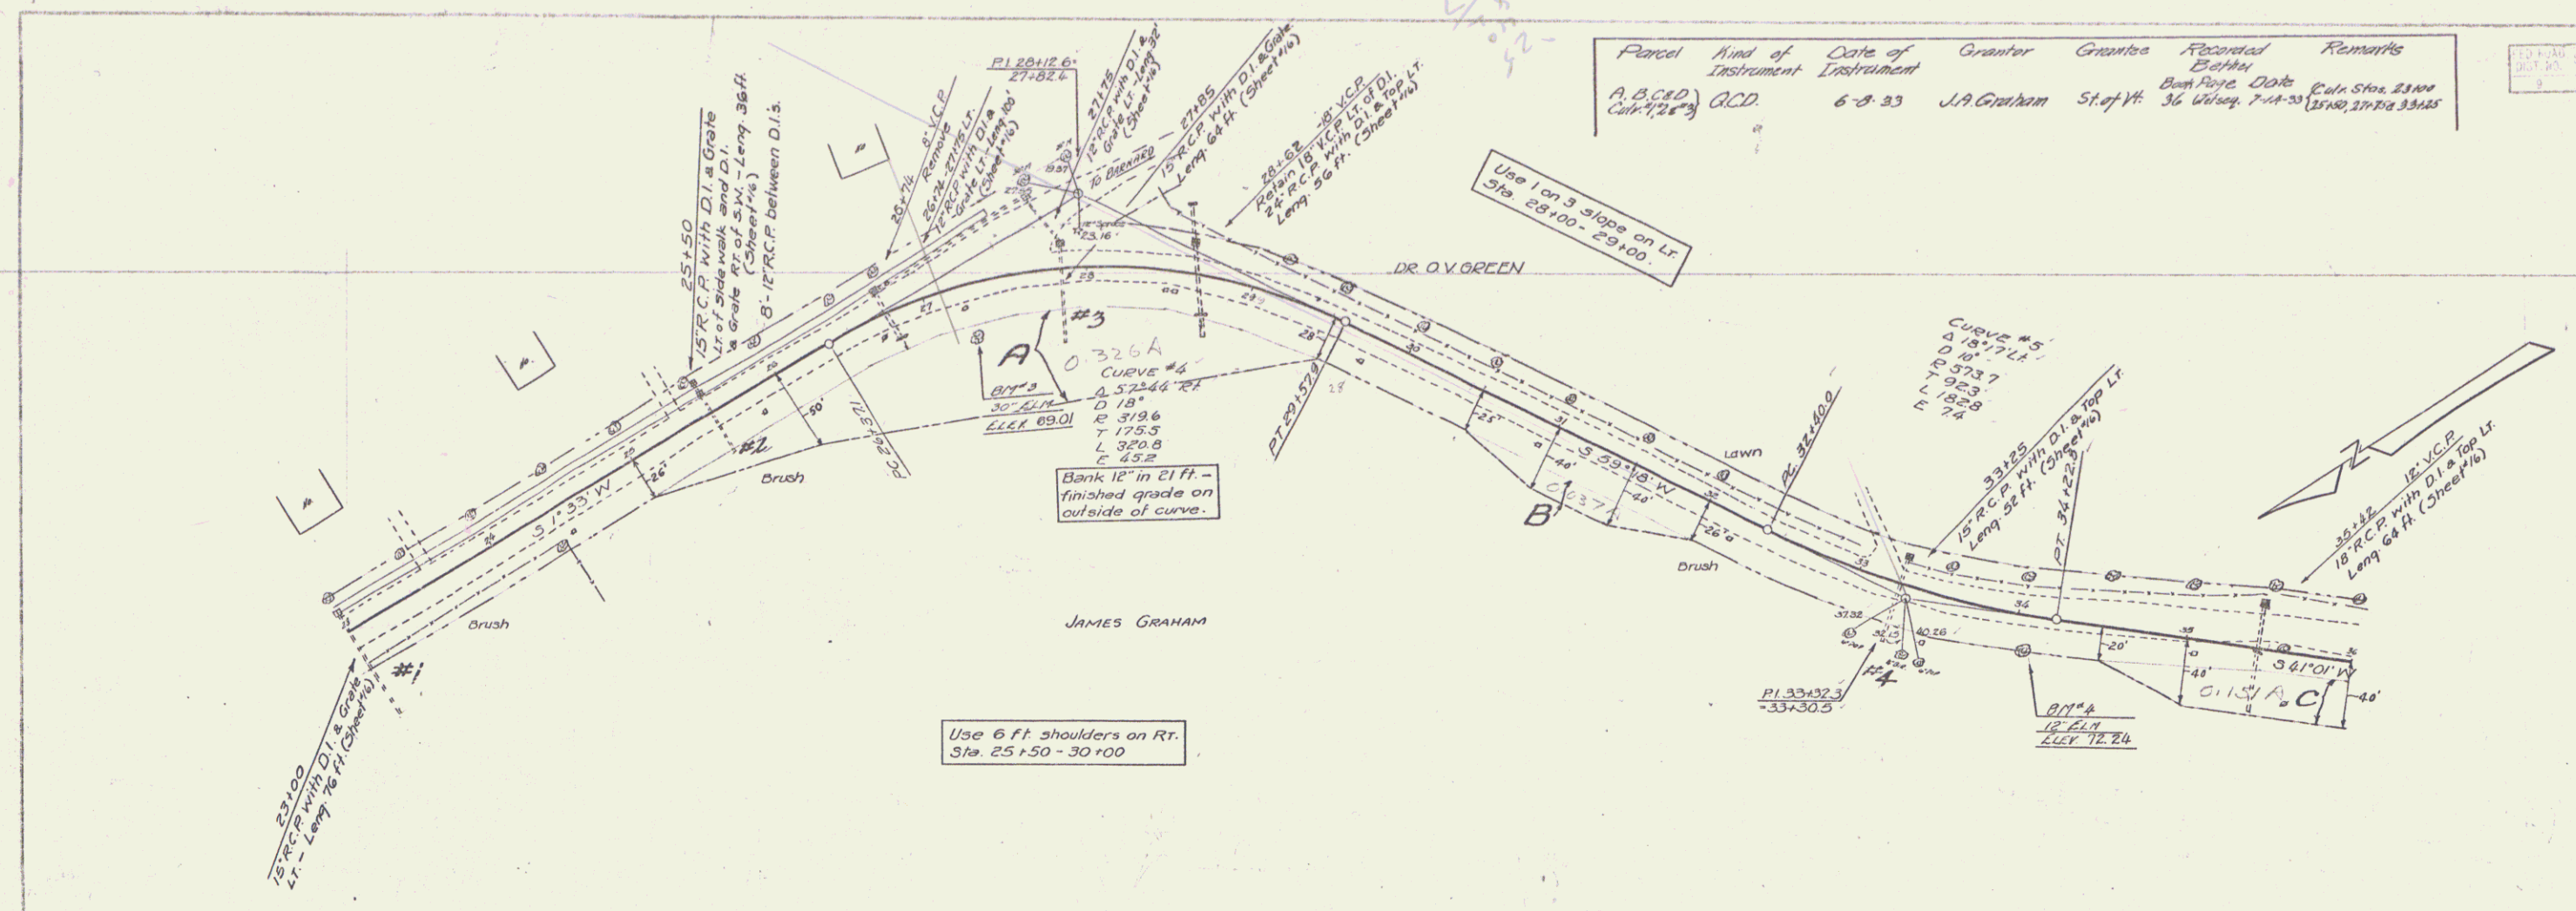

GRADE REVISION - JULY 20-31		JULY 24-33	
STA. 25+00	STA. 34+00	STA. 25+00	STA. 34+00
Original Curve	Revised Curve	Revised Curve	
23+75-200'VC-65.33	23+75-200'VC-65.33	23+75-200'VC-65.33	
24+25-100'VC-68.50	25+75-100'VC-68.67	25+20-150'VC-68.25	
29+00-200'VC-68.60	29+00-200'VC-68.00	29+20-200'VC-68.25	
32+75-200'VC-72.00	33+00-200'VC-72.99	33+50-200'VC-72.94	
36+50-200'VC-72.69	36+50-200'VC-72.69	36+50-200'VC-72.69	

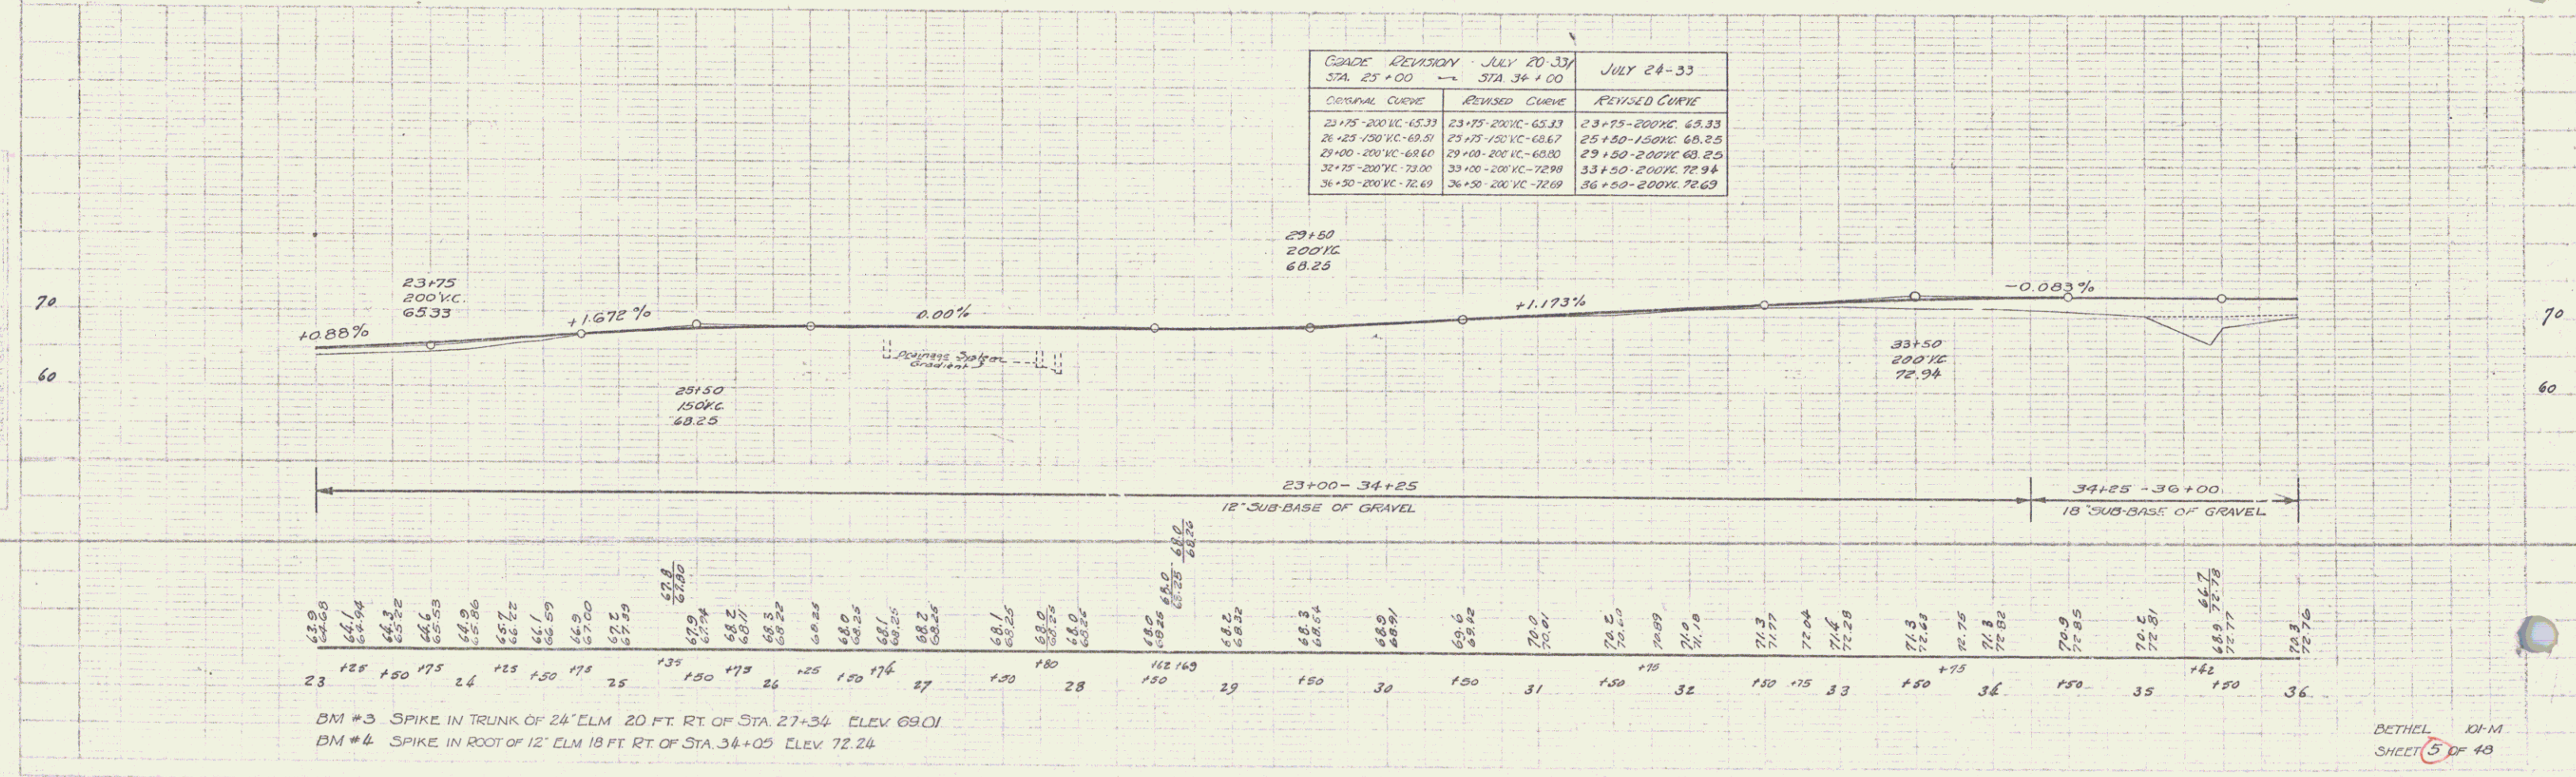

BM #3 SPIKE IN TRUNK OF 24' ELM 20 FT RT OF STA 27+34 ELEV 69.01  
 BM #4 SPIKE IN ROOT OF 12' ELM 18 FT RT OF STA 34+05 ELEV 72.24

D. THEIL XI-M  
 SHEET 5 OF 48