


Parcel	Kind of Instrument	Date of Instrument	Grantor	Grantee	Recorded	Remarks
8744-24-3	G.C.D.	6-15-33	F.H. Putnam	St of Yt.	36 75	7-14-33 Cdn Sta. 5140-5310
A.D. Cur. #1	"	7-12-33	S. D. Stanton	"	36 86	7-14-33 Cdn Sta. 61-140

STATE ROAD LOCAL SHEET NO. 101-11 1933 7 48


Note: Sta 52+00 use 1 on 1 slope left

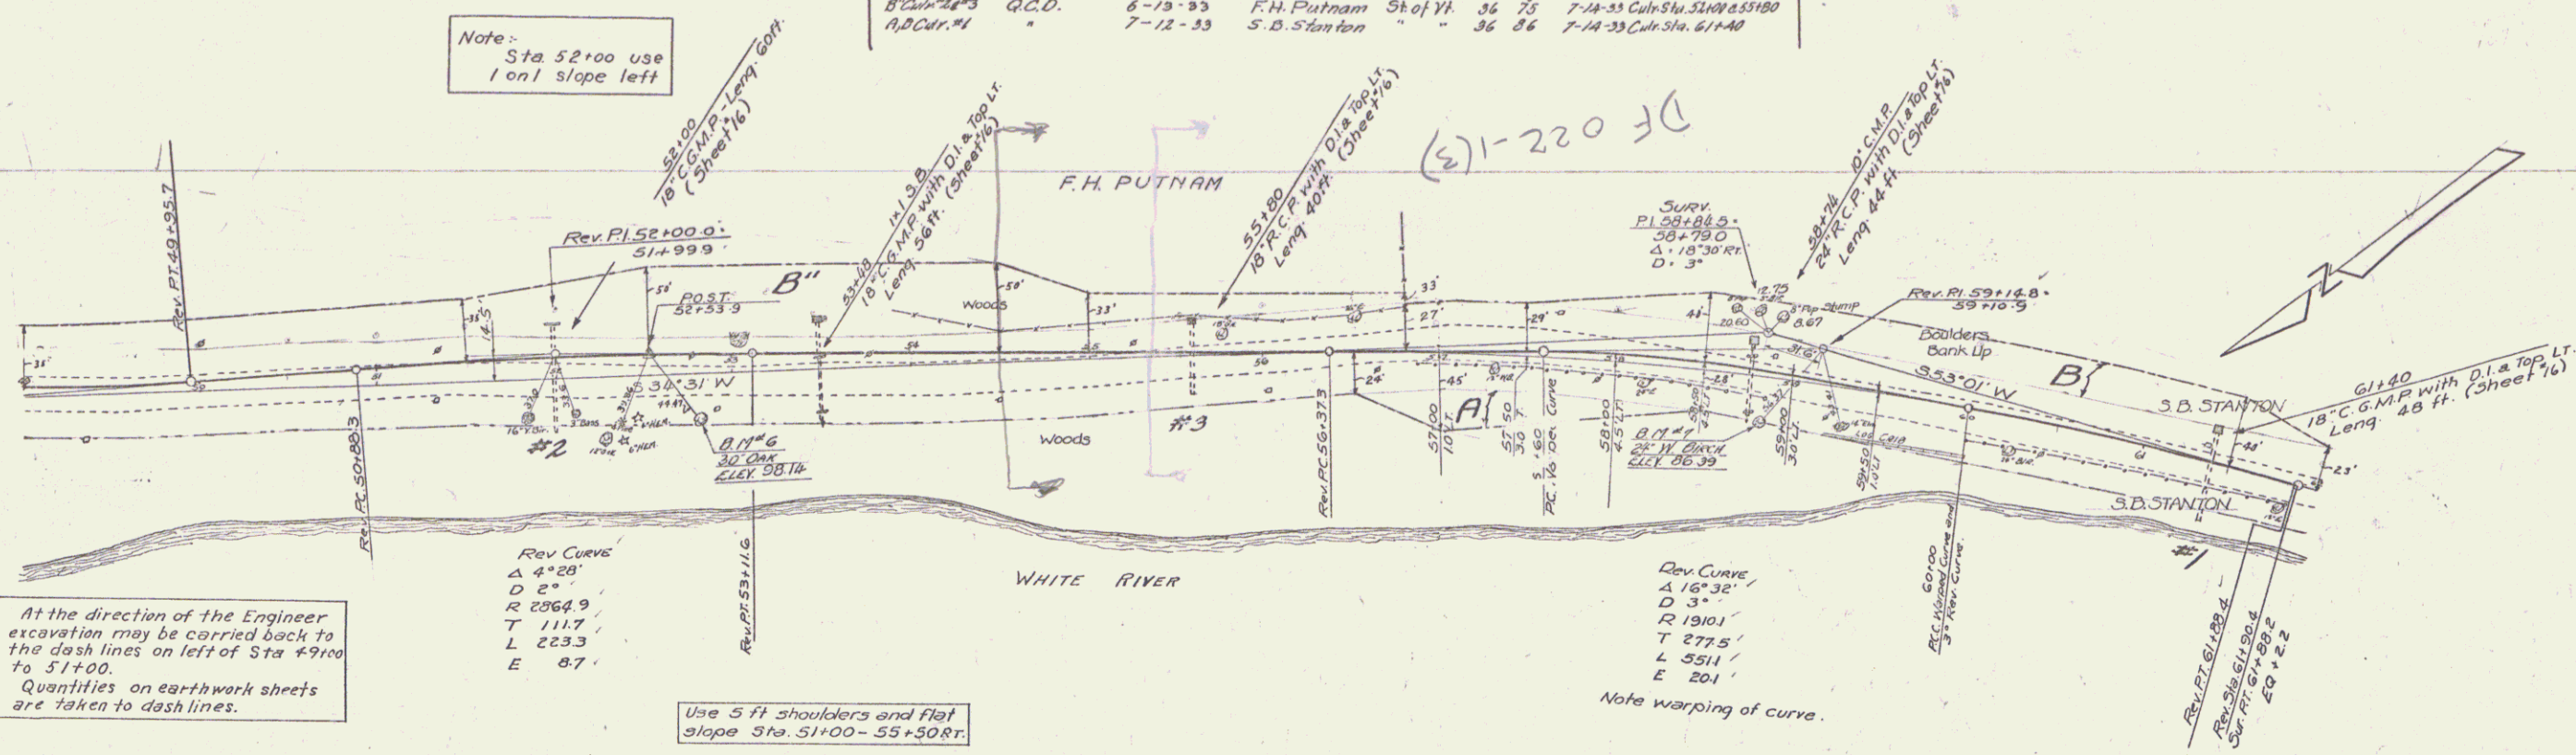

At the direction of the Engineer excavation may be carried back to the dash lines on left of Sta 49+00 to 51+00. Quantities on earthwork sheets are taken to dash lines.

Use 5 ft shoulders and flat slope Sta. 51+00-55+30Rt.

Note warping of curve.

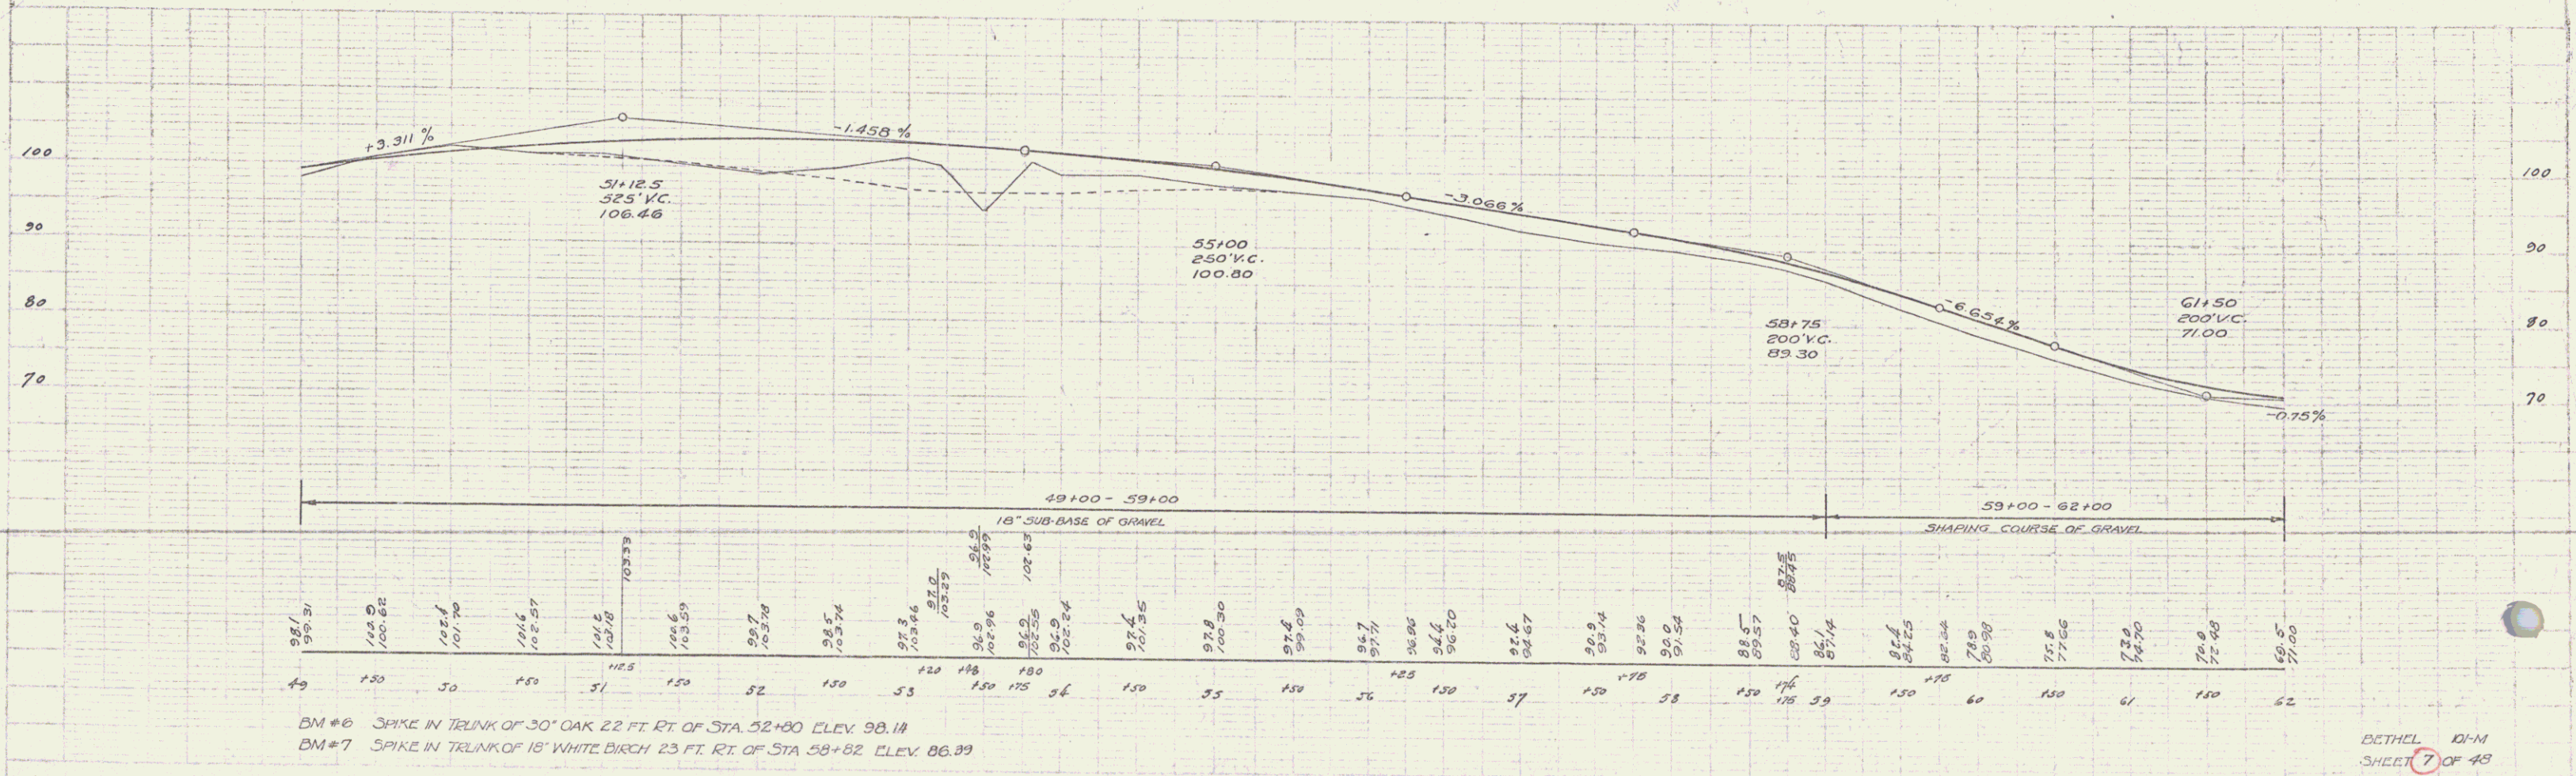

BM #6 SPIKE IN TRUNK OF 30' OAK 22 FT. RT. OF STA. 52+00 ELEV. 98.18  
 BM #7 SPIKE IN TRUNK OF 18' WHITE BIRCH 23 FT. RT. OF STA. 59+82 ELEV. 86.39

BETHCL 10-M SHEET 7 OF 48