

STEEL GUIDE POSTS
 54+06 Rt - 55+66 Rt - 6 200'

#2 JESSIE A. PUTNAM
 (A.O.B.E.) STA 52+00 - 56+97
 W.D.E. 9/21/58
 RECORDED: BETHEL-BK 41-PG 398A-399-9/6/58


Three Cable Guard Rail w/Steel Posts
 54+16 - 68+00 - 118.2 RT
 Lt 18' 55+35 - 65+00
 66+75 - 67+25
 66+85 - 67+34

SURVEY
 PL 581030
 Δ 14° 21' RT
 D 3° 0'

#3A TRUSTEES OF THE DIOCESE OF VERMONT
 (A.O.B.E.) STA 56+81 - 59+91 LT
 W.D.E. 9/8/58
 RECORDED: BETHEL-BK 41-PG 400A-401-9/11/58

CONSTRUCT TURNOUT
 67+40 Rt - 70+00 Rt.

BITUMINOUS GROUTED STONE GUTTER
 58+30 Lt
 64+72 Lt

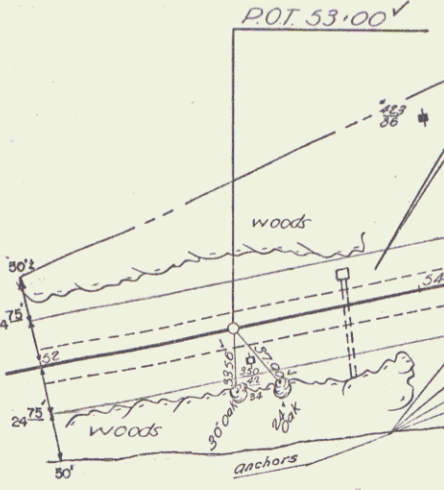

#1 GEORGE L. JR. & MILOR D. ABBOTT
 (A.O.B.E.) STA 52+00 - 57+10
 W.D.E. 9/3/58
 RECORDED: BETHEL-BK 41-PG 393-9/6/58

B.M. #11
 S11 15' WB
 RT 573.05

REV. CURVE
 Δ 15° 54' RT
 D 3° 0'
 R 1910.08
 T 266.7
 L 530.0
 E 18.5
 Bank 3/8" per FT.



Removal & Disposal of Present Guard Rail

50+80	-	62+13	Rt.
62+13	-	64+47	Rt.
64+47	-	66+81	Rt.
66+81	-	67+25	Rt.
67+25	-	67+79	Rt.
67+79	-	67+88	Rt.
67+88	-	68+18	Rt.

NOTE: R.O.W. SHOWN ON EACH SHEET IS TAKEN FROM SHEETS 7-13 OF PROJECT NO. 101M-1933

Sta. 55+35.3
 Project M101-M (1933)

Sta. 55+50.0
 Begin Project D.F. 022-1(3)

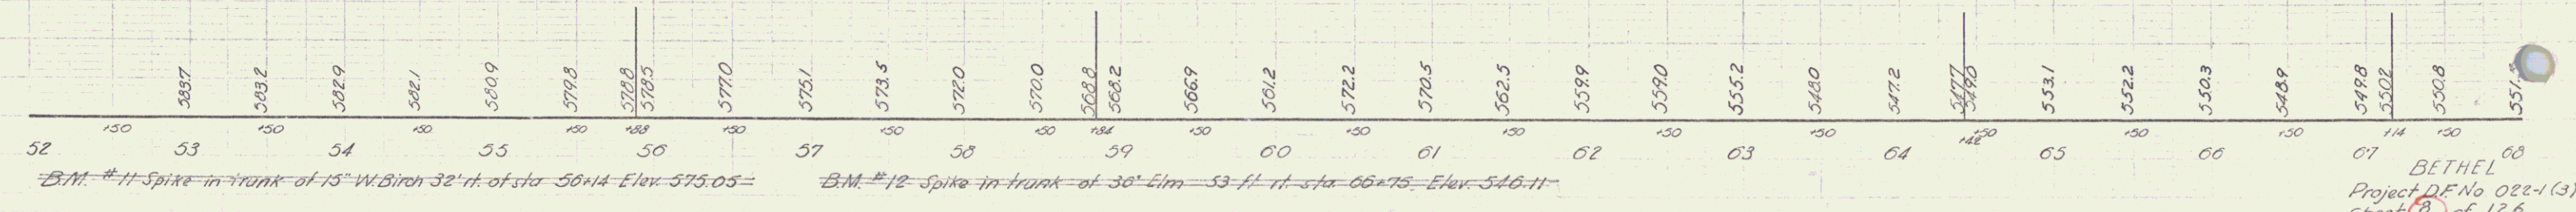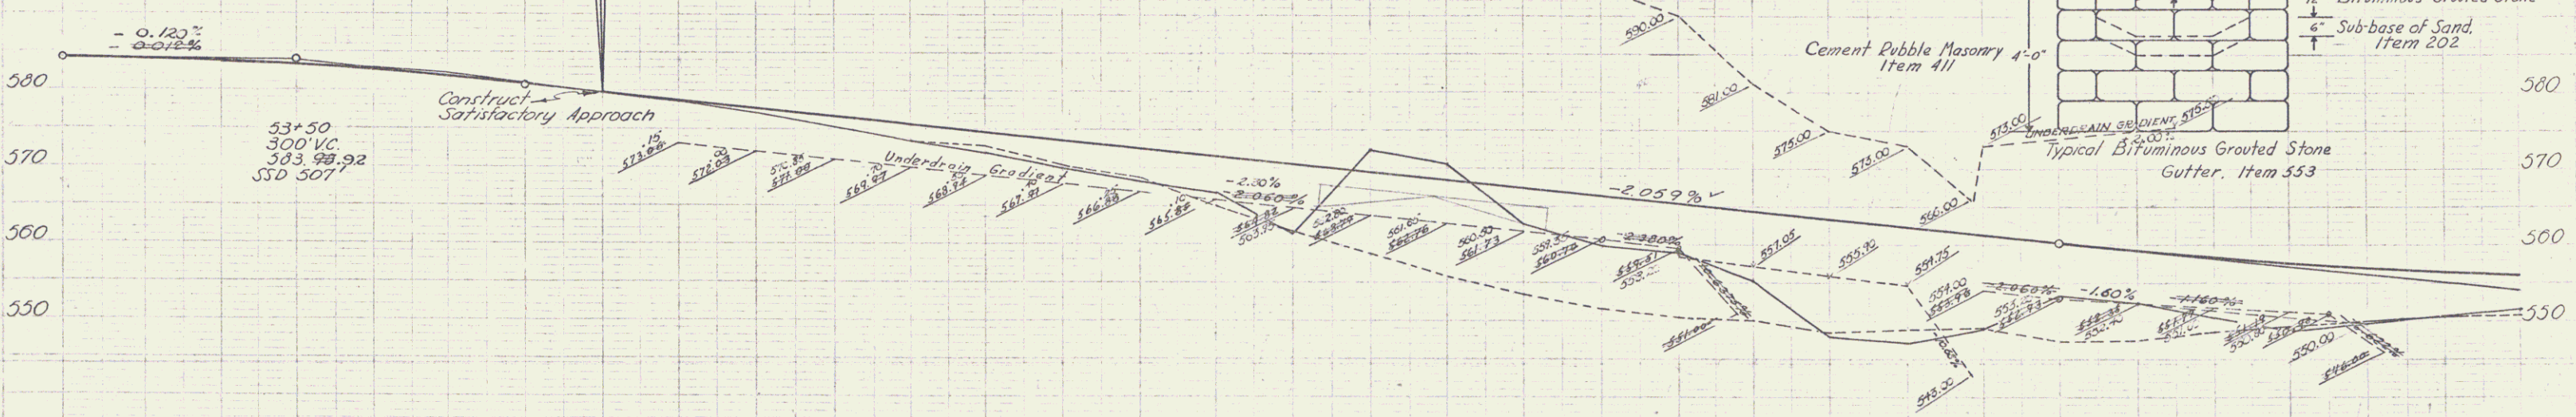

BETHEL
 Project D.F. No. 022-1(3)
 Sheet 2 of 126