


P. H. BUCKLEY
 CIVIL ENGINEER
 1000 ...
 ...
 ...


BUCKLEY

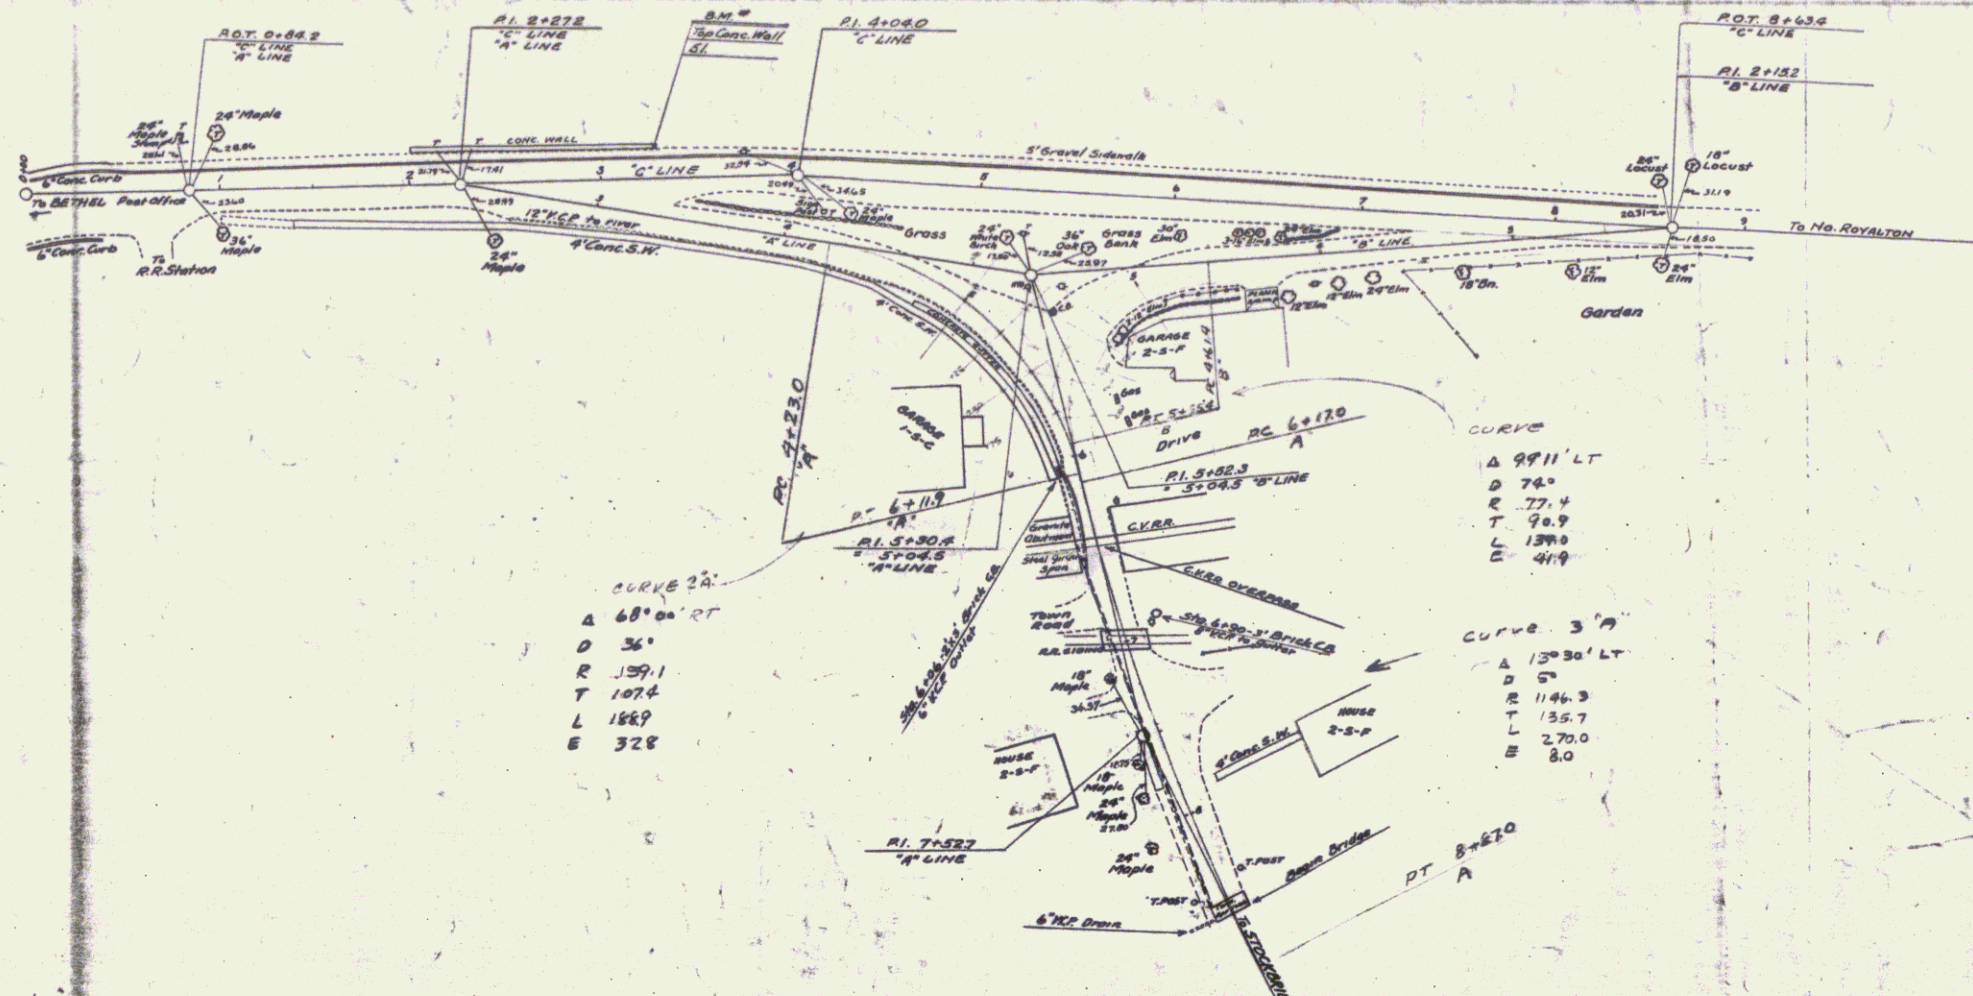

CURVE 2A
 Δ 68° 00' RT
 D 36'
 R 139.1
 T 107.4
 L 188.7
 E 328

CURVE 1
 Δ 99° 11' LT
 D 74'
 R 77.4
 T 70.7
 L 139.0
 E 41.9

CURVE 3A
 Δ 130° 30' LT
 D 5'
 R 1146.3
 T 35.7
 L 270.0
 E 8.0

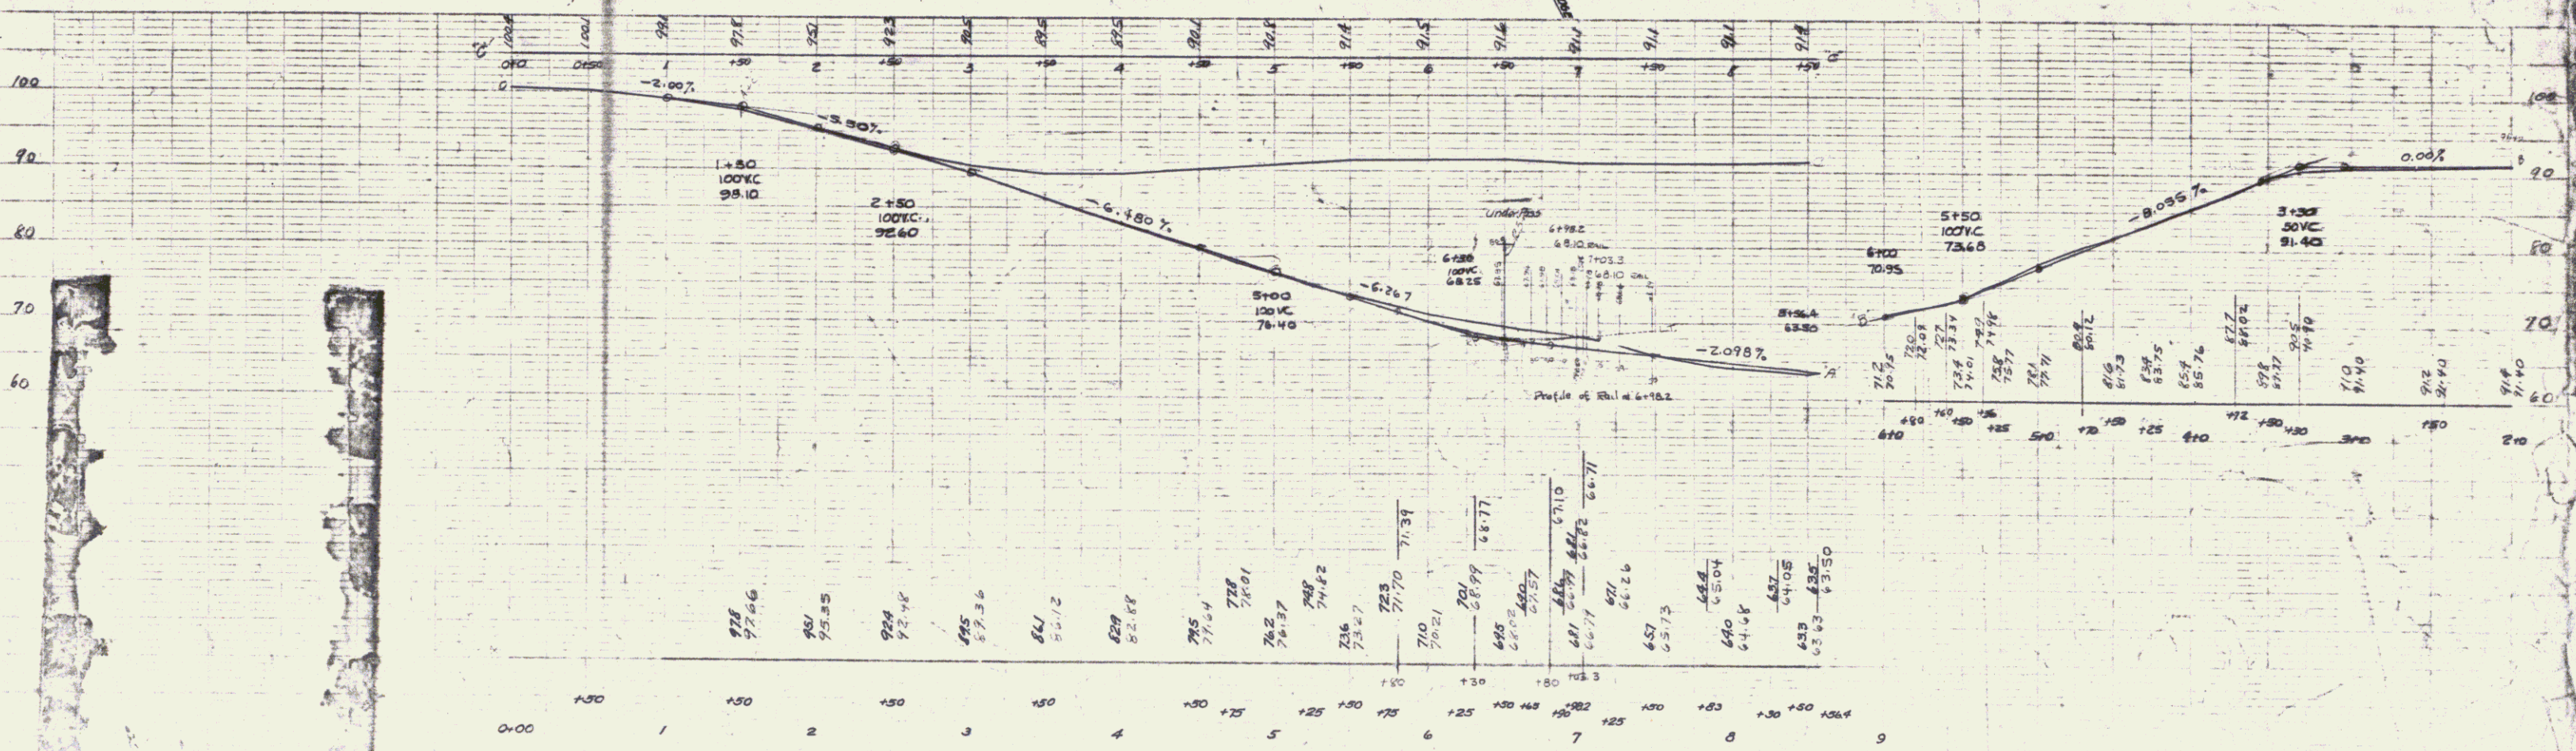

SHEET 2

2