



# DETAILS OF CONG. GRAVITY

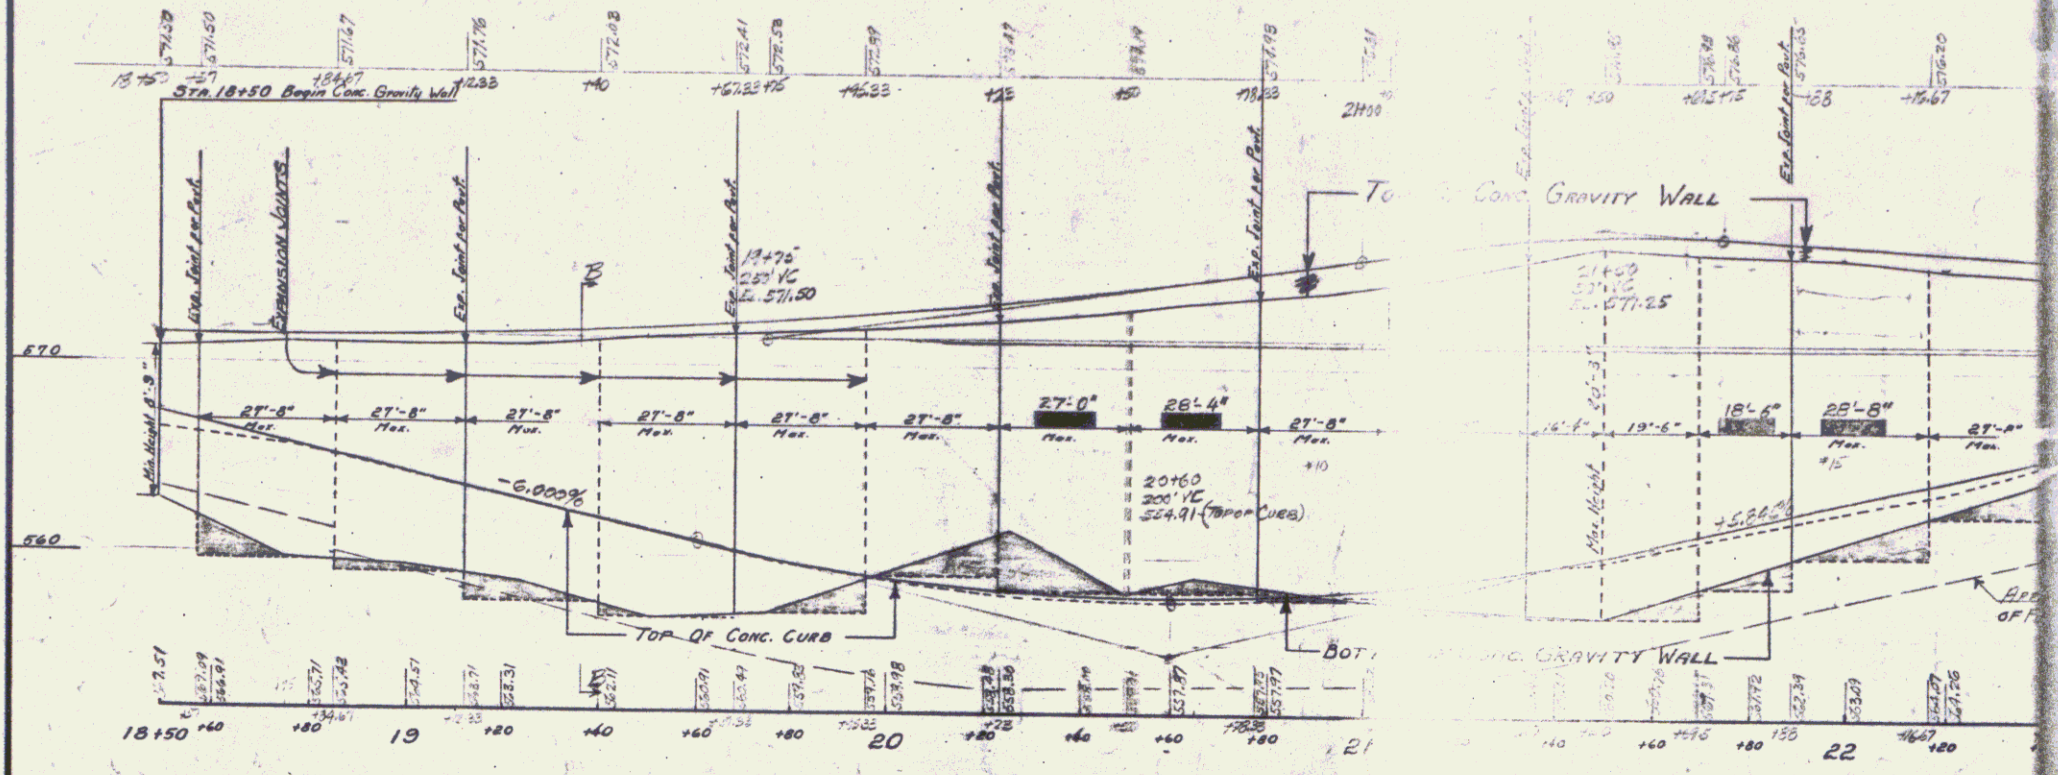


POOR ORIGINAL COPY

Alternate expansion joints designed to match road joints.  
 Above wall is to be poured in alternate sections.  
 Rock foundation to be cut in steps as shown on profile by shaded area. This area to be poured with Conc. Class C, to the true grade of bottom of wall, before main wall is constructed.

Weep holes in Conc. Retaining Wall to consist of 4" pipe with a slope of 1/8" per ft, and spaced 1'bt apart from centers. Weep holes to be included in bid price per Conc. Class C.

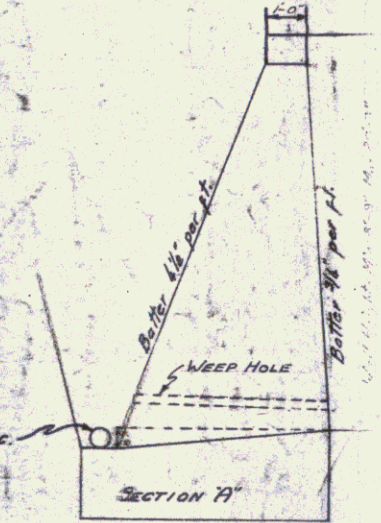

Section A-A to be poured to match bottom of wall on grade before the retaining wall is poured.

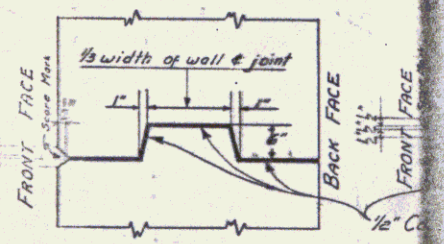

DETAIL No. 1  
 Detail No. 1 to apply from bottom 6 ft. down from top of wing. Do not use from this point to top of wall.

DETAIL OF VERTICAL EX