


STA	CV	FT
23+50	573.84	112
24+00	573.84	112

FRAG
101-D(1) 1939 6 43

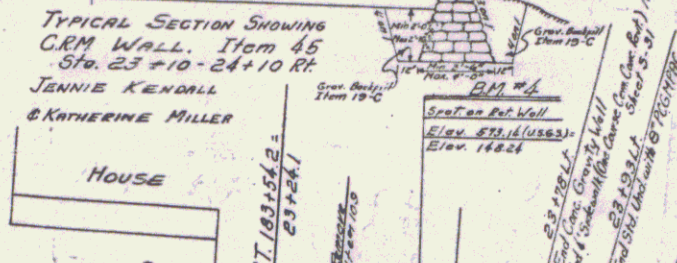

Ramp or Curb to be constructed of Macadam from end of project to end of lot 142 on right. This construction for the purpose of preventing surface water from entering upon the lower part grounds of the owner, and to lead said water to the concrete gutter constructed as part of the project.

NOTE: CRM Wall (Item 45)
Use of field stone in concrete masonry wall construction will not be permitted.

STA	CV	FT
570	570.00	112
560	560.00	112
550	550.00	112
0	0.00	112
-10	-10.00	112
-20	-20.00	112
-30	-30.00	112
-1000	-1000.00	112