


| PARCEL | INSTRUMENT | DATE | GRANTOR | GRANTEE | RECORDED | REMARKS |
|--------|------------|----------|--------------------|-----------|-----------------|---------|
| B/C | WD | 10-16-39 | IDA C. NOBLE ET AL | ST OF VT | BOOK PAGE DATE | |
| A | QCD | 10-17-39 | LIZZIE GEORGE | ST OF VT. | 37 110 10-19-39 | |
| D | QCD | 10-17-39 | WILLIAM R. BRIGGS | ST OF VT. | 37 112 10-19-39 | |

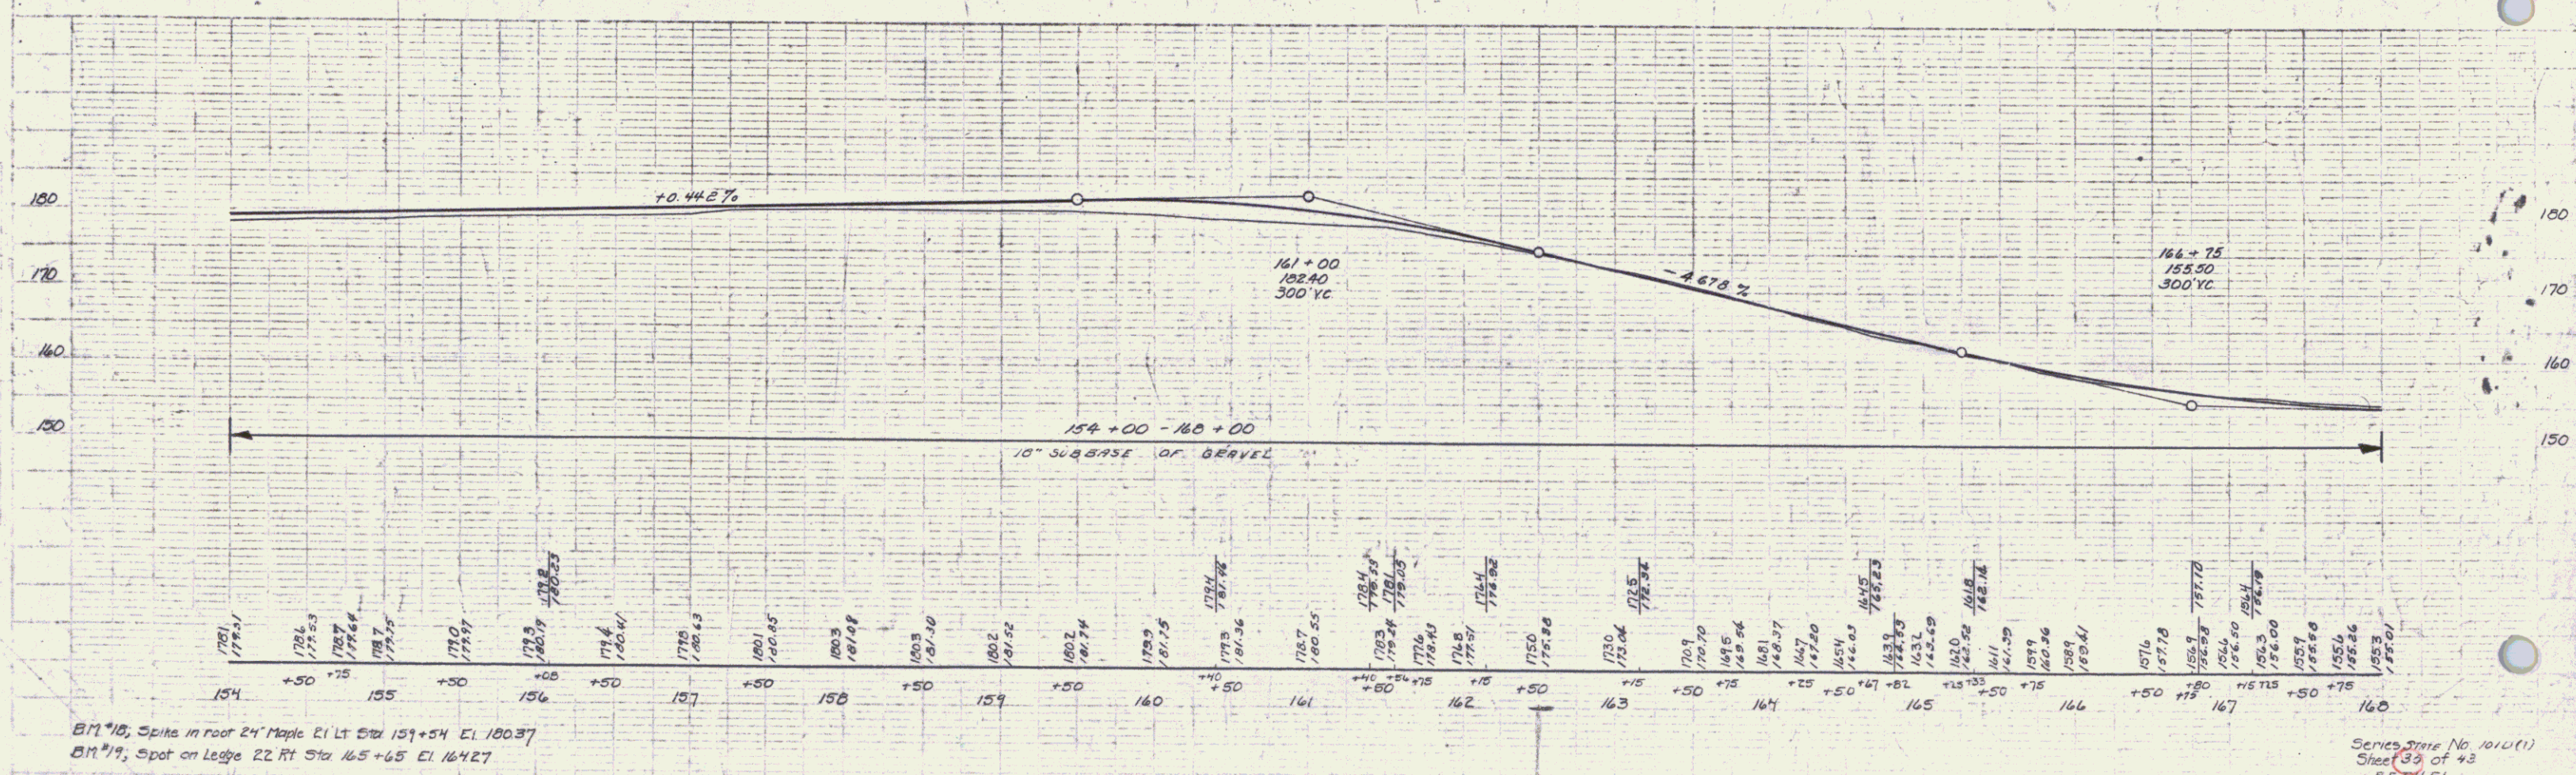

BM #10, Spike in roof 24 Maple El Lt Sta 151+34 El. 100.37
 BM #9, Spot on ledge 22 Rt Sta 165+65 El. 164.27

Series State No. 1010(1)
 Sheet 35 of 43
 BETHEL