


(To Be Returned To H.O.W. Division)


Perpetual
MOWN FILE
RIGHT-OF-WAY DIVISION

C.F. PLANTING
C.F. PLANTING
THINLED

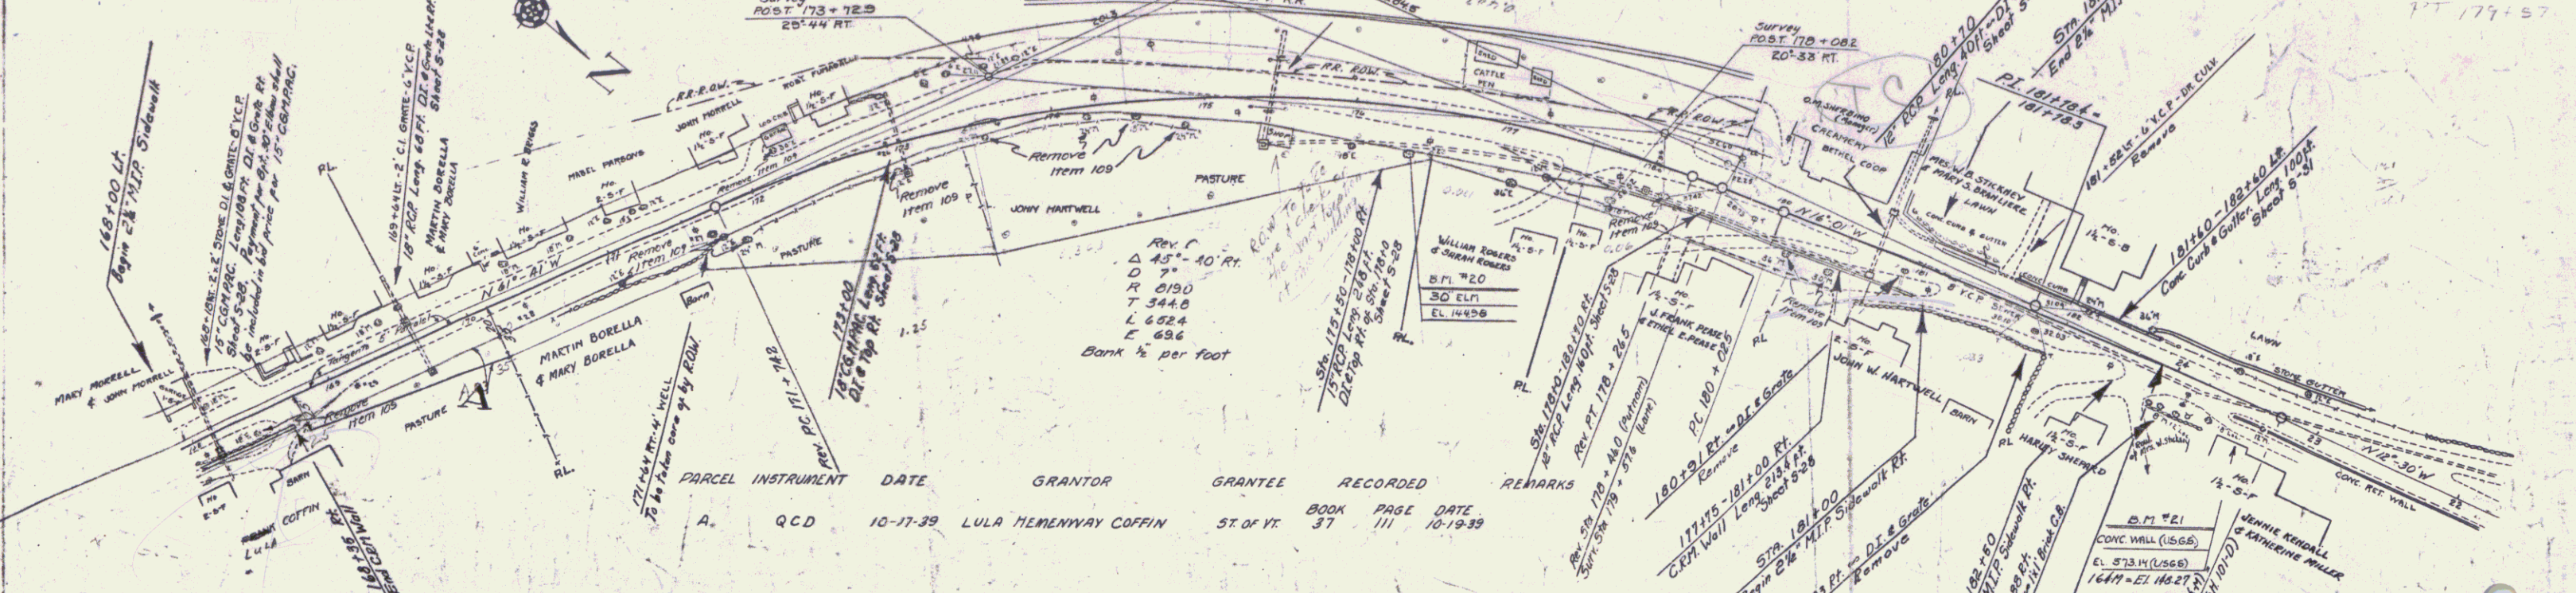

PARCEL	INSTRUMENT	DATE	GRANTOR	GRANTEE	RECORDED	REMARKS
A.	QCD	10-17-39	LULA MEMENWAY COFFIN	ST. OF VT.	37 111	10-19-39

PROPOSED PROFILE OF SIDE DRAIN

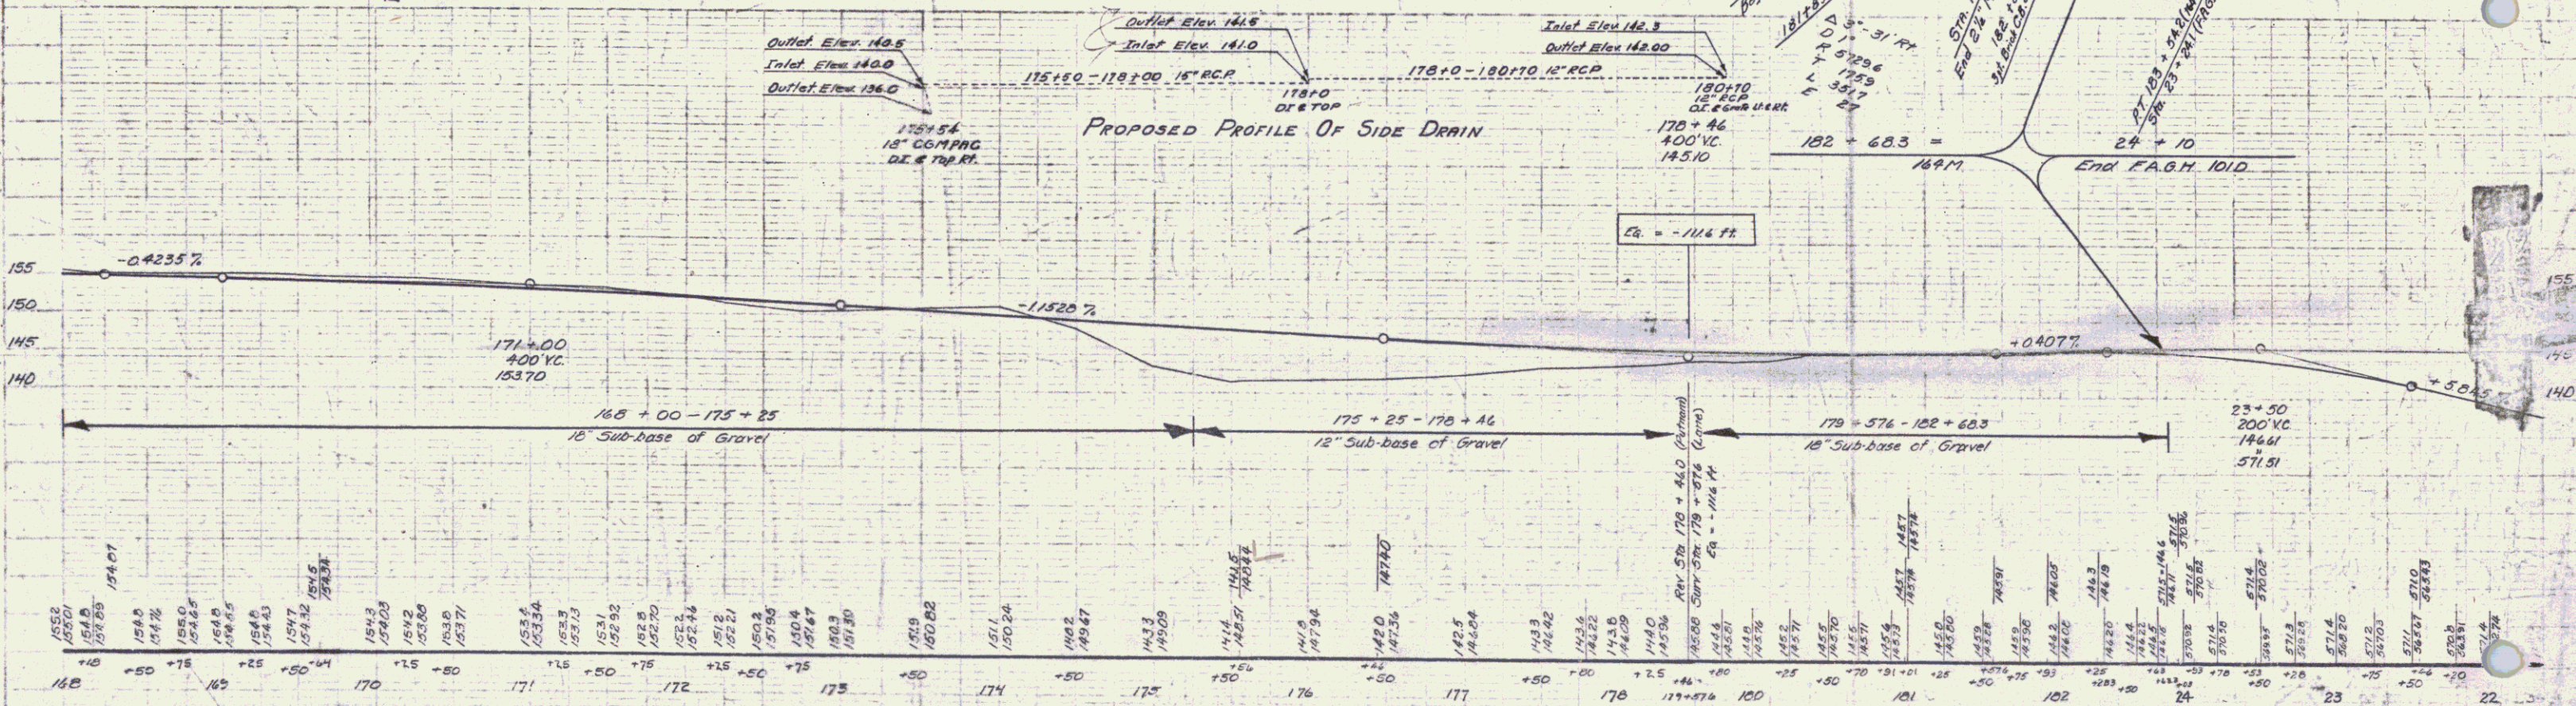

BM #20, Spire in Root 30' Chim, 42 Rt Sta. 176+44 - Elev 144.98
 BM #21, Spot on Conc. Wall, 12 Rt Sta. 182+33 = B.M. #4, 1934 Survey, U.S.G.S. Datum Elev 573.14 = 148.27 of 164.7.