


Project	
Date	
Scale	
Author	
Checked	
Approved	

Station	
Notes	
Remarks	

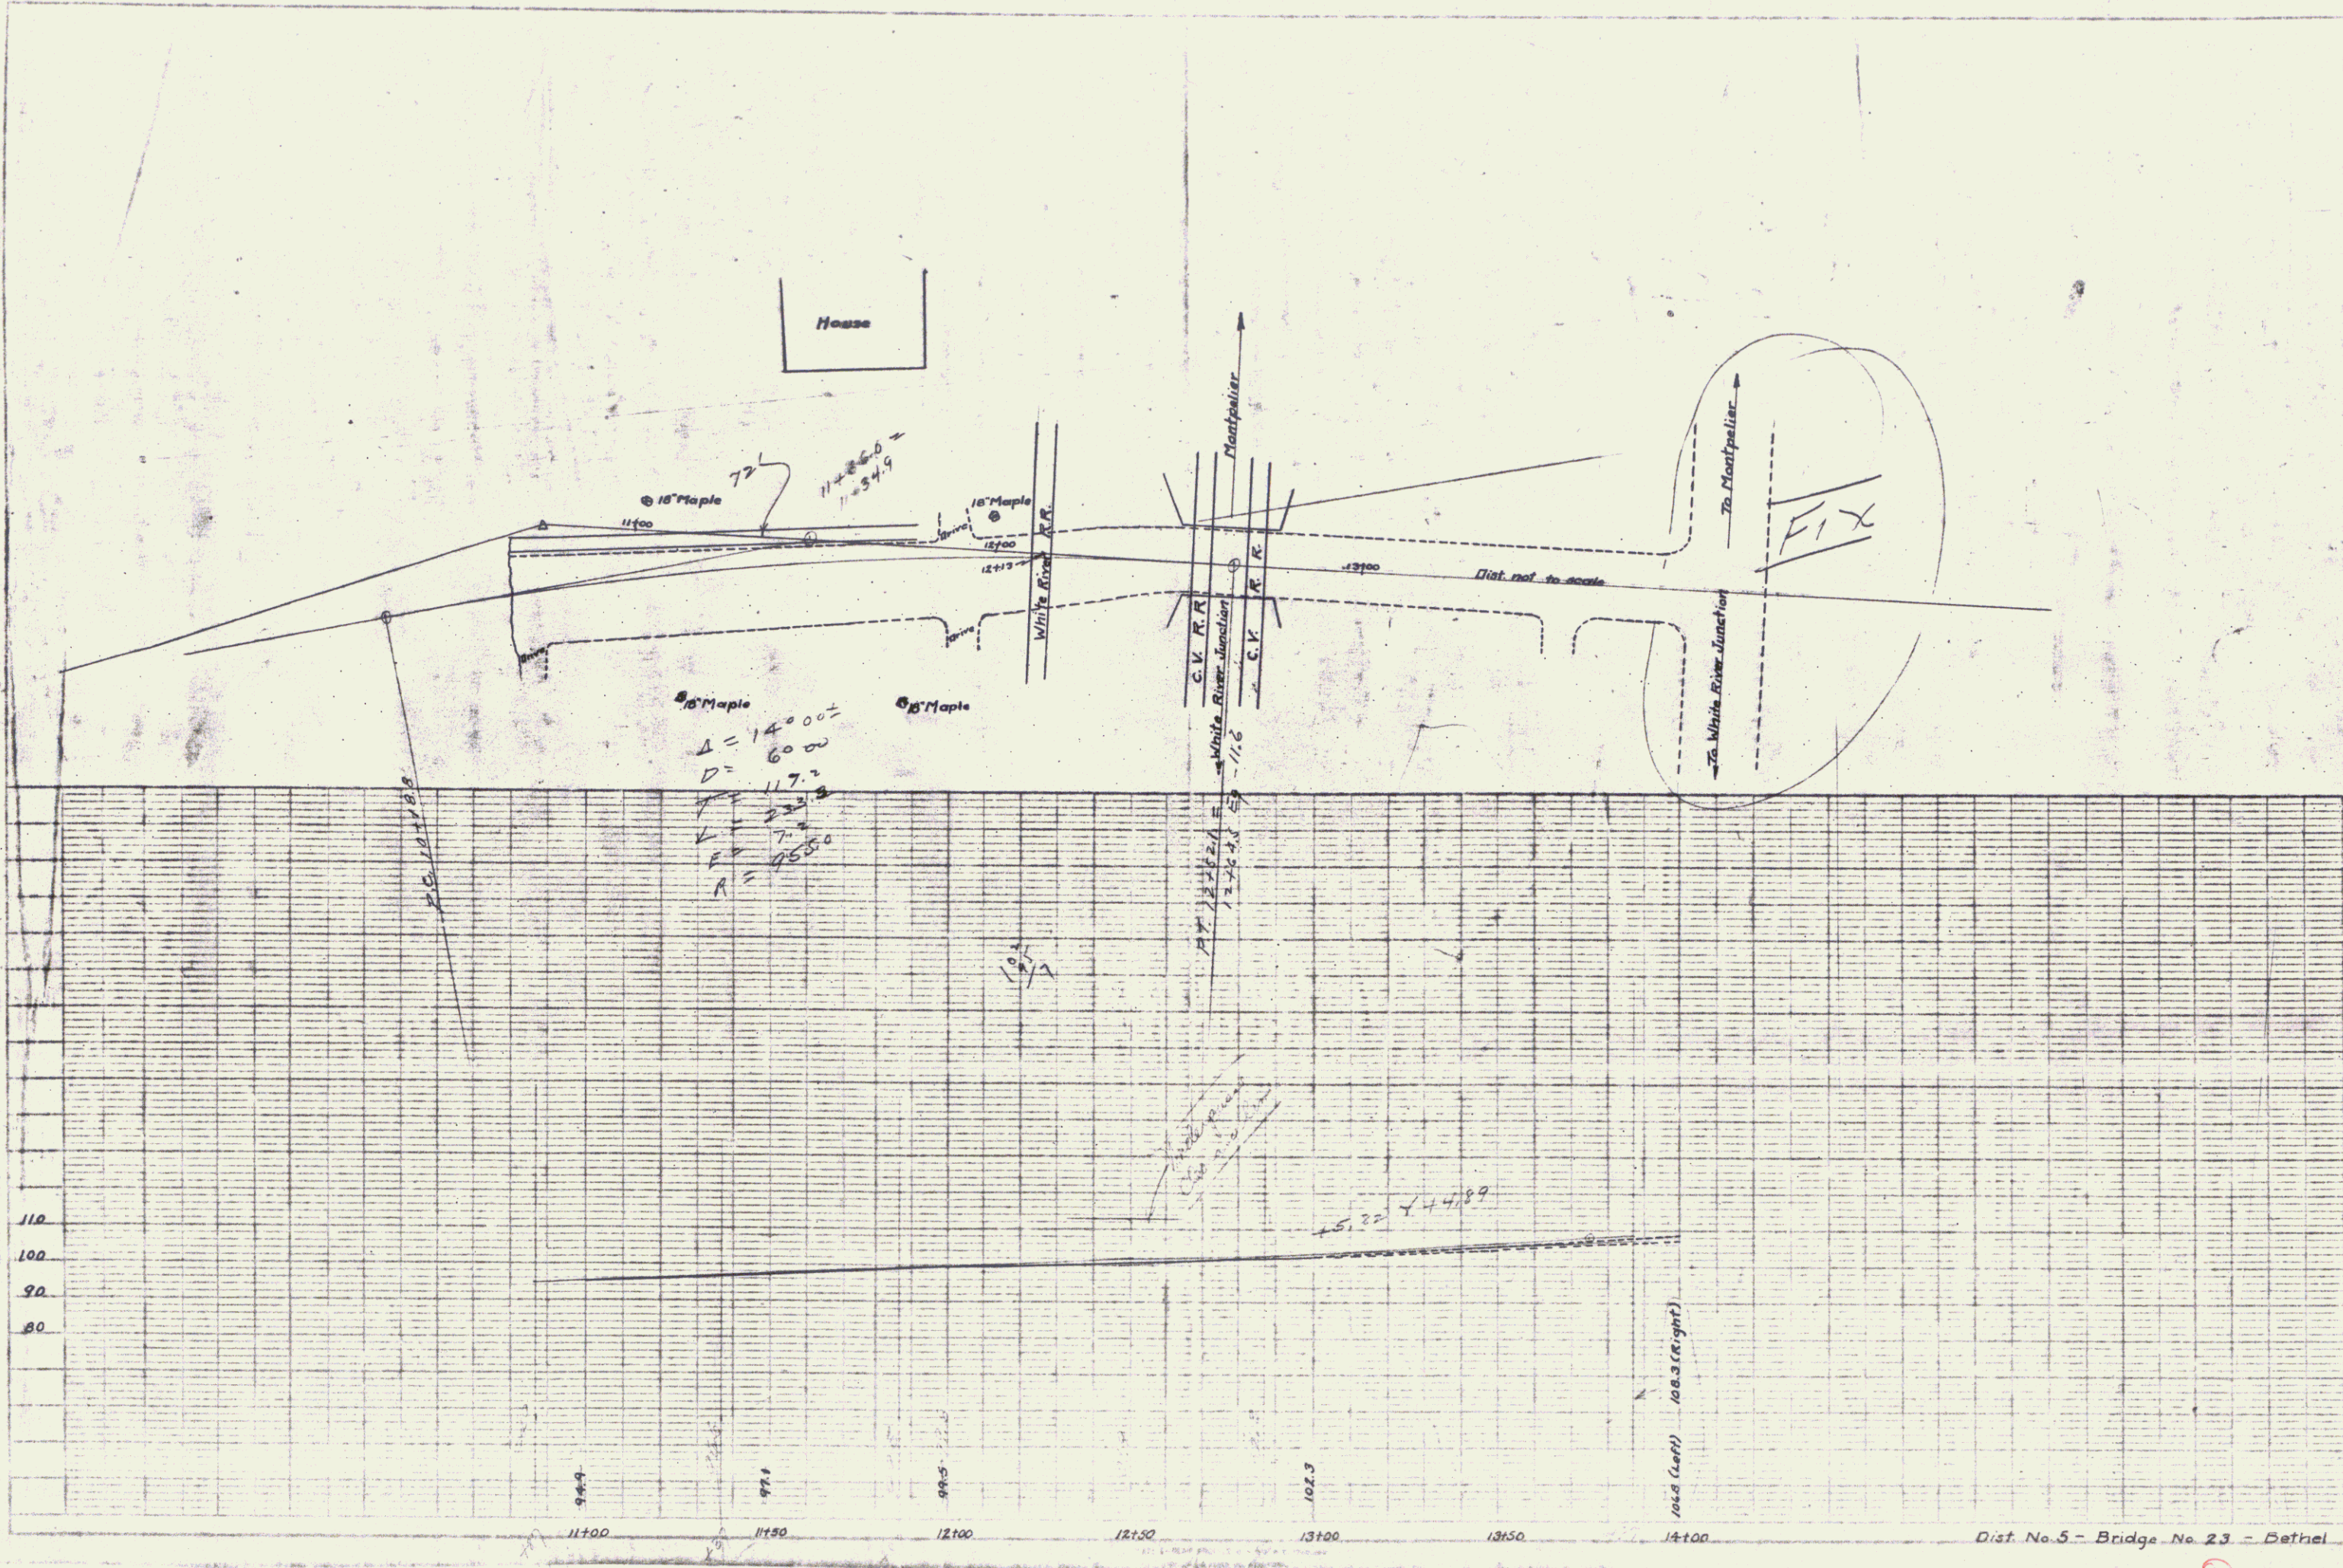

Dist. No. 5 - Bridge No. 23 - Bethel

Sheet No. 3

16