


59-63 Cross Sections
5-A-62A Final Earthwork

LENGTH OF PROJECT ~~4929.33~~^{4917.33} FEET = ~~0.931~~^{0.931} MILE

ASPHALT CEMENT - ATLANTIC - ALBANY, N.Y.

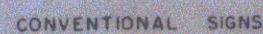

HOVALTON F 342-1115
CONTRACTOR - ROGERS CONSTRUCTION CO.
BRATTLEBORO, VT

PROJECT	ROYALTON
NUMBER	F 022-115)
DATE	SEPTEMBER 30, 1961
TYPE BITUMINOUS CONCRETE PAVEMENT	
CONTRACTOR	ROGERS CONSTRUCTION CO.
	BRATTLEBORO, VT
LOCATION	Year 1969 beginning at a Point 1.551 miles easterly of the Royalton-Bathel town line and extending westerly .0331 miles.

Royalton - Bethel town line and extending westerly 0.931 miles.

200 400
SCALE IN FEET

THESE PLANS ARE SUBJECT TO SUCH REVISIONS AS MAY BE REQUIRED BY THE BUREAU OF PUBLIC ROADS OR THE COMMISSIONER OF HIGHWAYS.

CONSTRUCTION IS TO BE CARRIED ON IN ACCORDANCE WITH THESE PLANS AND THE STANDARD SPECIFICATIONS FOR HIGHWAY AND BRIDGE CONSTRUCTION DATED APRIL 1964 AS APPROVED BY THE BUREAU OF PUBLIC ROADS ON OCTOBER 12, 1964, INCLUDING ALL SUBSEQUENT APPROVED REVISIONS AND SUCH REVISED SPECIFICATIONS AND SPECIAL PROVISIONS AS ARE INCORPORATED IN THESE PLANS.

DEPARTMENT OF TRANSPORTATION
BUREAU OF PUBLIC ROADS
Pin # 00R017

APPROVED

DIVISION ENGINEER DATE

PROJECT F NO. 022-1 (5)

SHEET 1 OF 63 SHEETS