
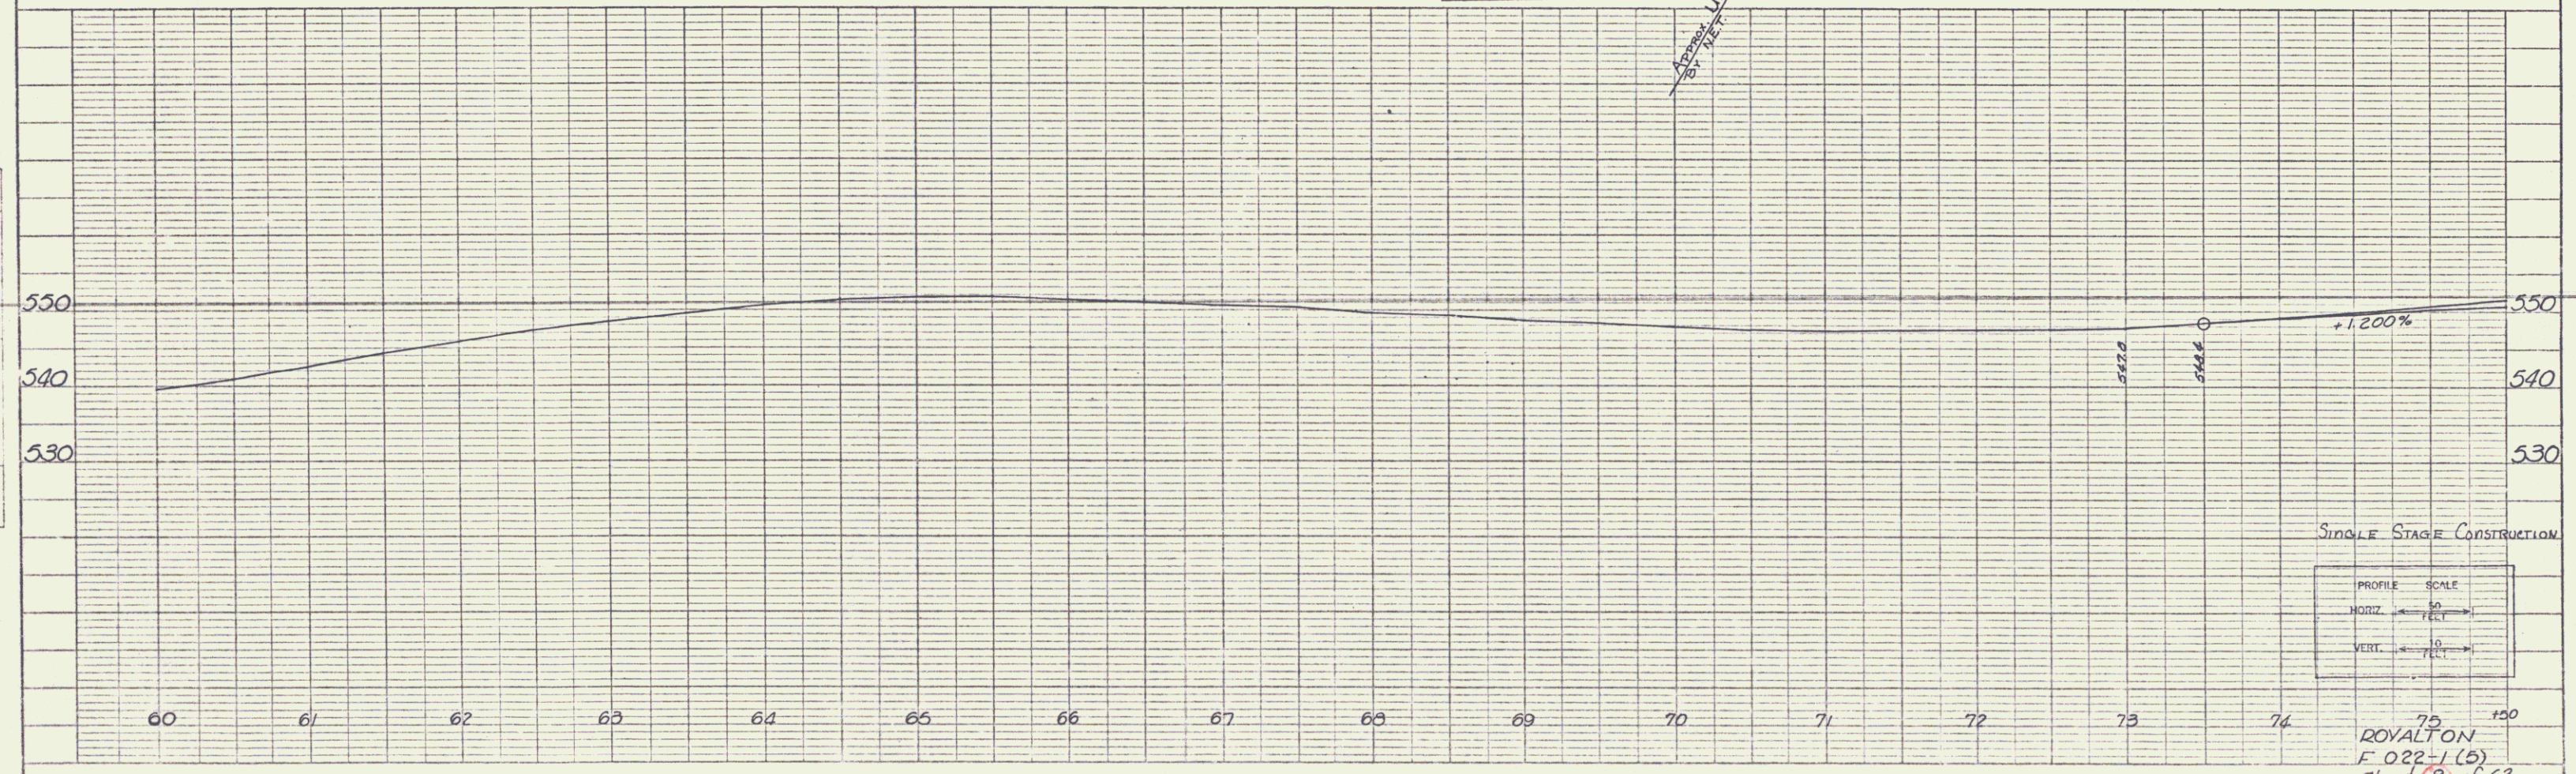


DATE 9/66  
 DRAWN BY Spaulding  
 CHECKED BY RWL  
 TRACED  
 NO. 7/66

DATE  
 DRAWN BY  
 CHECKED BY  
 TRACED  
 NO.

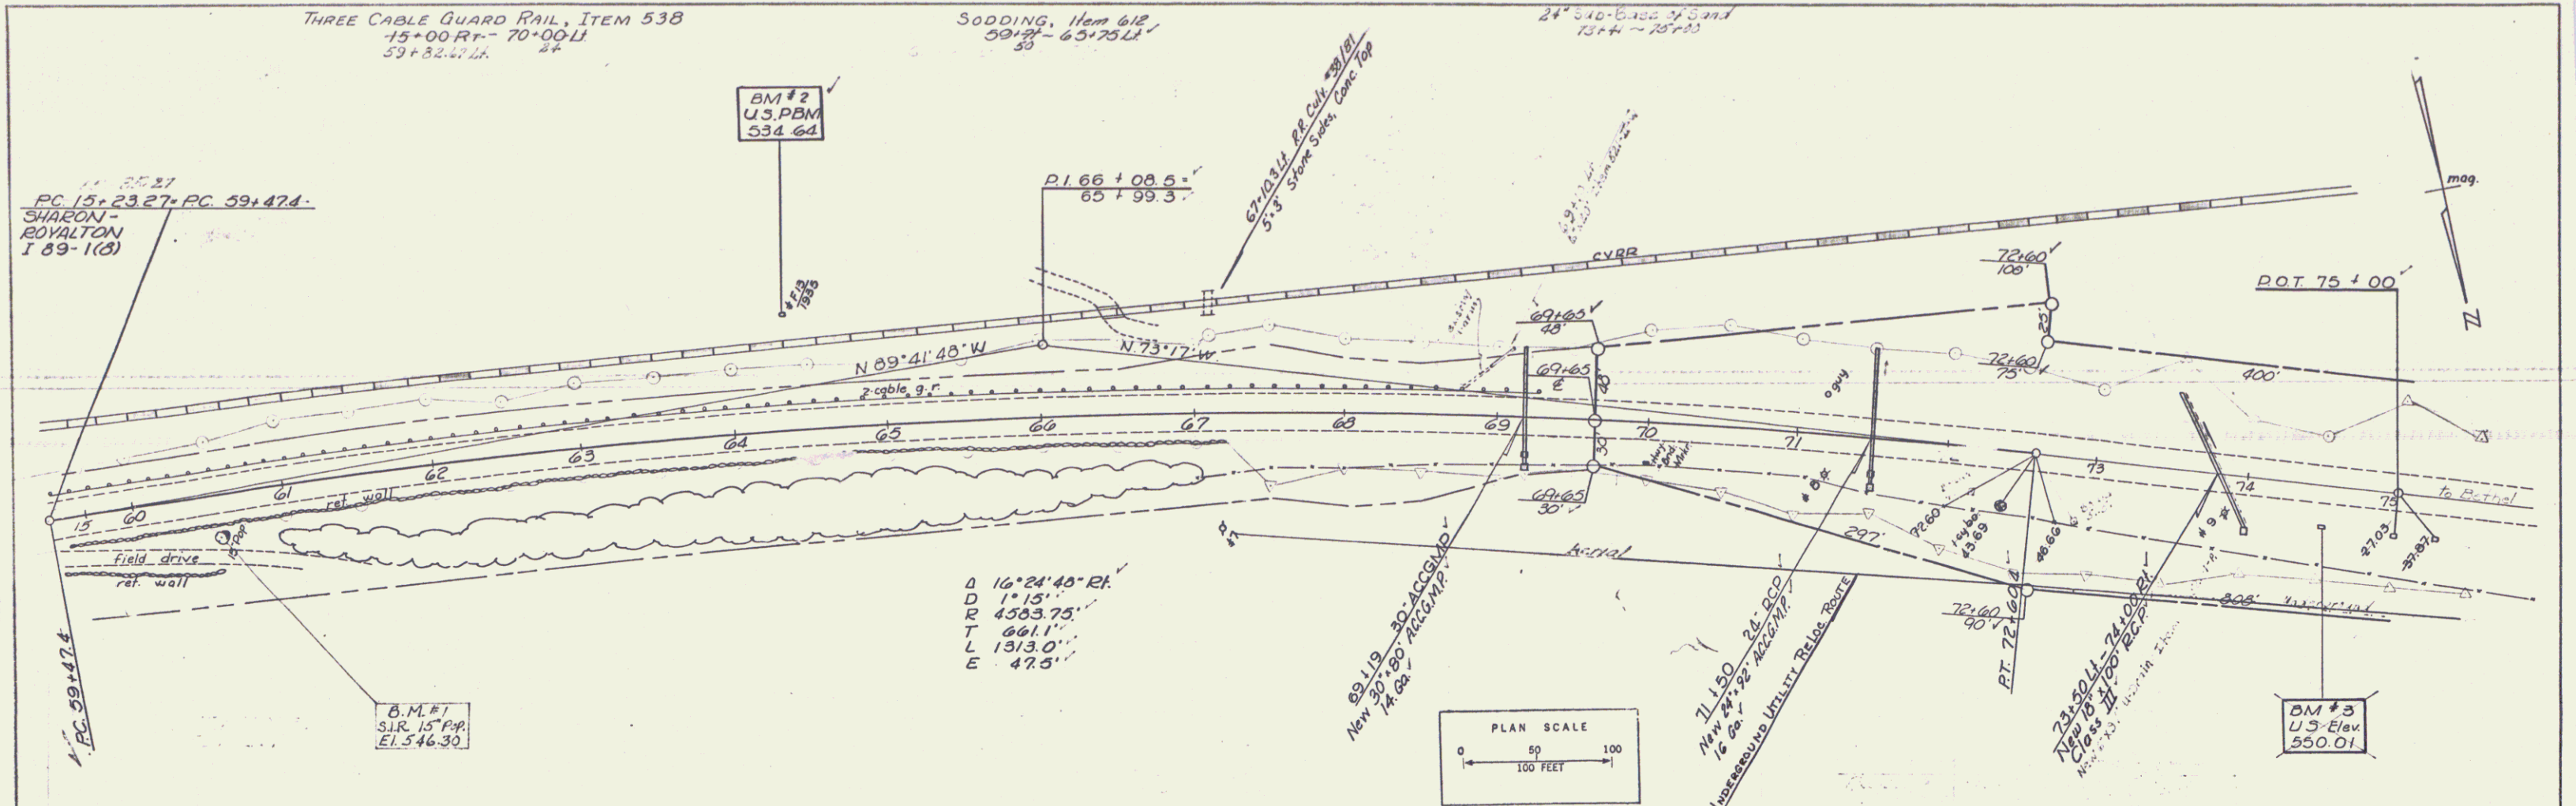

SINGLE STAGE CONSTRUCTION

PROFILE SCALE  
 HORIZ. 1" = 50'  
 VERT. 1" = 10'

75  
 ROYALTON  
 F. 022-1(5)  
 Sheet (B) of 63