
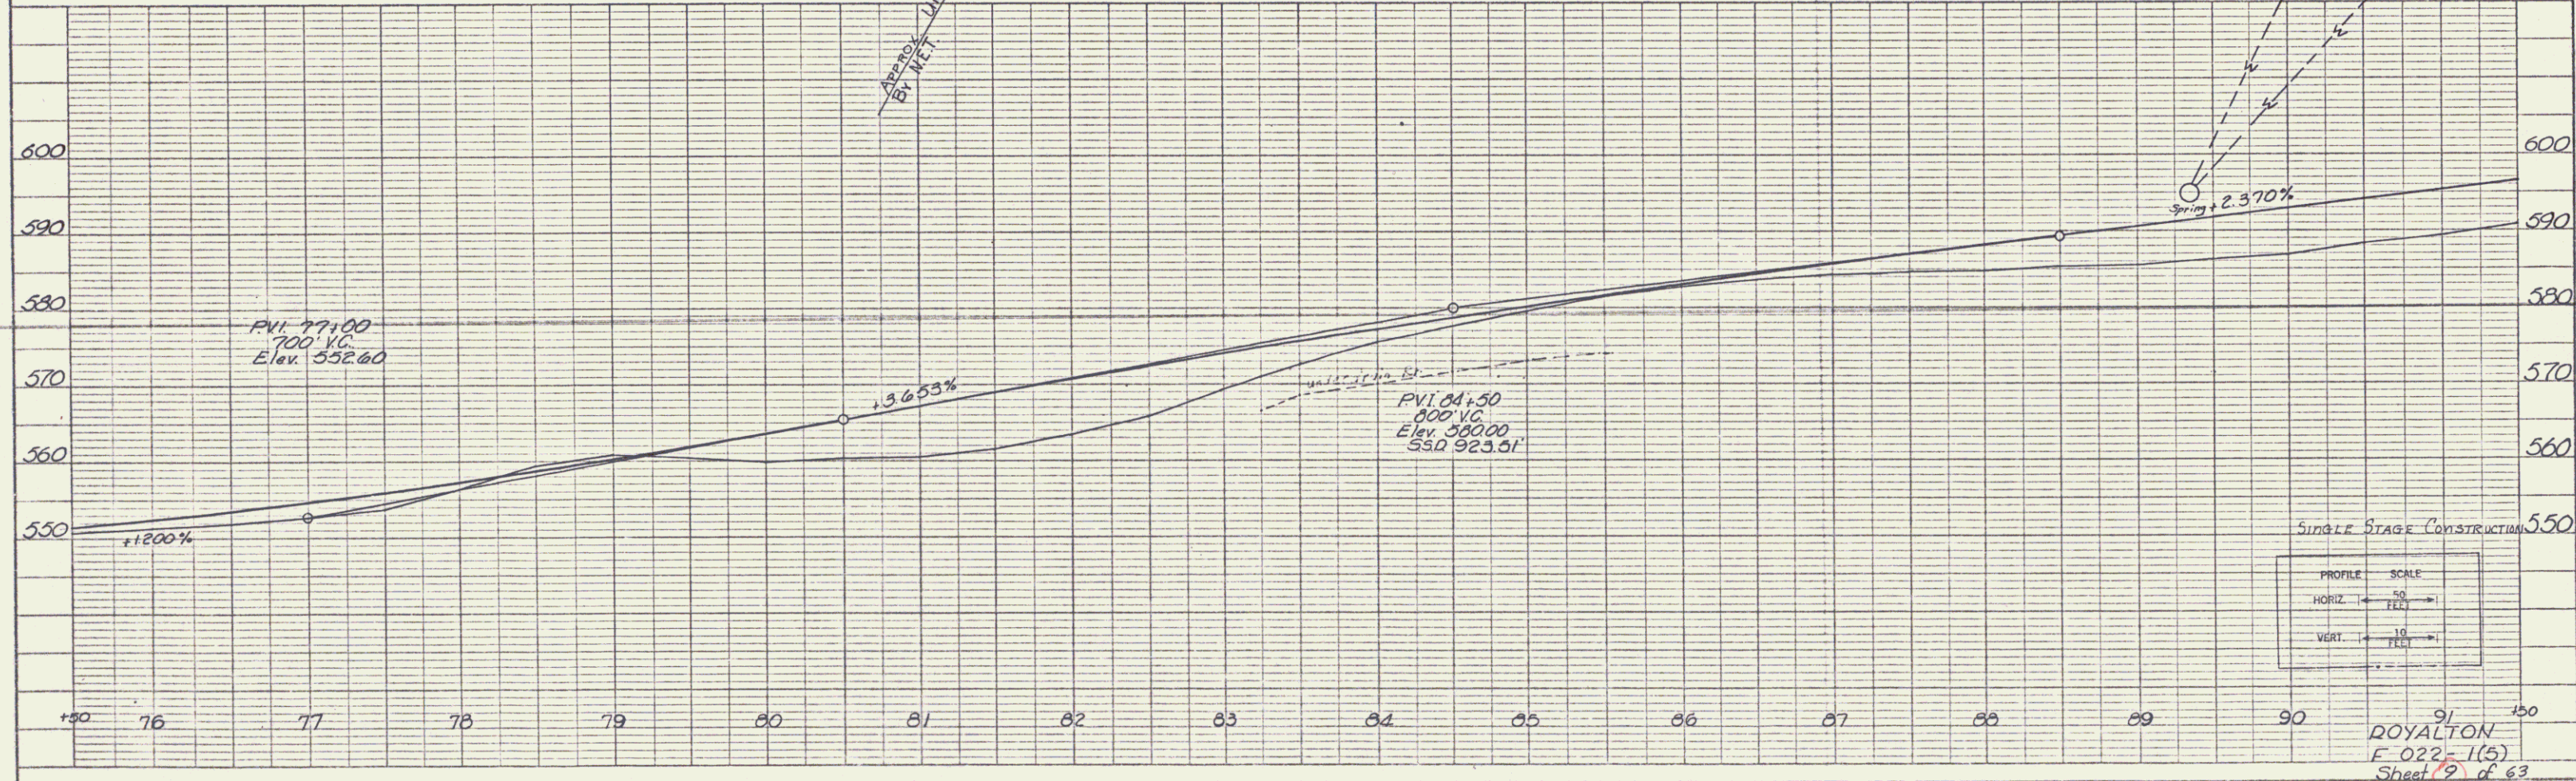


PLAN
 DATE: 9/88
 DRAWN BY: P.W.
 CHECKED BY: [Signature]
 PROJECT: [Signature]
 NO. 10420

PROFILE
 DATE: [Blank]
 DRAWN BY: [Blank]
 CHECKED BY: [Blank]
 PROJECT: [Blank]
 NO. [Blank]

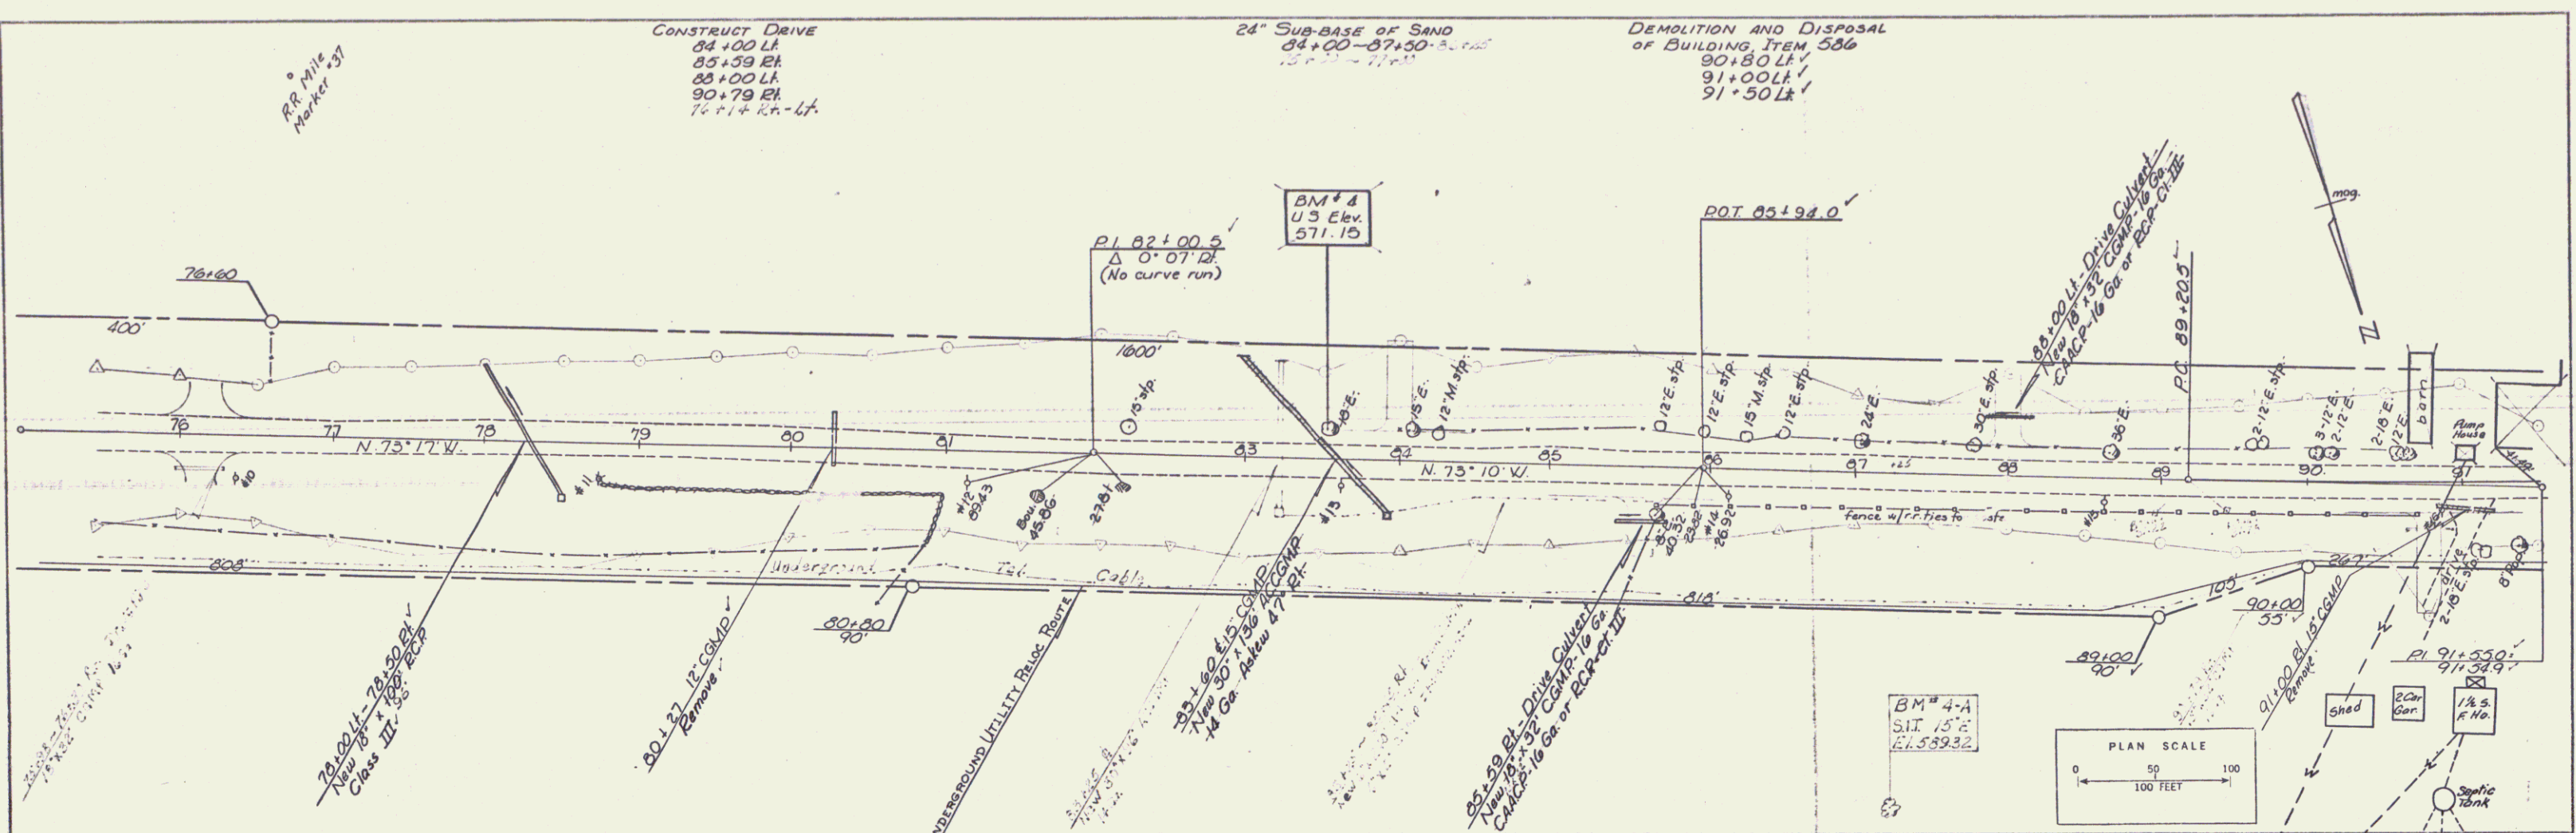

SINGLE STAGE CONSTRUCTION
 PROFILE SCALE
 HORIZ. 50 FEET
 VERT. 10 FEET

ROYALTON
 F 022-1(5)
 Sheet 2 of 63