
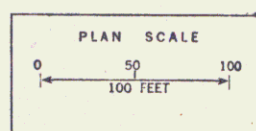


PLAN
 DRAWN BY: [blank]
 CHECKED BY: [blank]
 DATE: [blank]
 NO. [blank]

PROFILE
 DRAWN BY: [blank]
 CHECKED BY: [blank]
 DATE: [blank]
 NO. [blank]

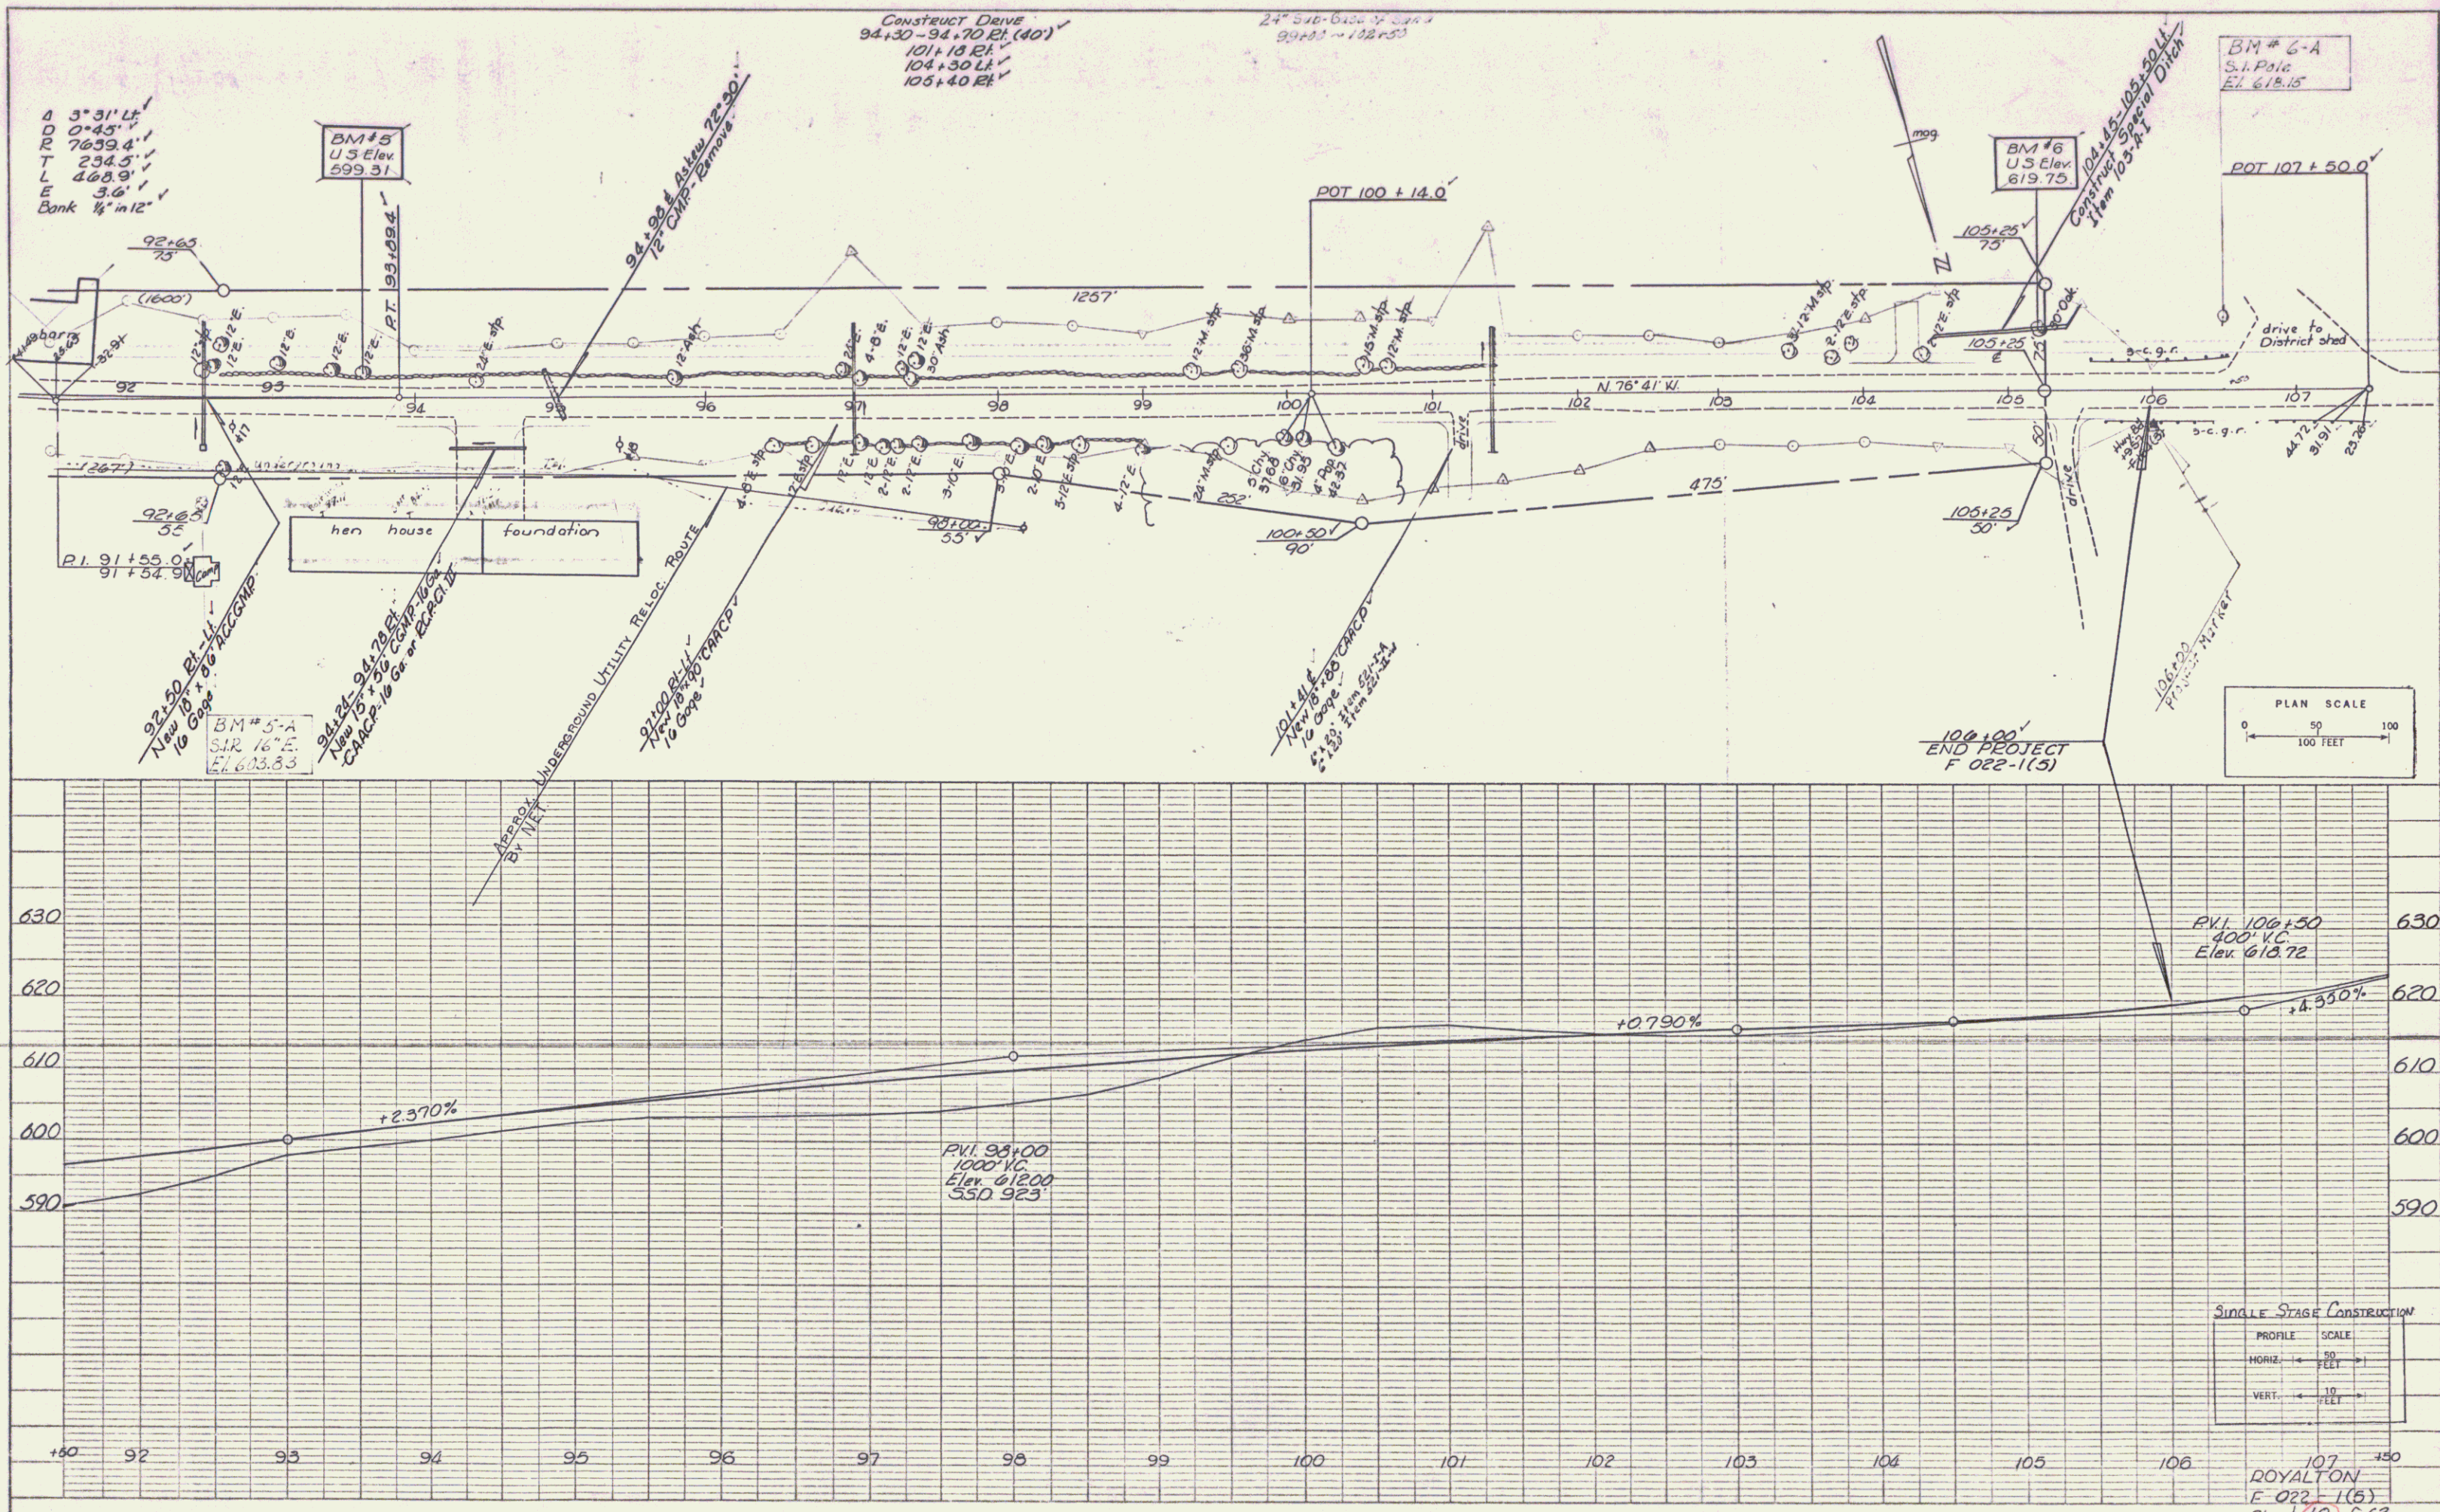

SINGLE STAGE CONSTRUCTION
 PROFILE SCALE: 1" = 10 FEET
 HORIZ. SCALE: 1" = 10 FEET
 VERT. SCALE: 1" = 10 FEET

ROYALTON
 E 022-1(5)
 Sheet 10 of 63