


PARCEL	INSTRUMENT	DATE	GRANTOR	GRANTEE	RECORDED	REMARKS
A	W.D.	1-19-38	DELLA HOLT	STOFVT	800K	SAGE DATE JUL 37A
A'	W.D.	1-18-38	GEO. PIETTE & ANNA SEYMOUR	"	7 375	1-21-38 - 58 21400
					7 380-391	1-21-38 - 20 25180 70 38150

PROJ. NO.	STATE	F.A.G.M.	FISCAL YEAR	SHEET NO.	TOTAL SHEETS
162A	VT	1938	5	4.6	

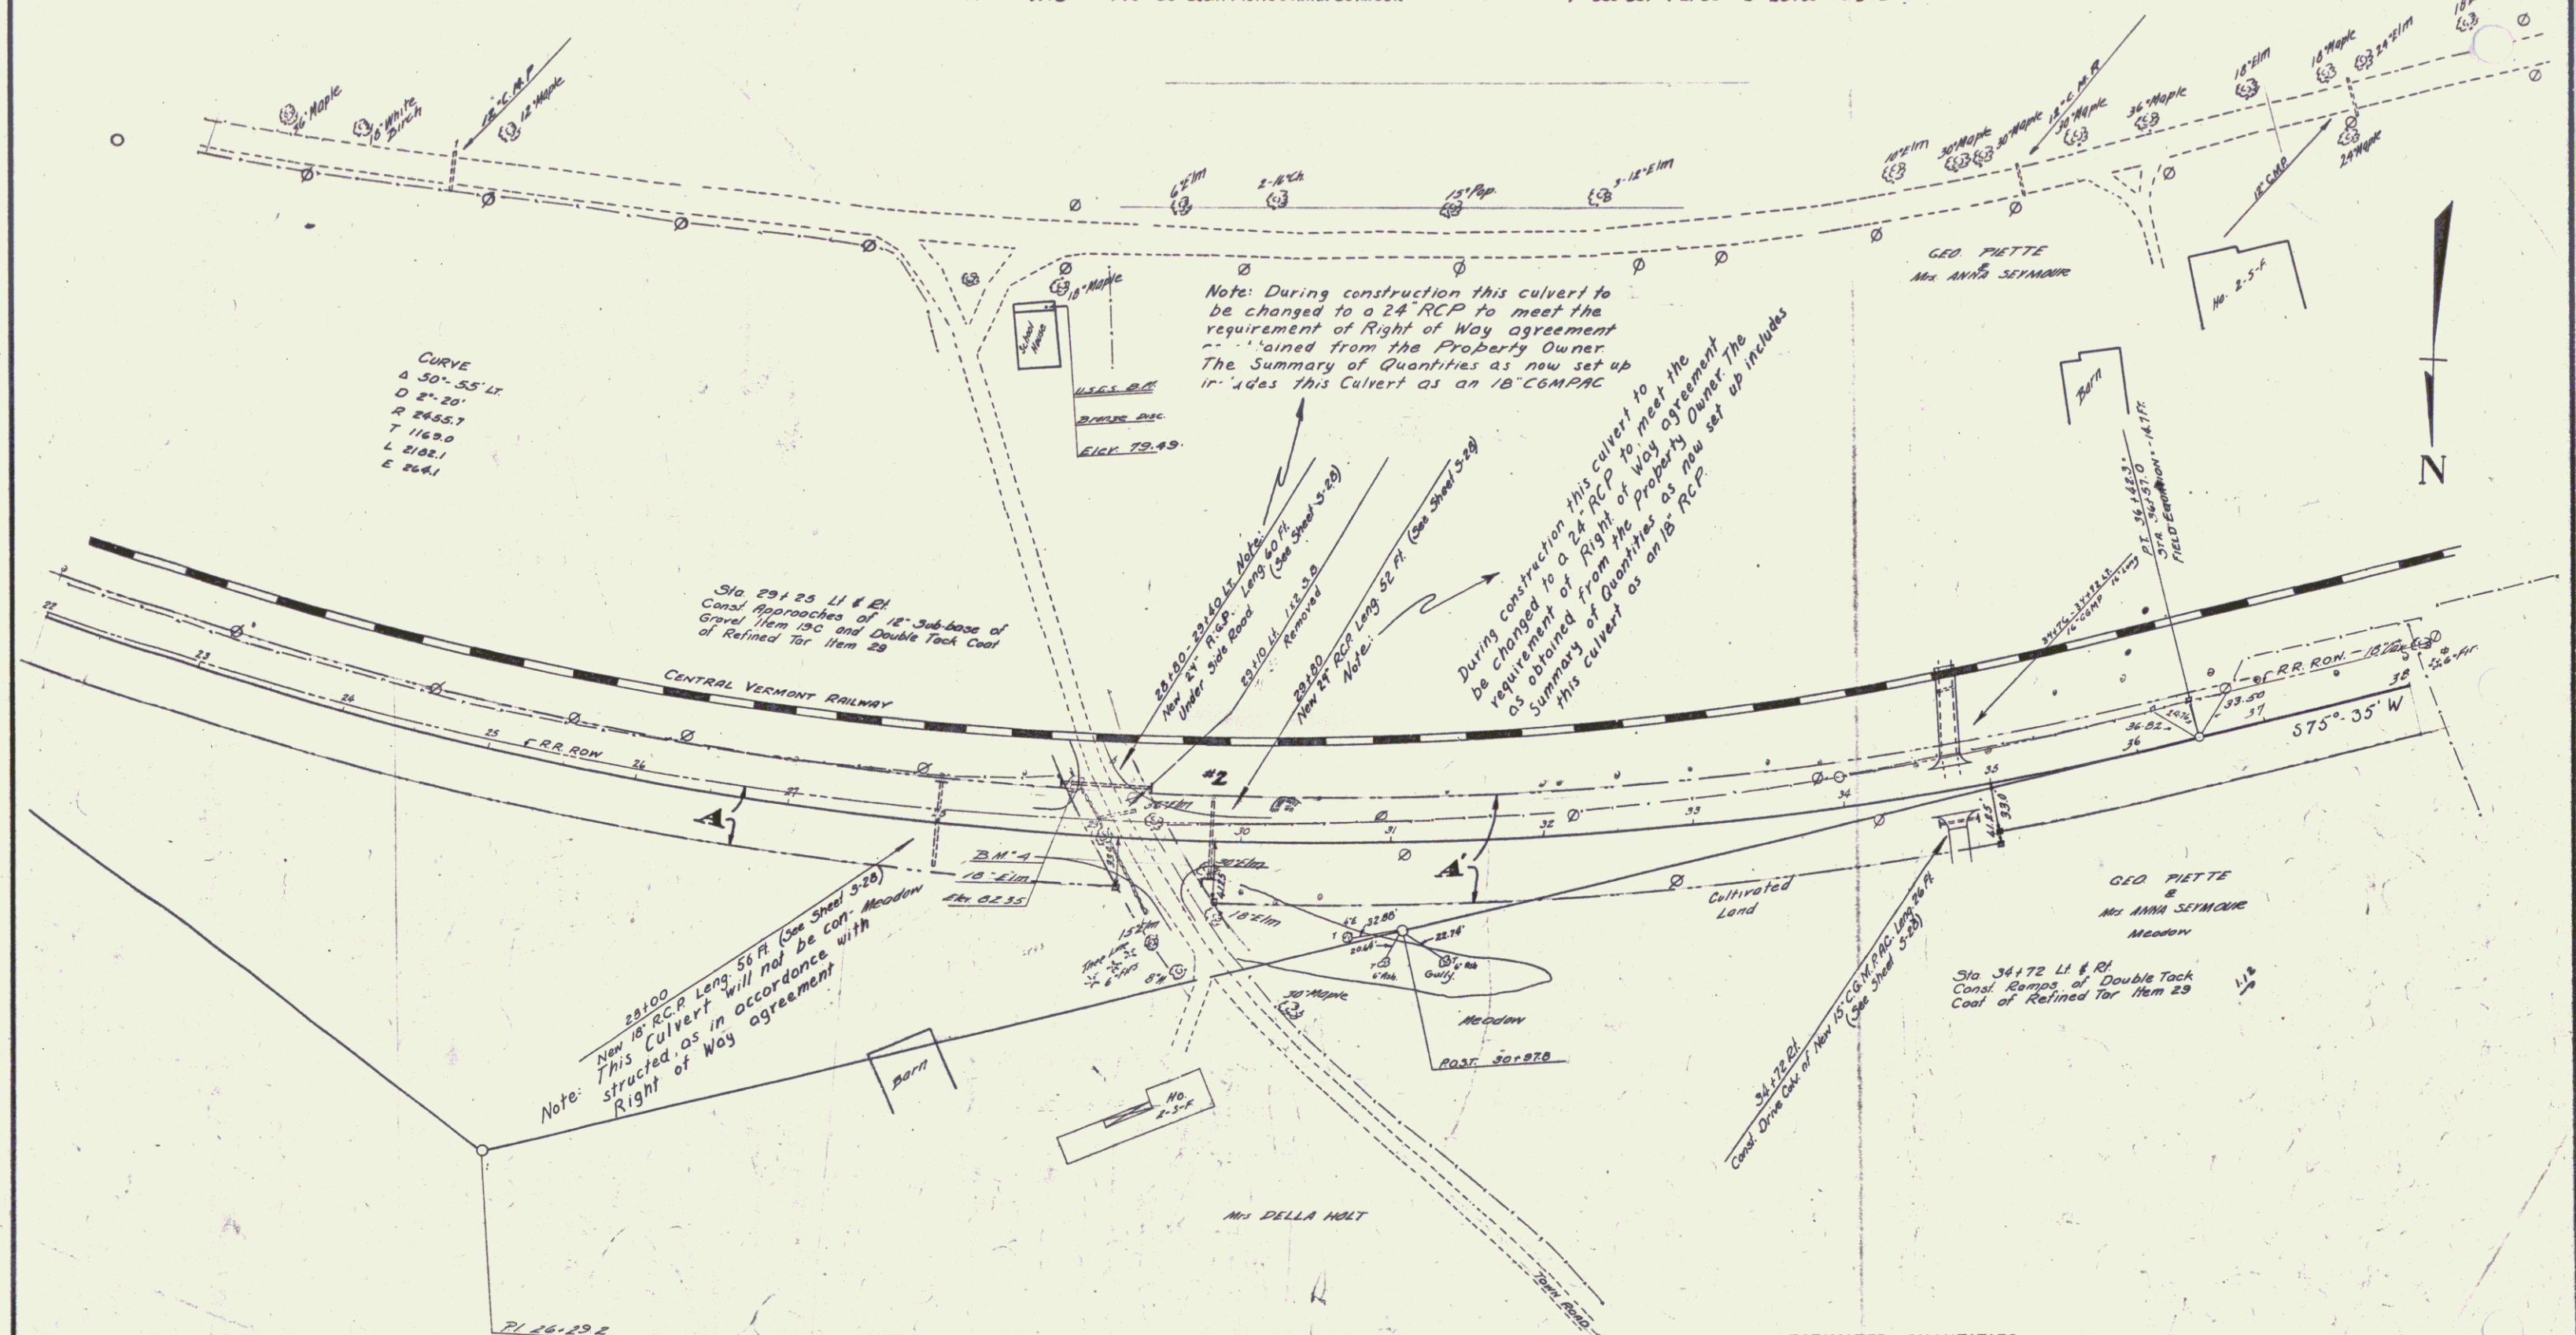

ESTIMATED QUANTITIES

Surveyed by
 Designed by
 Drawn by
 Traced by
 Checked by
 Series FAGM No. 162A Filed
 Sheet 5 of 46 Sheets