


INSTRUMENT	DATE	GRANTOR	GRANTEE	RECORDED	REMARKS
A	W.D.	1-13-38 GEO. F. PIETTE & ANNA SEYMOUR	STOFFT	7 380-391	121-30 CUL. 38 30+50
A'	Q.C.D.	1-13-38 NELLIE K. PERLEY	"	7 48	1-17-38
A''	Q.C.D.	1-17-38 D.A. GORDON	"	7 400	7-21-38

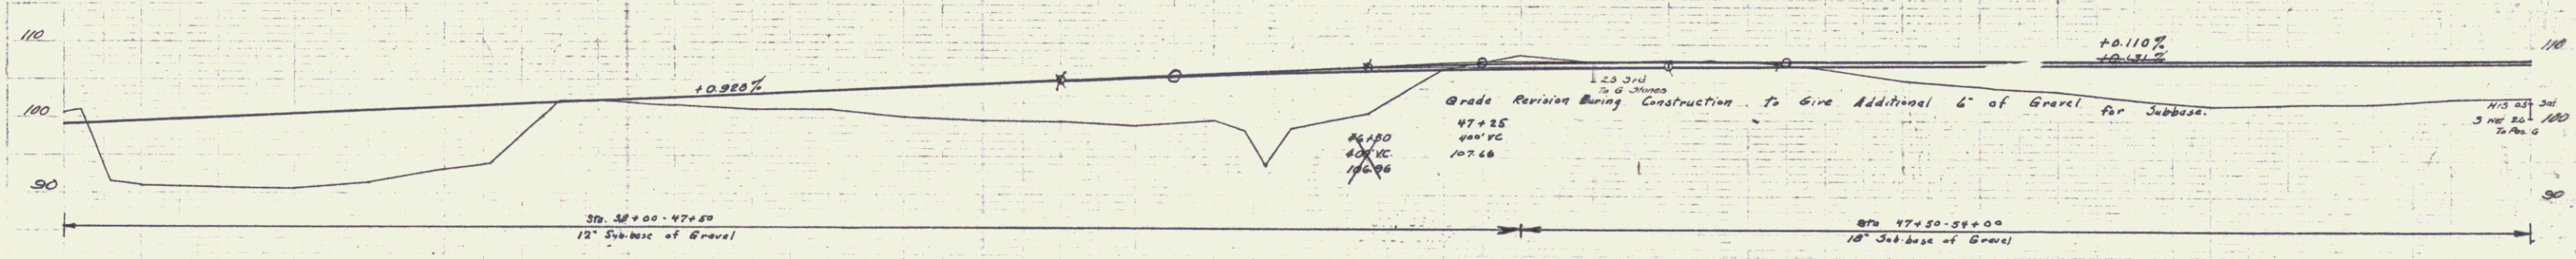

STATION	ELEVATION	REMARKS
30+00	99.00	
30+10	98.70	
30+20	99.35	
30+30	99.54	
30+40	99.66	
30+50	99.74	
30+60	99.85	
30+70	99.91	
30+80	100.00	
30+90	100.06	
31+00	100.14	
31+10	100.21	
31+20	100.29	
31+30	100.32	
31+40	100.37	
31+50	100.41	
31+60	100.45	
31+70	100.48	
31+80	100.51	
31+90	100.53	
32+00	100.55	
32+10	100.57	
32+20	100.59	
32+30	100.61	
32+40	100.62	
32+50	100.63	
32+60	100.64	
32+70	100.65	
32+80	100.66	
32+90	100.67	
33+00	100.68	
33+10	100.69	
33+20	100.70	
33+30	100.71	
33+40	100.72	
33+50	100.73	
33+60	100.74	
33+70	100.75	
33+80	100.76	
33+90	100.77	
34+00	100.78	

B.M.'S SPIKE IN ROOT OF 15' OAK 123' LT STA 41+50 ELEV 92.97
 B.M.'S 34' MAPLE 125' RT STA 53+00 ELEV 121.60

SERIES PAGE NO 164 A
 SHEET 7 OF 46