




G.H. Jones
 R.V. Barry

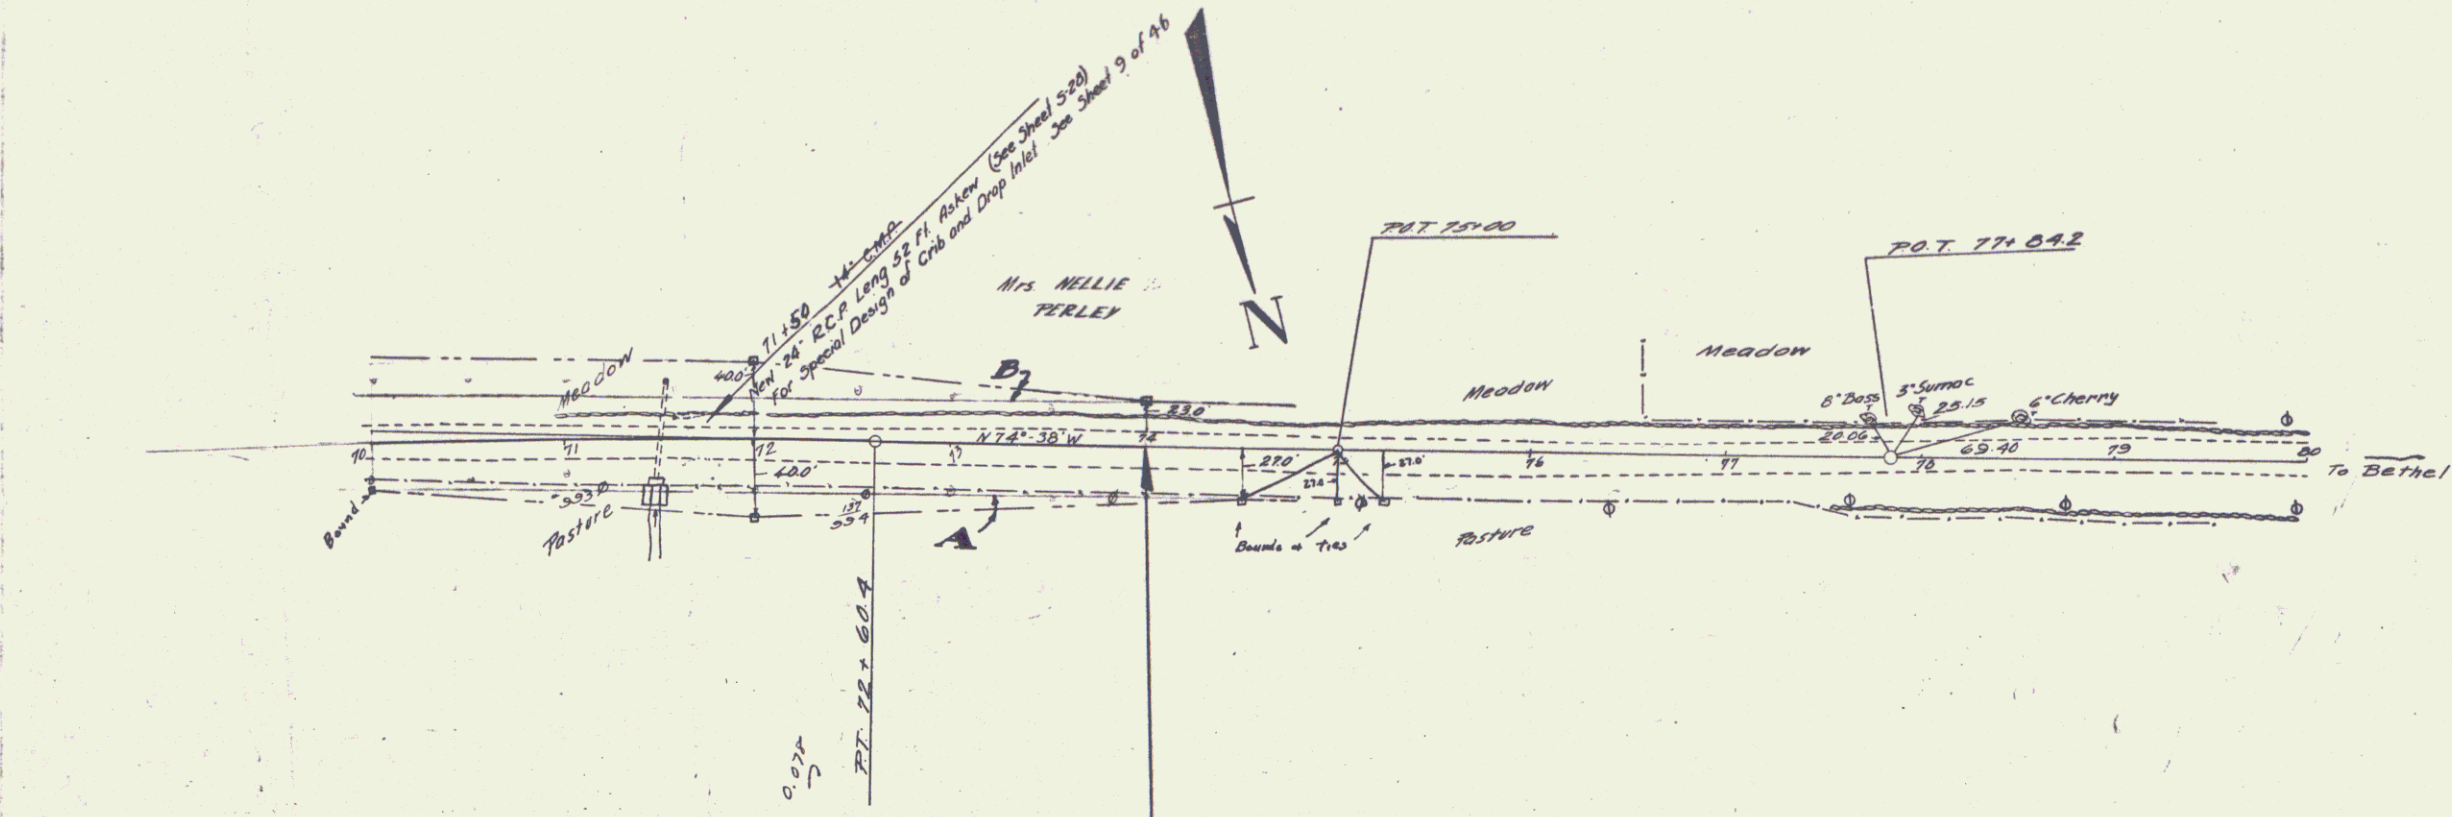

PARCEL INSTRUMENT	DATE	GRANTOR	GRANTEE	RECORDED	REMARKS
A-8	Q.C.D. 1-13-38	NELLIE V. TERLEY	STOF VT.	ROYALTON BOOK 7 PAGE 23 DATE 1-17-38	

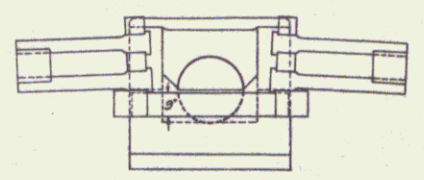


For further details of Cribbing See Standard Structure Sheet 3-35
 For further details of Drop Inlet See Standard Structure Sheet 3-28

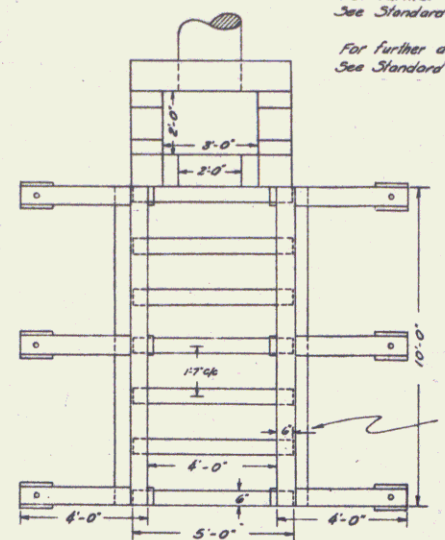

DETAIL OF CONCRETE CLEATS TO BE MADE OF CONCRETE CLASS W REINFORCING STEEL TO BE 6" & 8" DIAMETER BARS.

DETAILS OF SPECIAL INLET FOR CULVERTS AT STA. 69+15 & 71+67

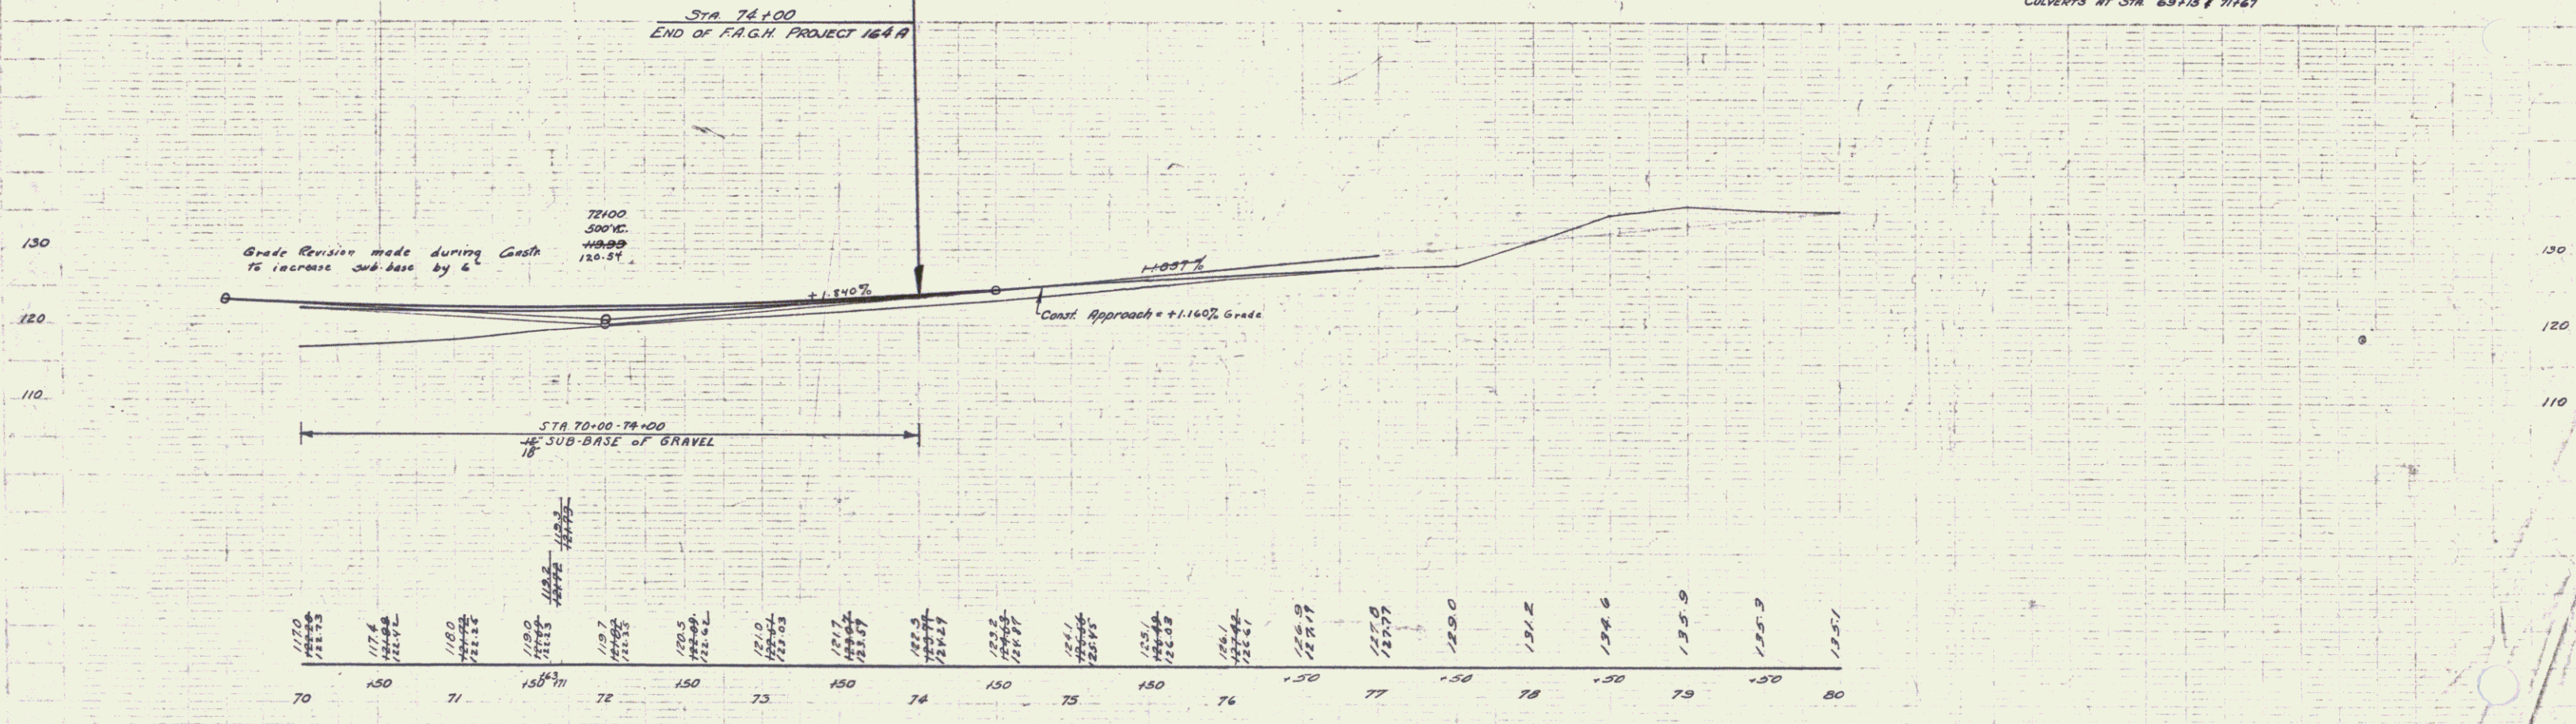

7