



PLAN
 1/2" = 100'
 1/4" = 50'
 1/8" = 25'
 1/16" = 12.5'

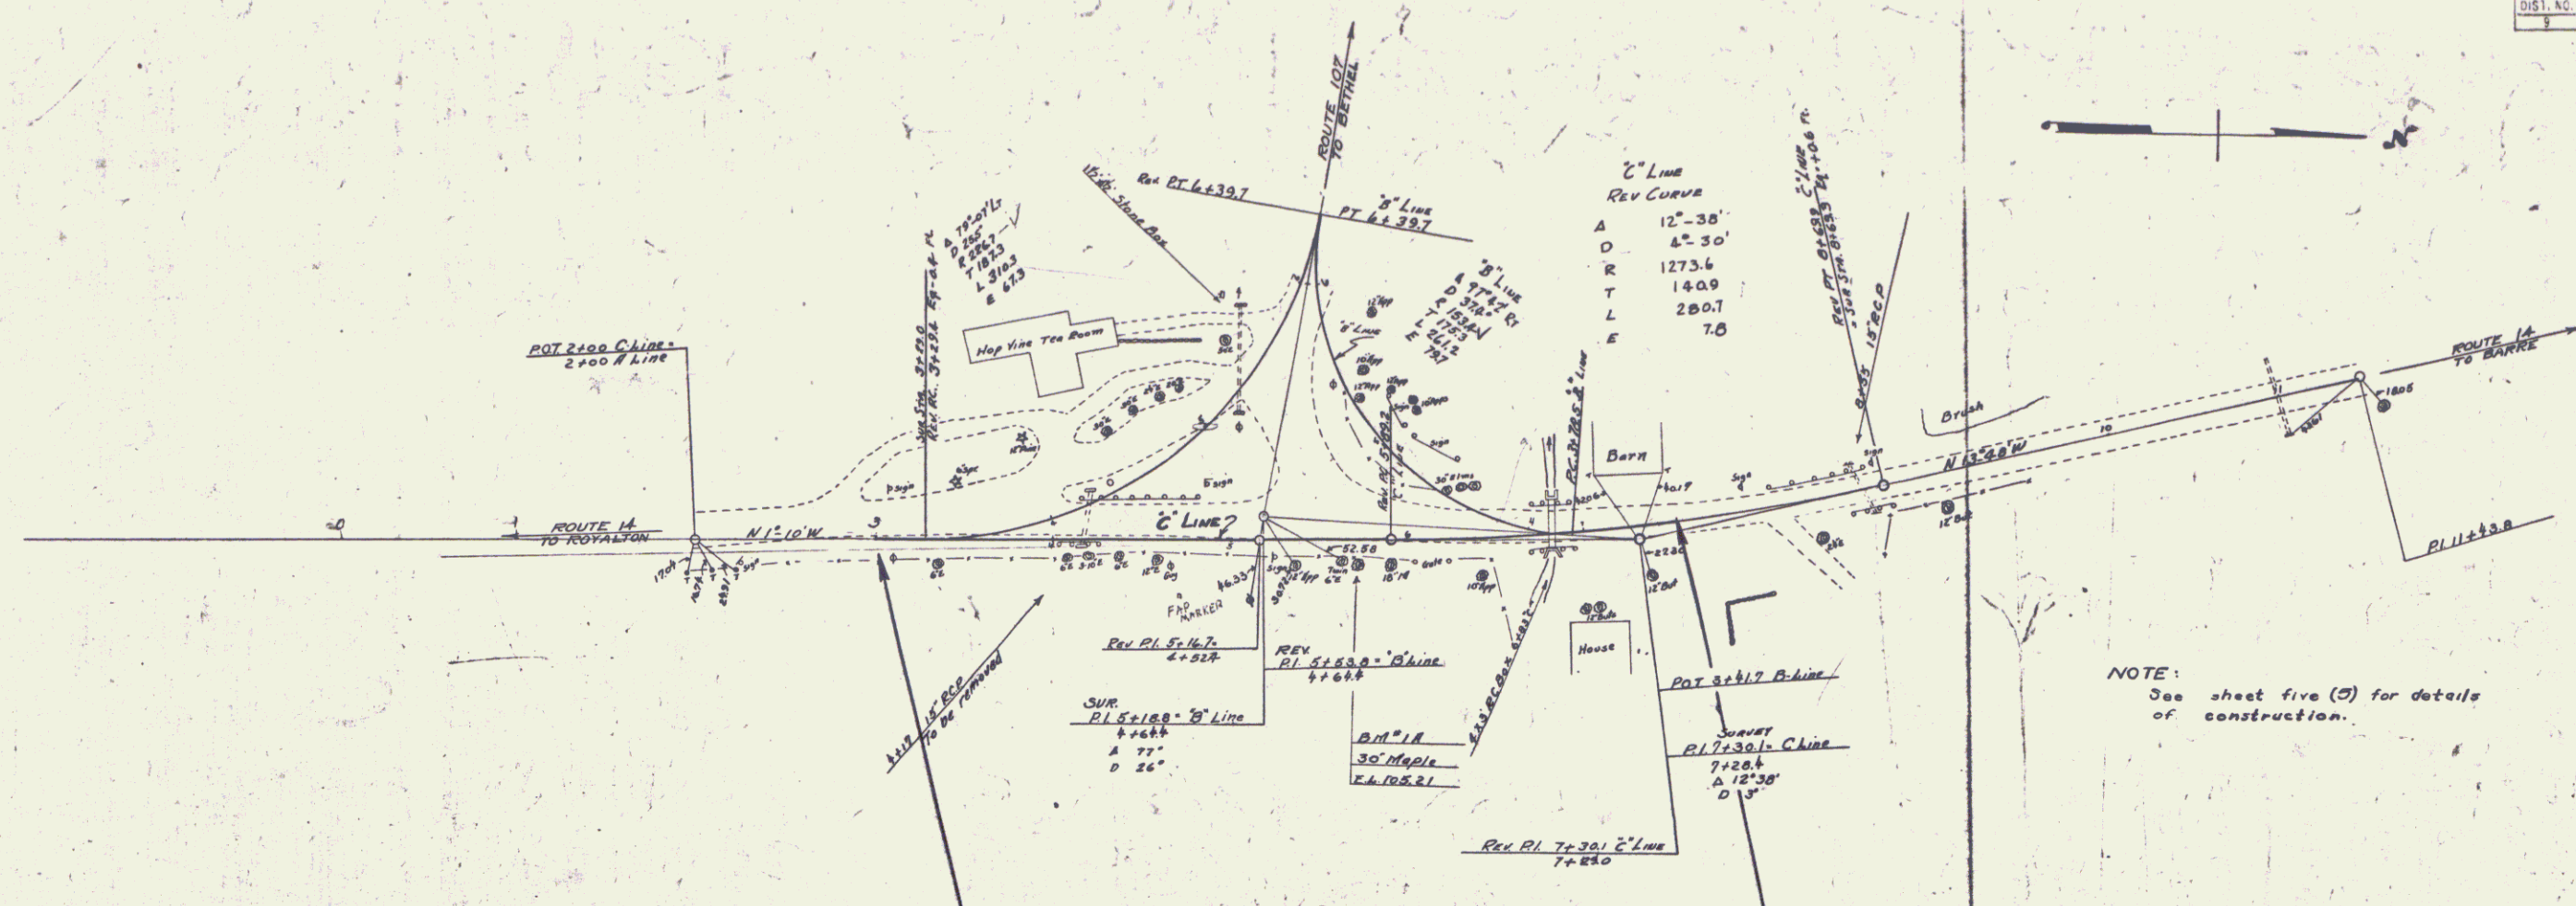

NOTE:
 See sheet five (5) for details of construction.

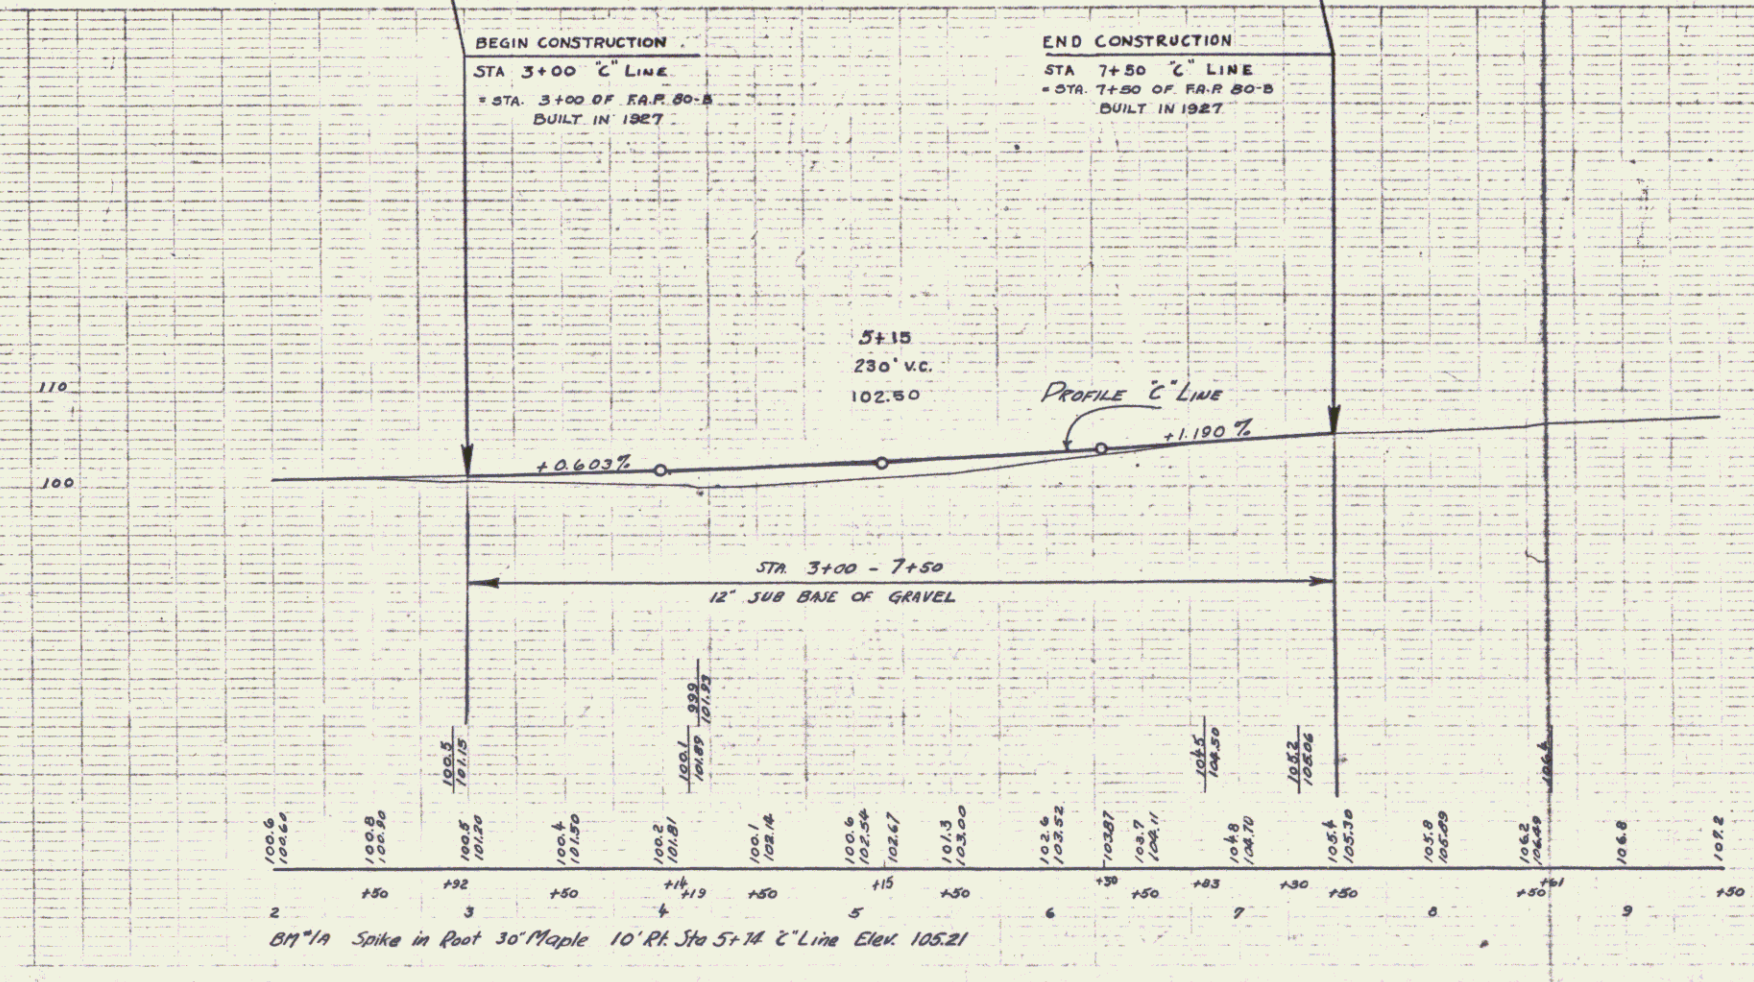

BM 1/18 Spike in Root 30 Maple 10' RL Sta 5+74 'C' Line Elev. 105.21