

PLAN  
 DATE  
 DRAWN BY  
 CHECKED BY  
 NOTE BOOK ALPHABETICALLY CHECKED  
 NO. OF SHEETS

PROFILE  
 DATE  
 DRAWN BY  
 CHECKED BY  
 NOTE BOOK ALPHABETICALLY CHECKED  
 NO. OF SHEETS

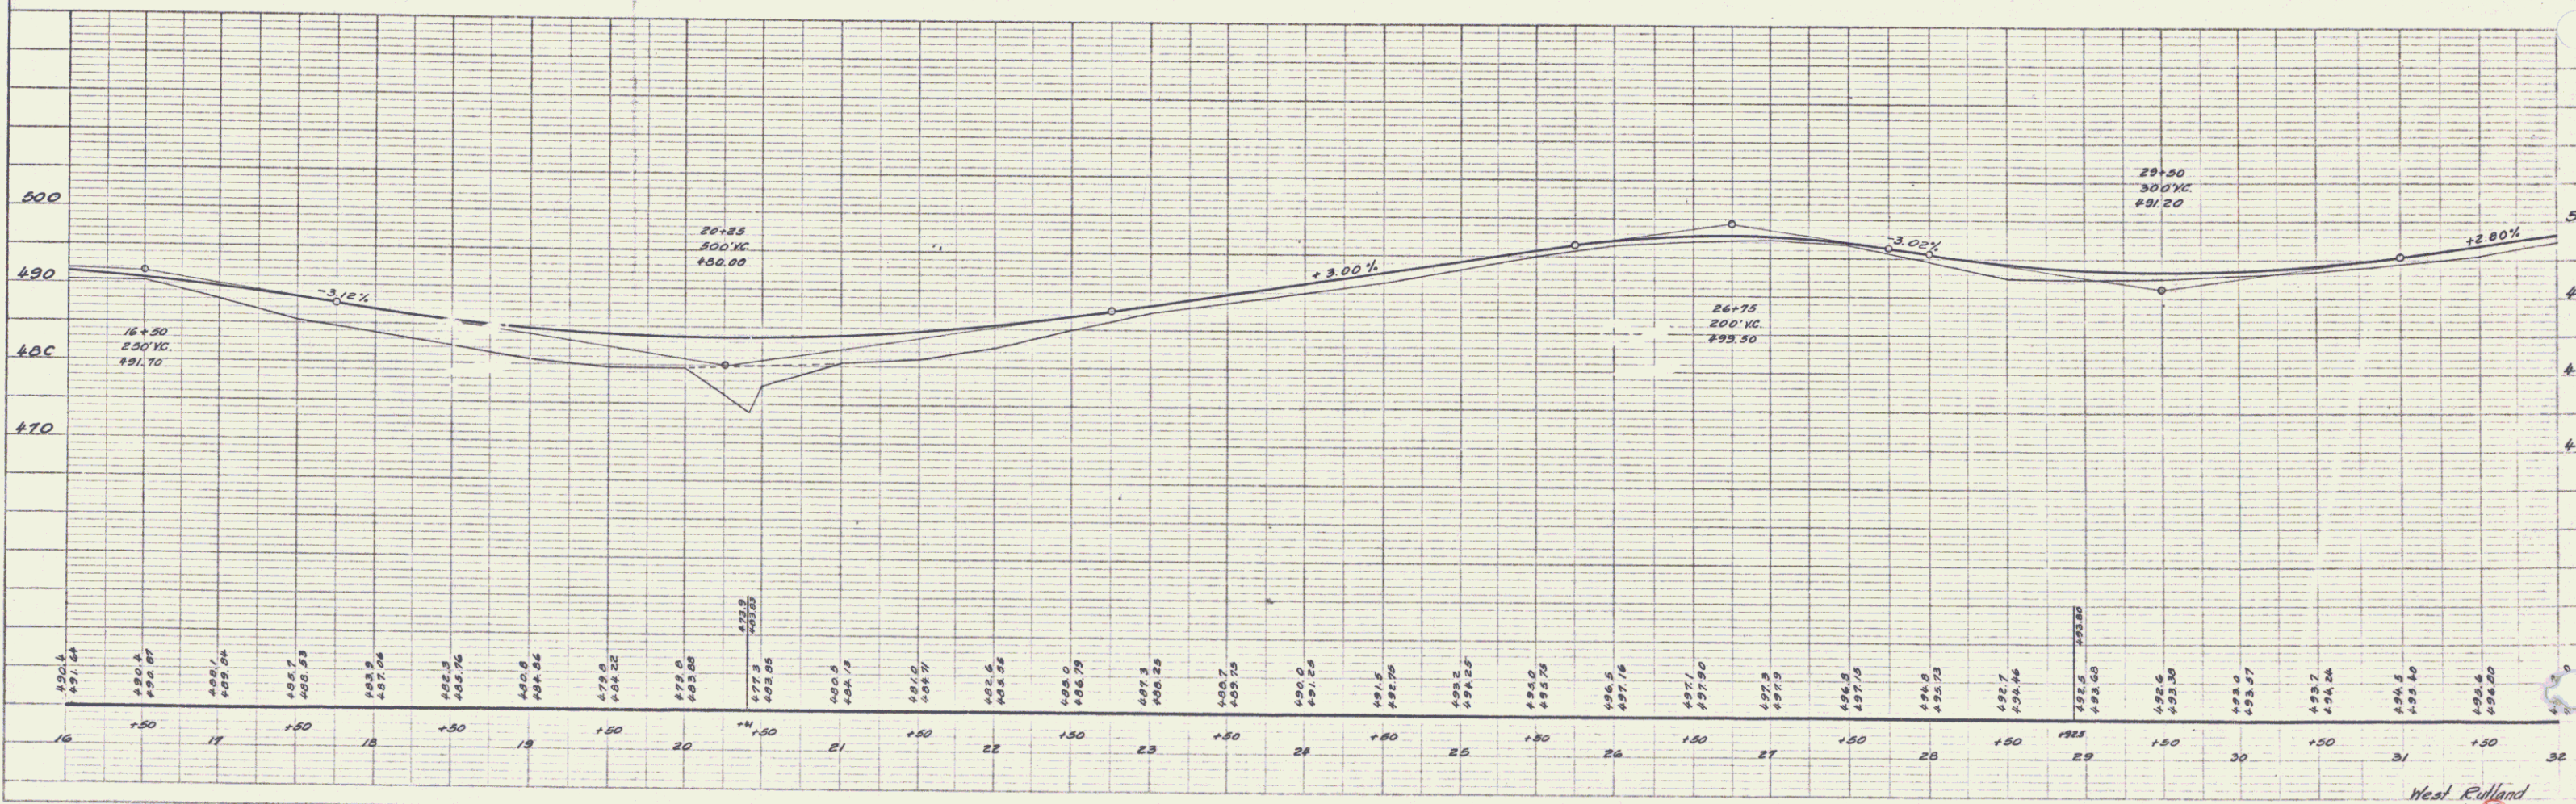
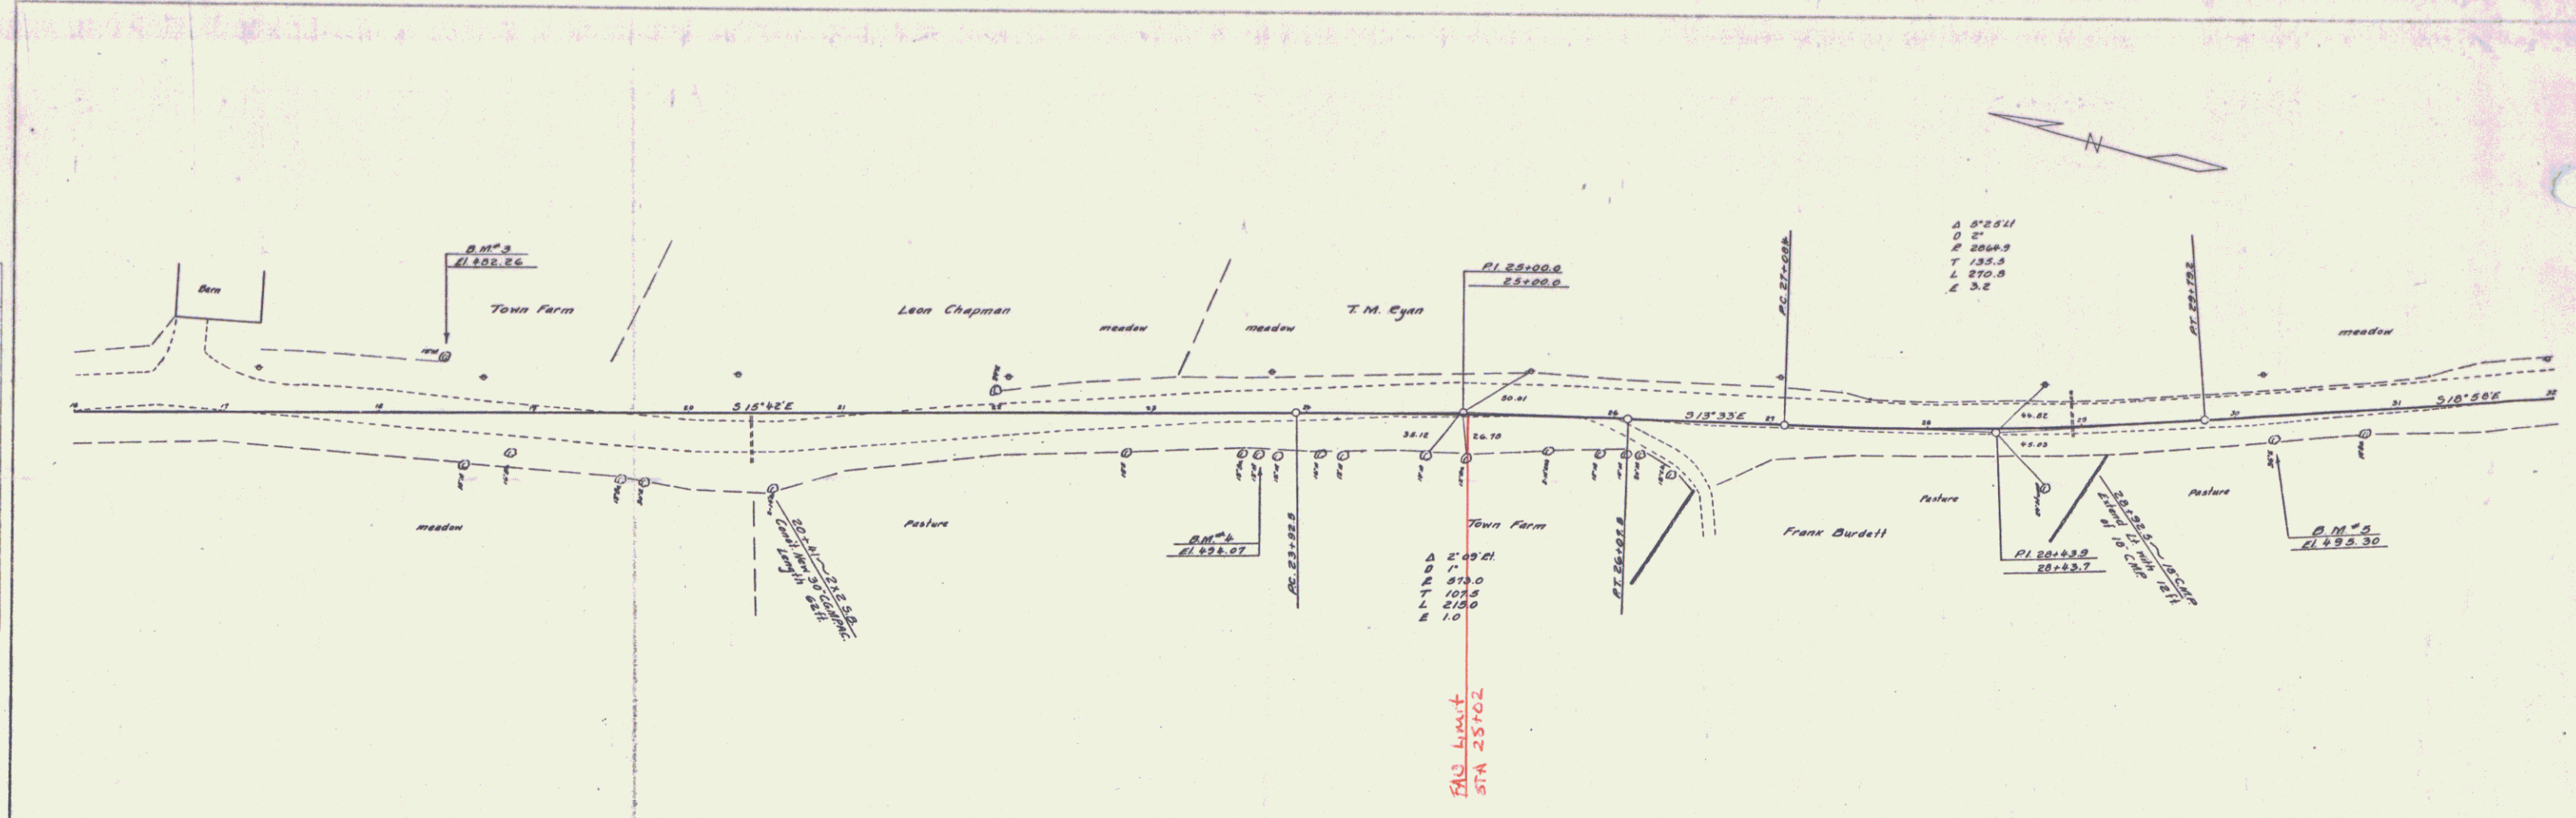


PLATE 1 - PLAN & PROFILE OF TOWN FARM ROAD  
 REPTER & ENGINE CO. NEW YORK

West Rufford  
 Sheet 2

2