




TOWN OF BRAINTREE
 COUNTY OF ORANGE
 ROUTE 12A
 RANDOLPH-ROXBURY ROAD

BEARING OF 12° 10' 41" N. 12° 10' 41" E. 12° 10' 41" S. 12° 10' 41" W. 12° 10' 41" N. 12° 10' 41" E. 12° 10' 41" S. 12° 10' 41" W.

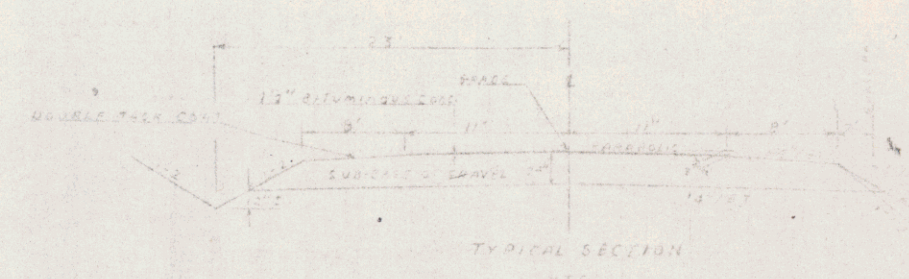

POOR ORIGINAL COPY

SK Jenkins
 3-13-68

JKR
 Feb. 29 1968

L.M. Lane
 3-13-68

EH Hickey
 4-1-68

RH Cund
 4/1/68

TOWN BRAINTREE
 PROJECT 221A-574-57

1A 3