



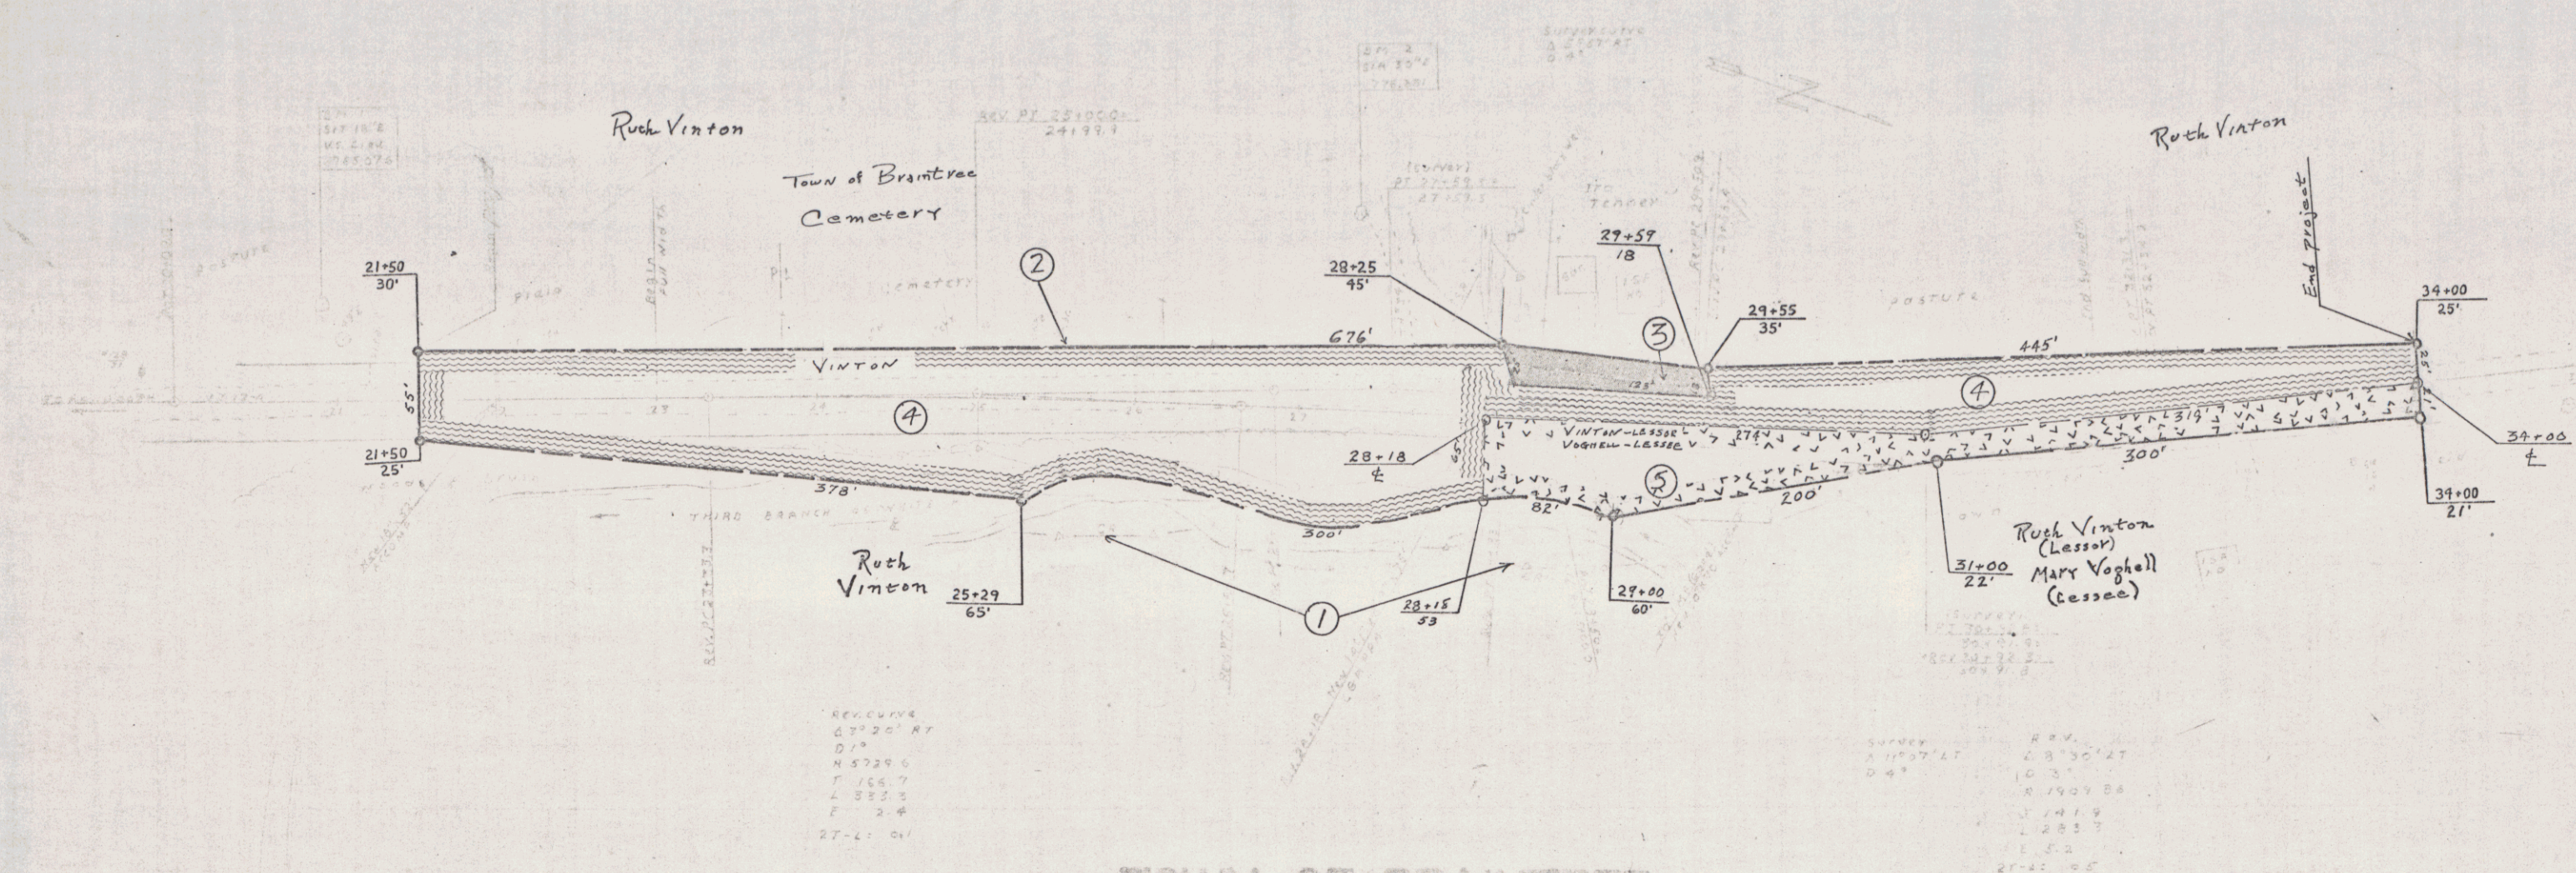

TOWN OF BRAINTREE
 COUNTY OF ORANGE
 ROUTE 12A
 RANDOLPH-ROXBURY ROAD
 BEGINNING AT A POINT 0.11 MILES SOUTHWEST OF
 THE JCT. WITH TOWN RD. AND EXTENDING NORTHEASTLY
 12.50 FEET.

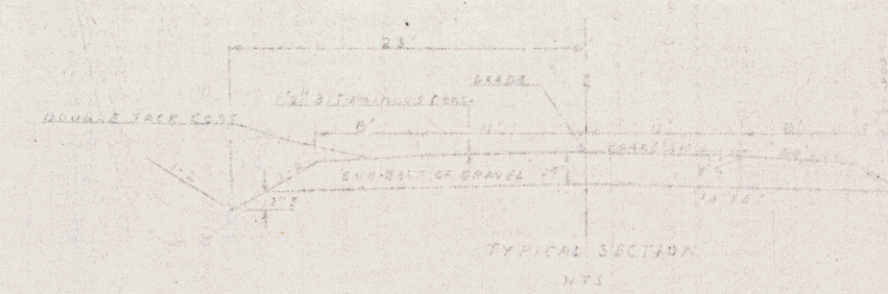

POOR ORIGINAL COPY

SHEET 10