


See also sheet 12 of 35 of project 108-A

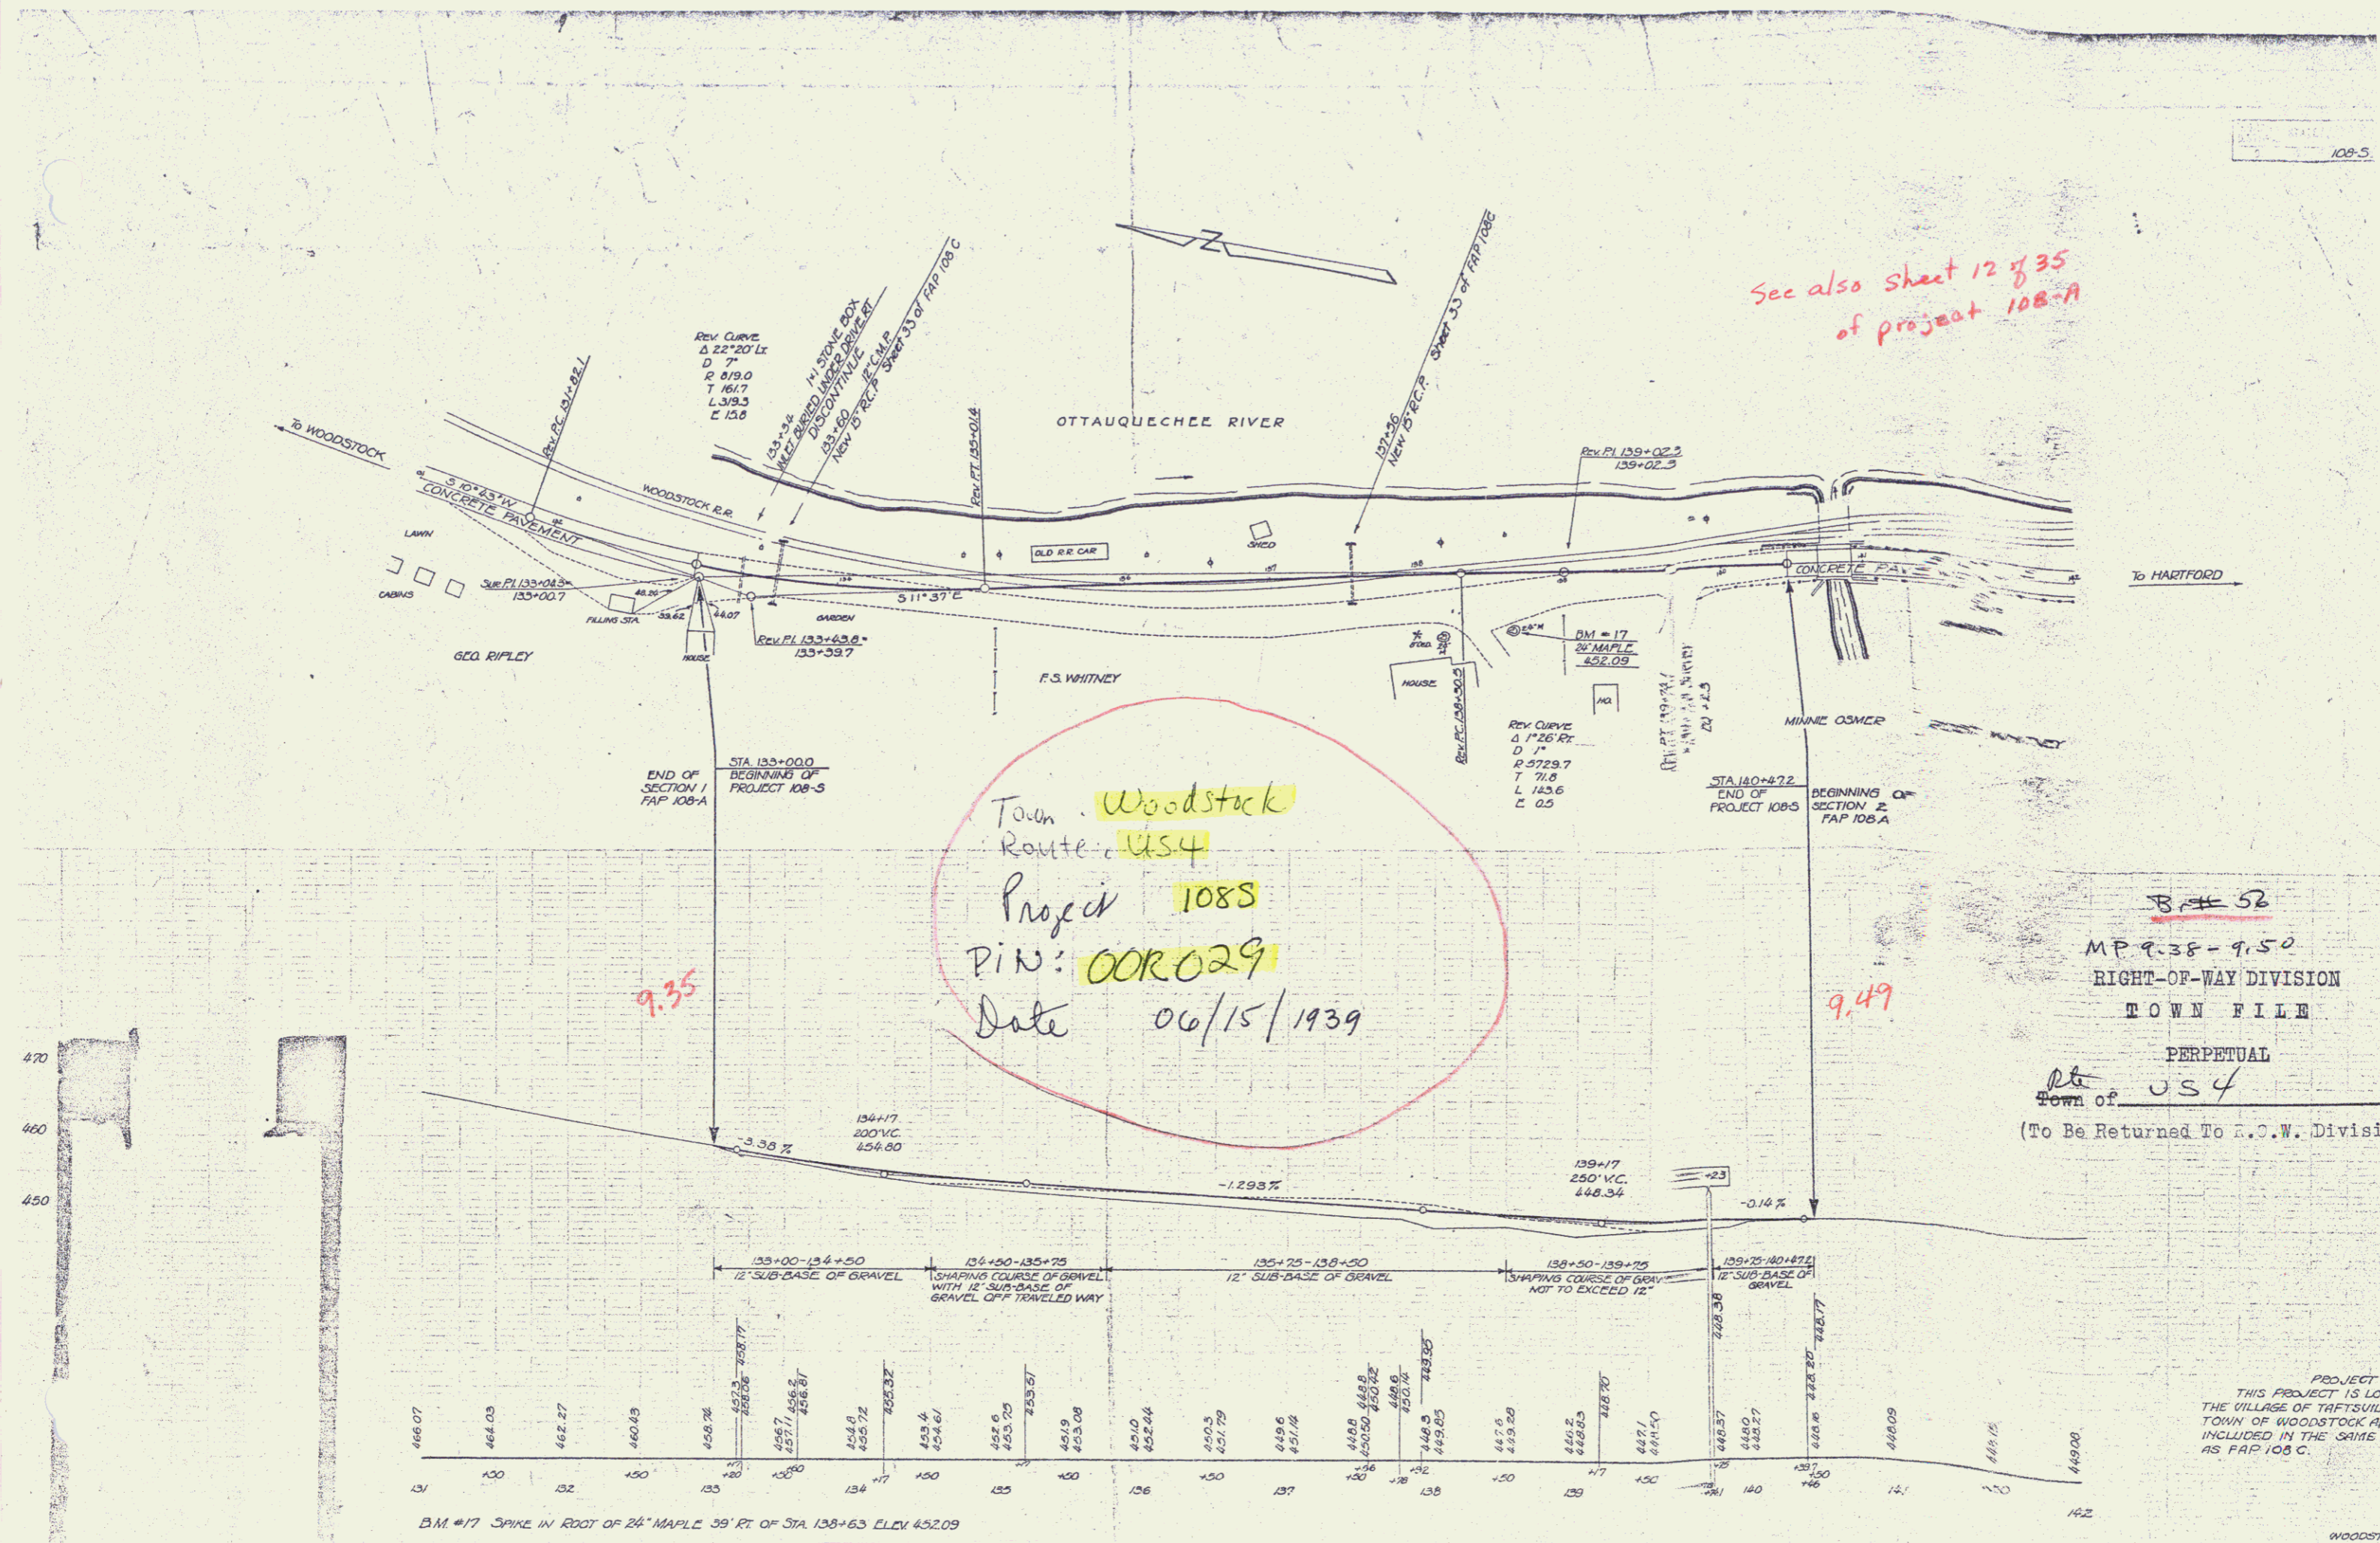

Town **Woodstock**
 Route **US4**
 Project **108S**
 PIN: **00R029**
 Date **06/15/1939**

B# 52
 MP 9.38 - 9.50
 RIGHT-OF-WAY DIVISION
 TOWN FILE
 PERPETUAL
 Town of **US4**
 (To Be Returned To R.O.W. Divisi

PROJECT LOCATED IN THE VILLAGE OF TRAFSVILLE IN THE TOWN OF WOODSTOCK AND IS INCLUDED IN THE SAME CONTRACT AS FAP 108 C.