


See also sheet 12 of 35 of project 108-A

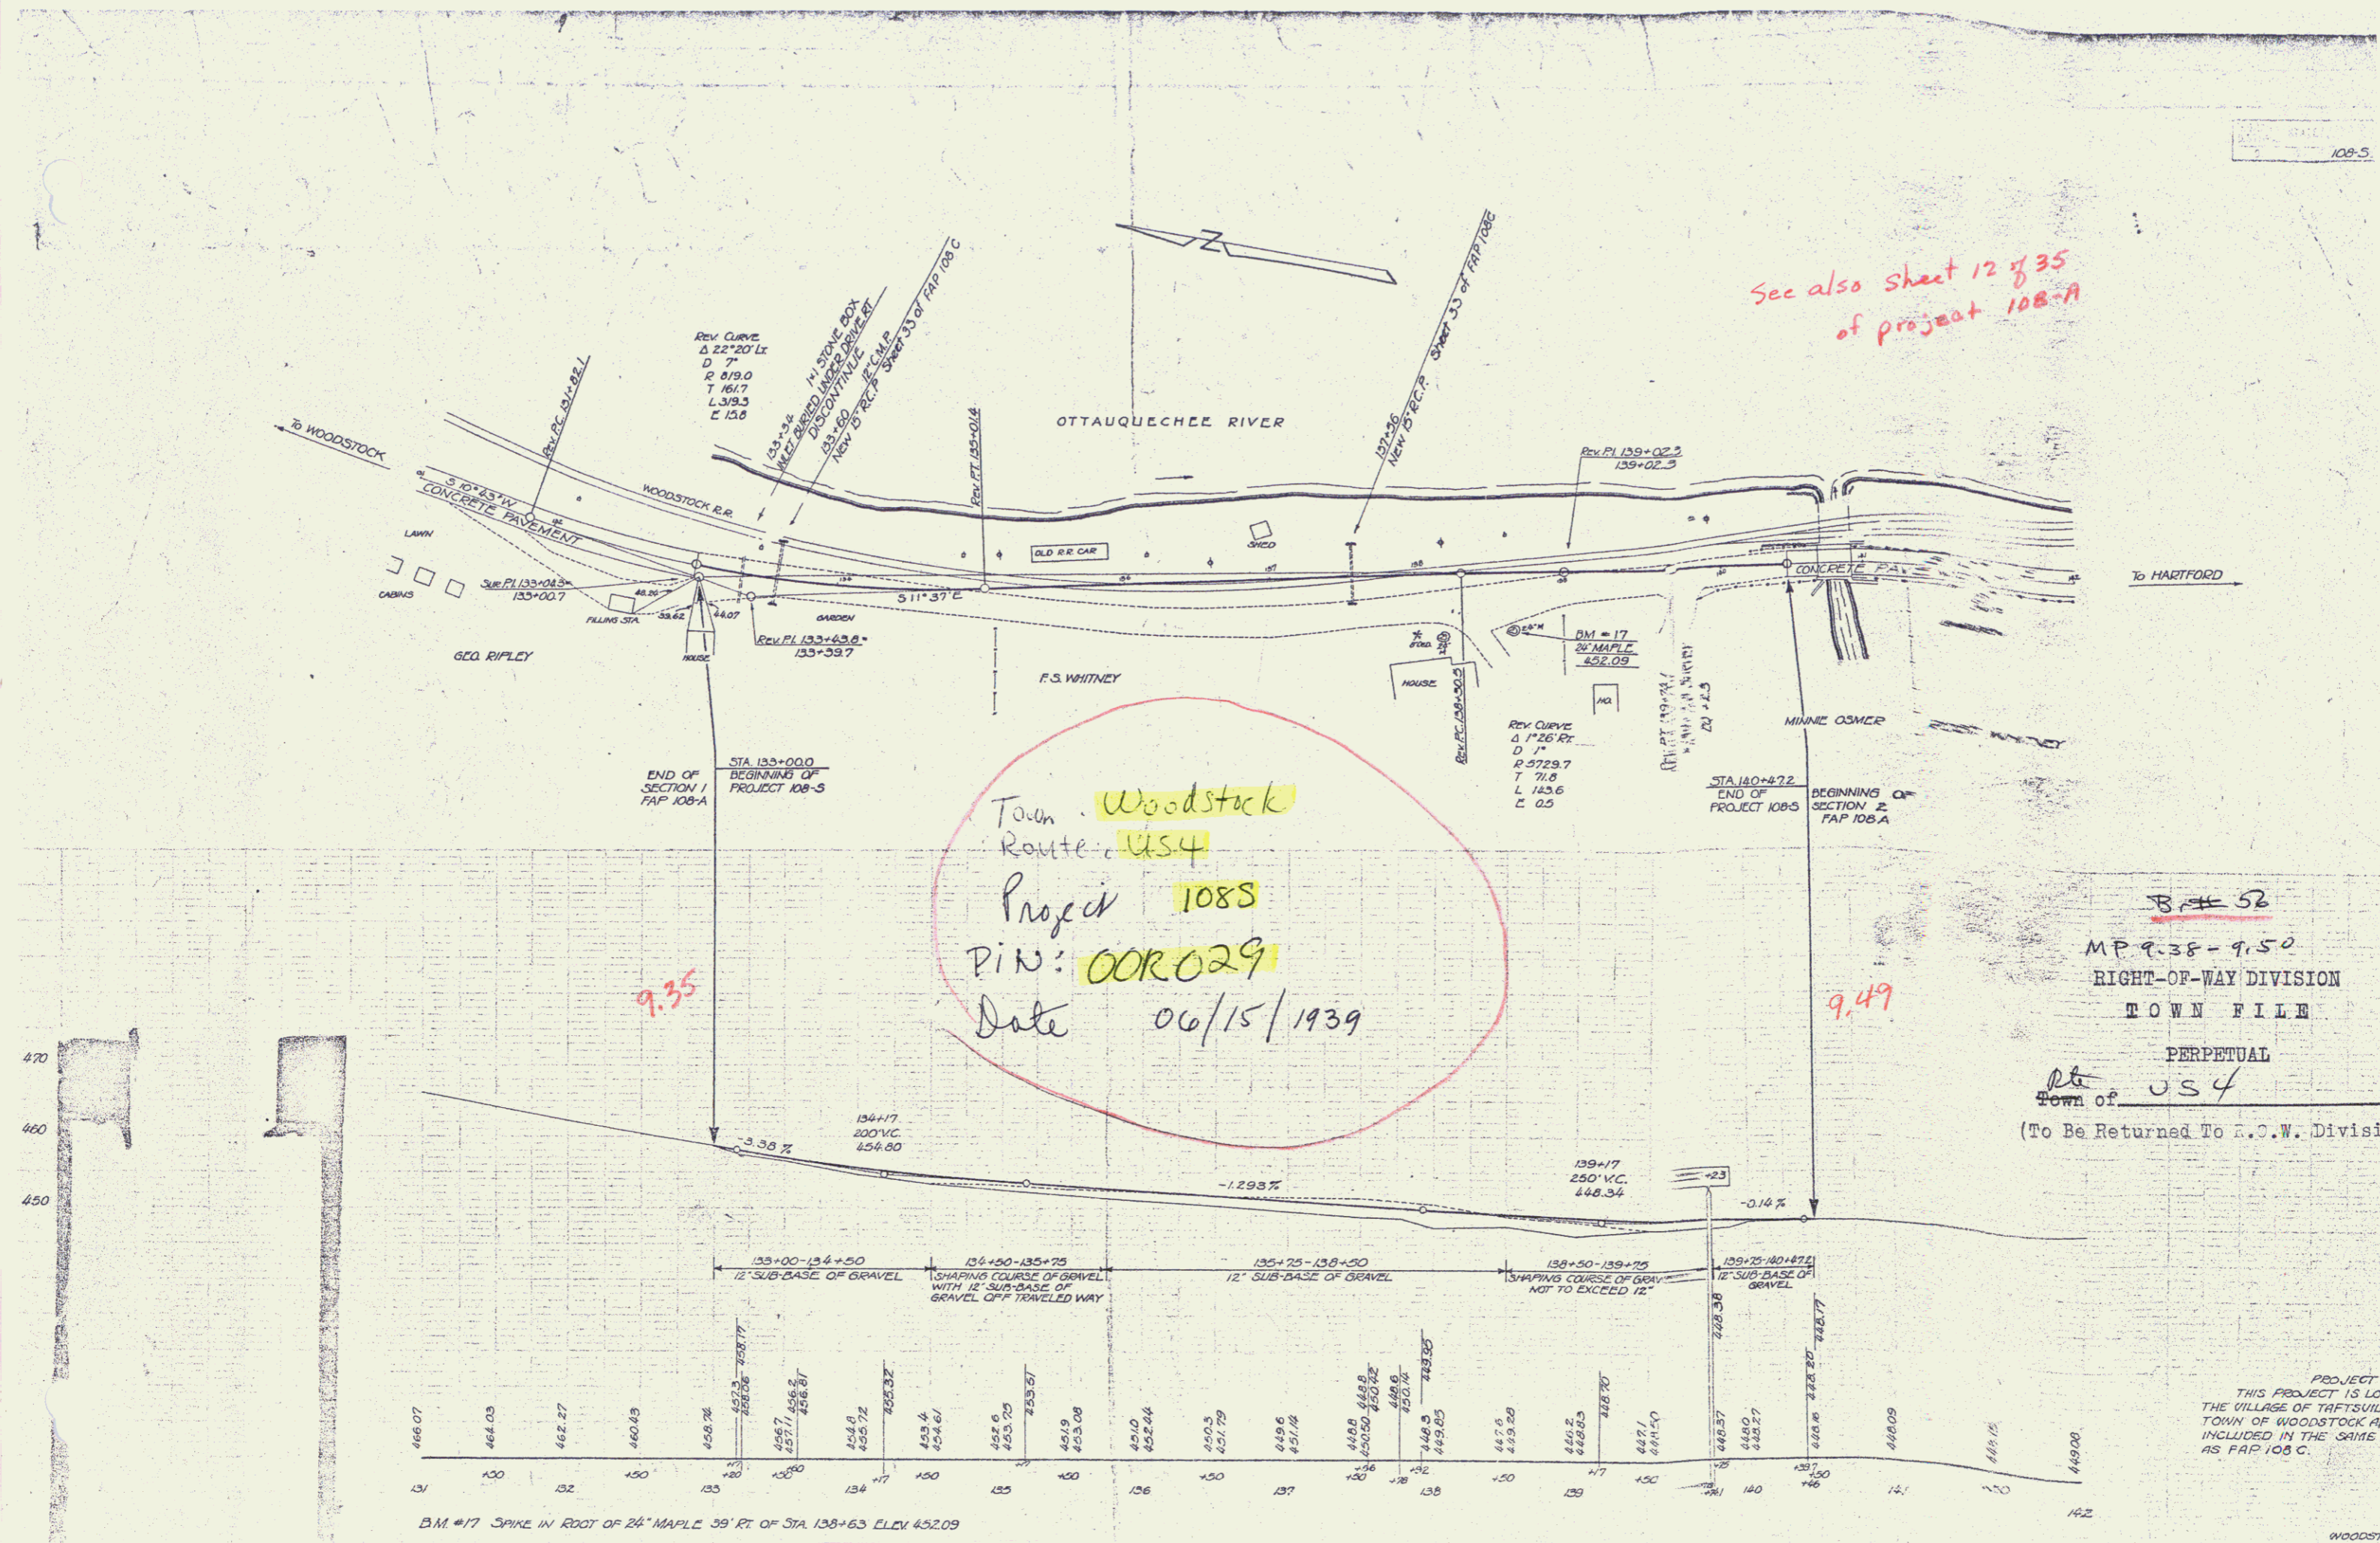

Town Woodstock
 Route US4
 Project 108S
 PIN: 00R029
 Date 06/15/1939

B.# 52
 MP 9.38-9.50
 RIGHT-OF-WAY DIVISION
 TOWN FILE
 PERPETUAL
 Town of US4
 (To Be Returned To R.O.W. Divisi

PROJECT LOCATED IN THE VILLAGE OF TRAFSUILLE IN THE TOWN OF WOODSTOCK AND IS INCLUDED IN THE SAME CONTRACT AS FAP 108-C.