


DIST. NO.	STATE	PROJ. NO.	YEAR	SHEET NO.	TOTAL SHEETS
8				4	4

REV CURVE
 Δ 76°02'LE
 D 7'15"
 R 790.8
 T 617.8
 L 1048.7
 E 2129

PLAN
 DRAWN BY
 CHECKED BY
 DATE
 SCALE
 TITLE

PLAN
 DRAWN BY
 CHECKED BY
 DATE
 SCALE
 TITLE

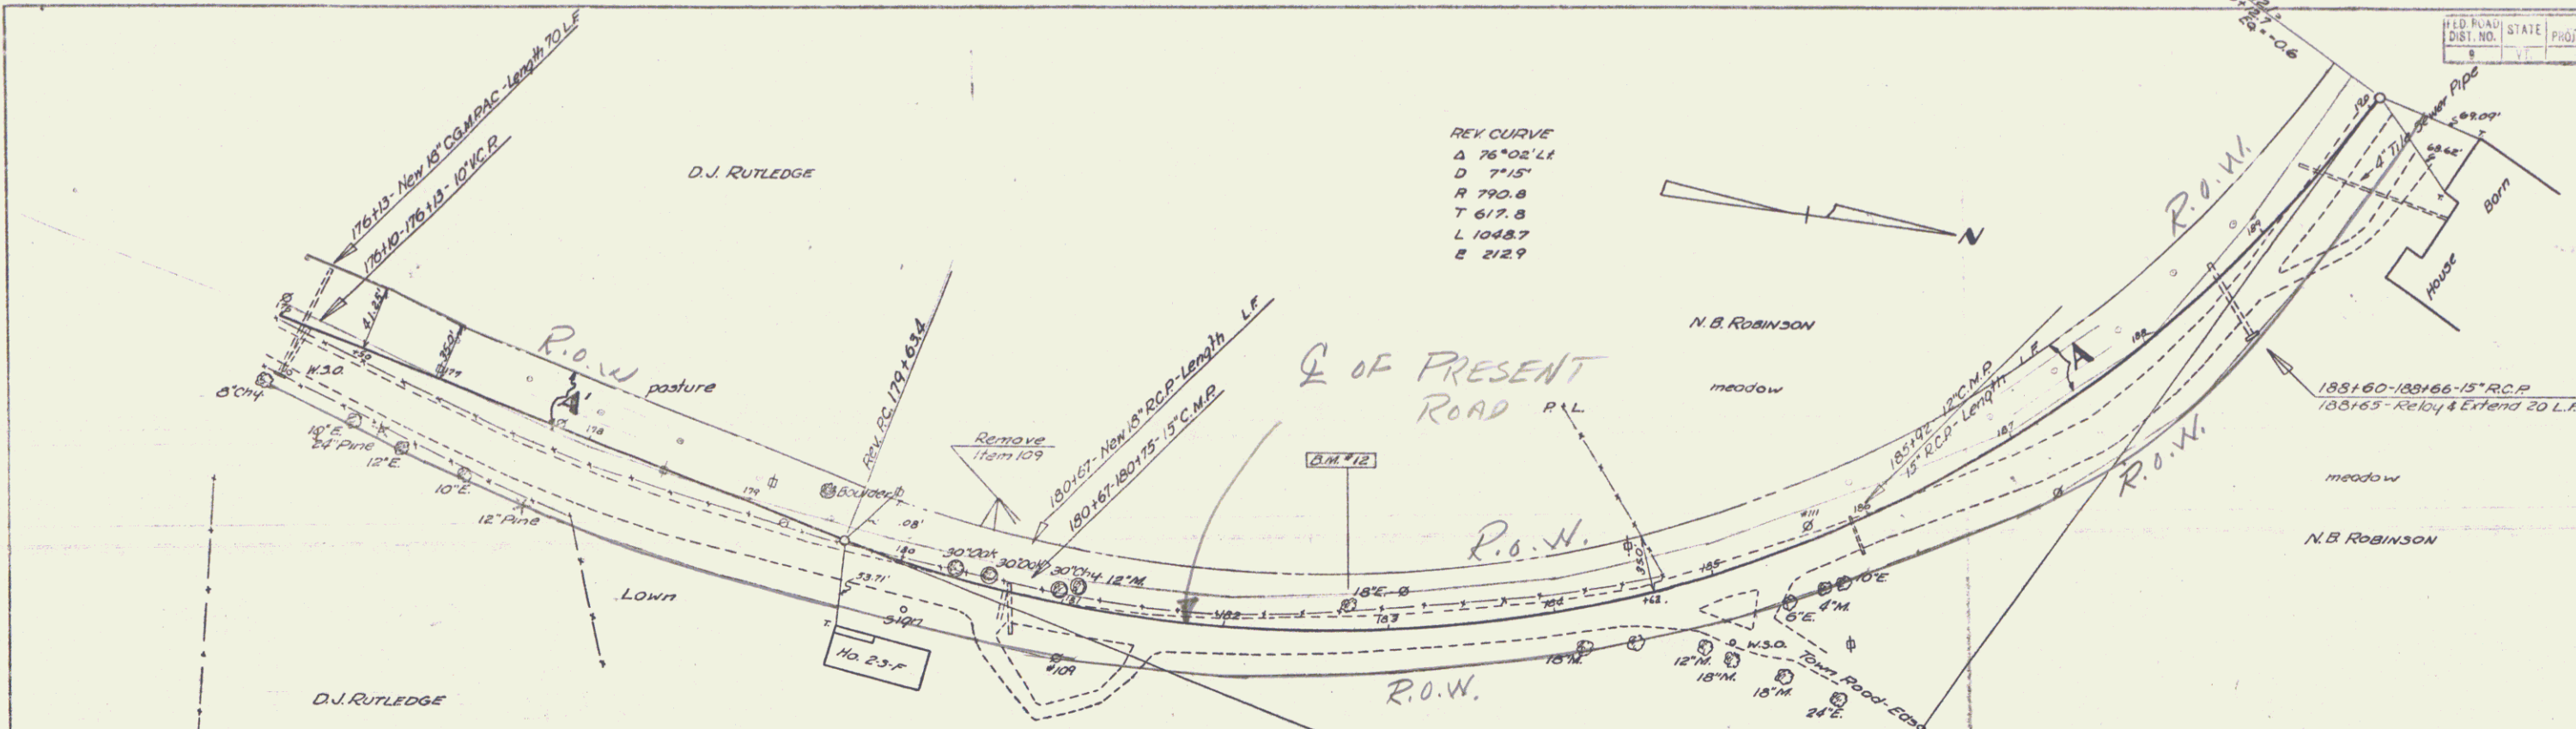

PARCEL	INSTRUMENT	DATE	GRANTOR	GRANTEE	RECORDED	STOWE	REMARKS
					BOOK	PAGE	DATE
A	W.D.O.E.	MAY 13/46	N.B. & MARY E. ROBINSON	ST. OF VT.	45	432-33	MAY 21/46
A'	W.D.O.E.	AUG. 12/46	DAVID J. & PHYLLIS C. RUTLEDGE, JR.	" " "	44	291	DEC. 12/46

176 177 178 179 180 181 182 183 184 185 186 187 188 189 190

B.M. #12 Spike in Root of 18" Elm 18 Ft. Lt. of Sta. 182+79 Elev. 422.19

STONE ST. 234R
 SERIES NO.
 SHEET 4 OF 4