
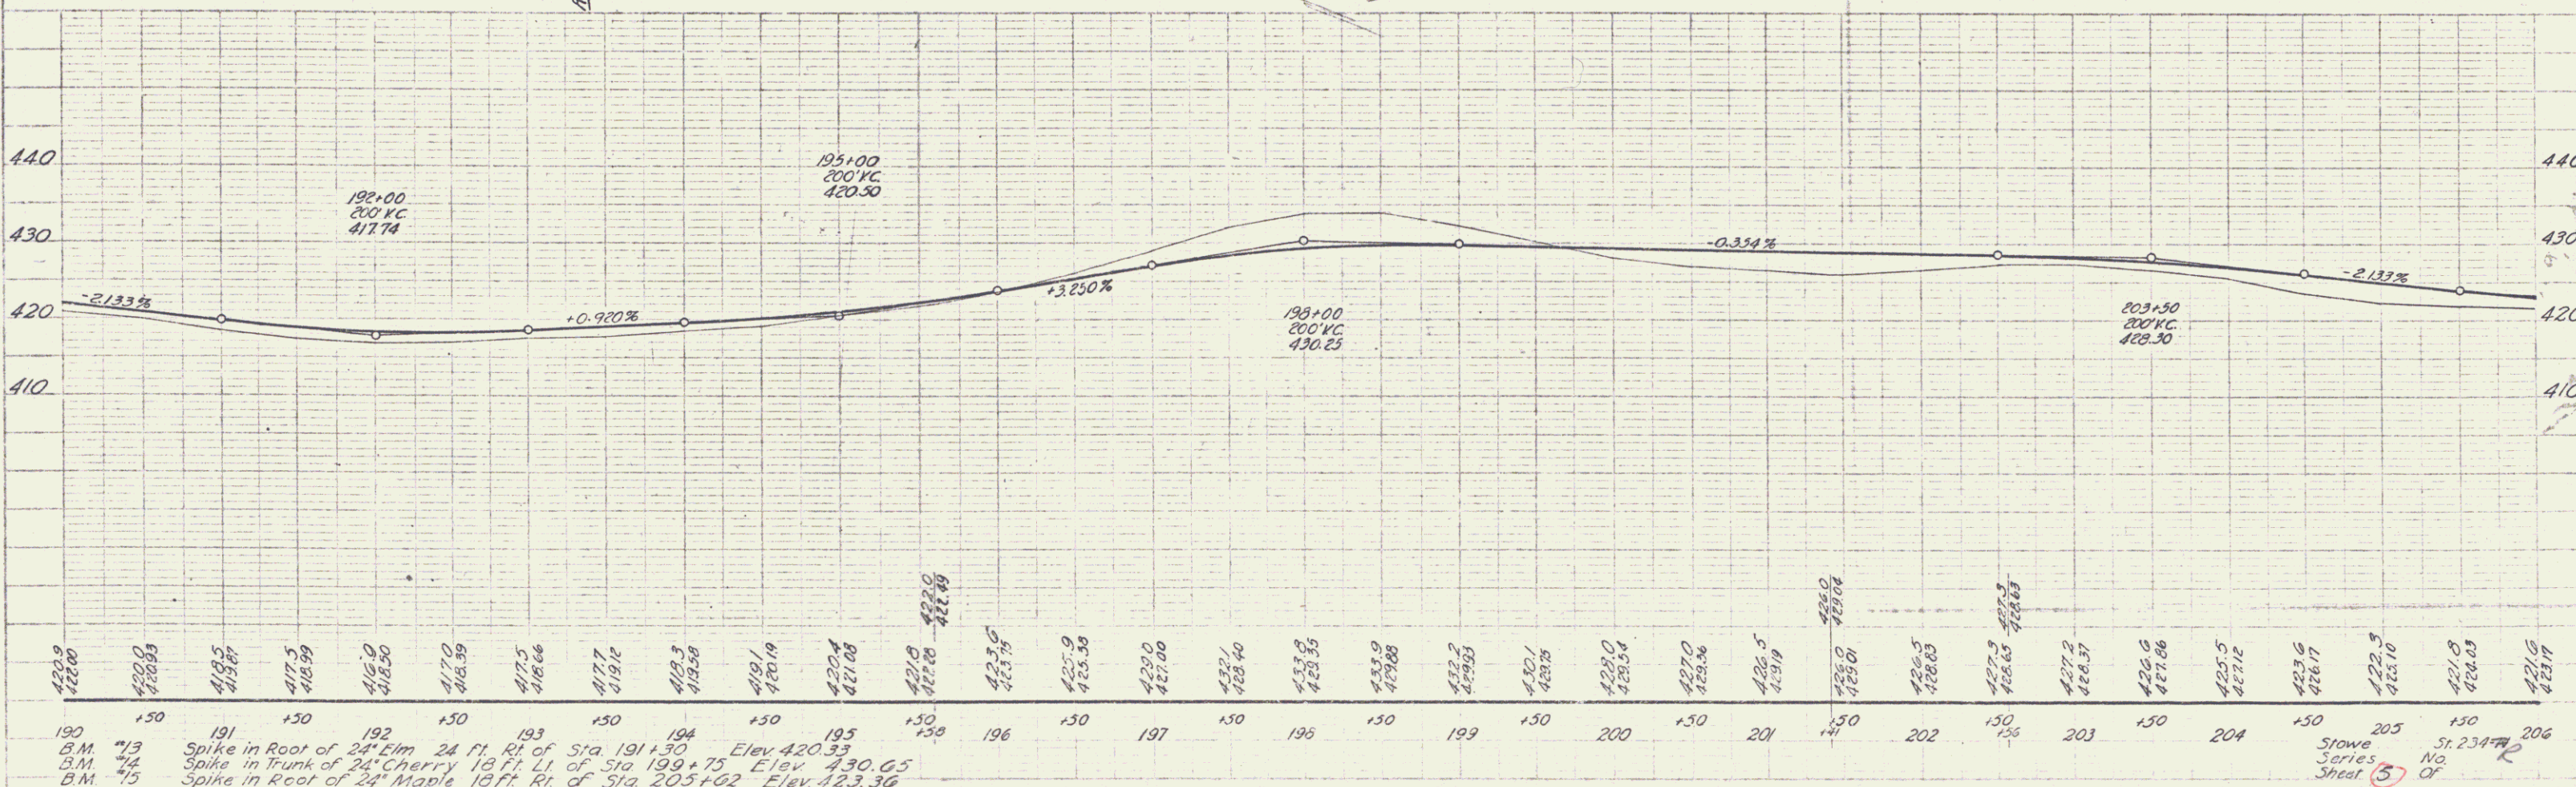


PARCEL	INSTRUMENT	DATE	GRANTOR	GRANTEE	RECORDED	REMARKS	
					BOOK	STOWE	
					PAGE	DATE	
A	W.D.O.E.	10-30-45	JOHN J. & HAZEL A. MCMANIS	ST. OF VT.	44	213	11-28-45
A'	W.D.O.E.	12-10-45	JOHANN & LOUISE THOME	ST. OF VT.	44	222	1-11-46

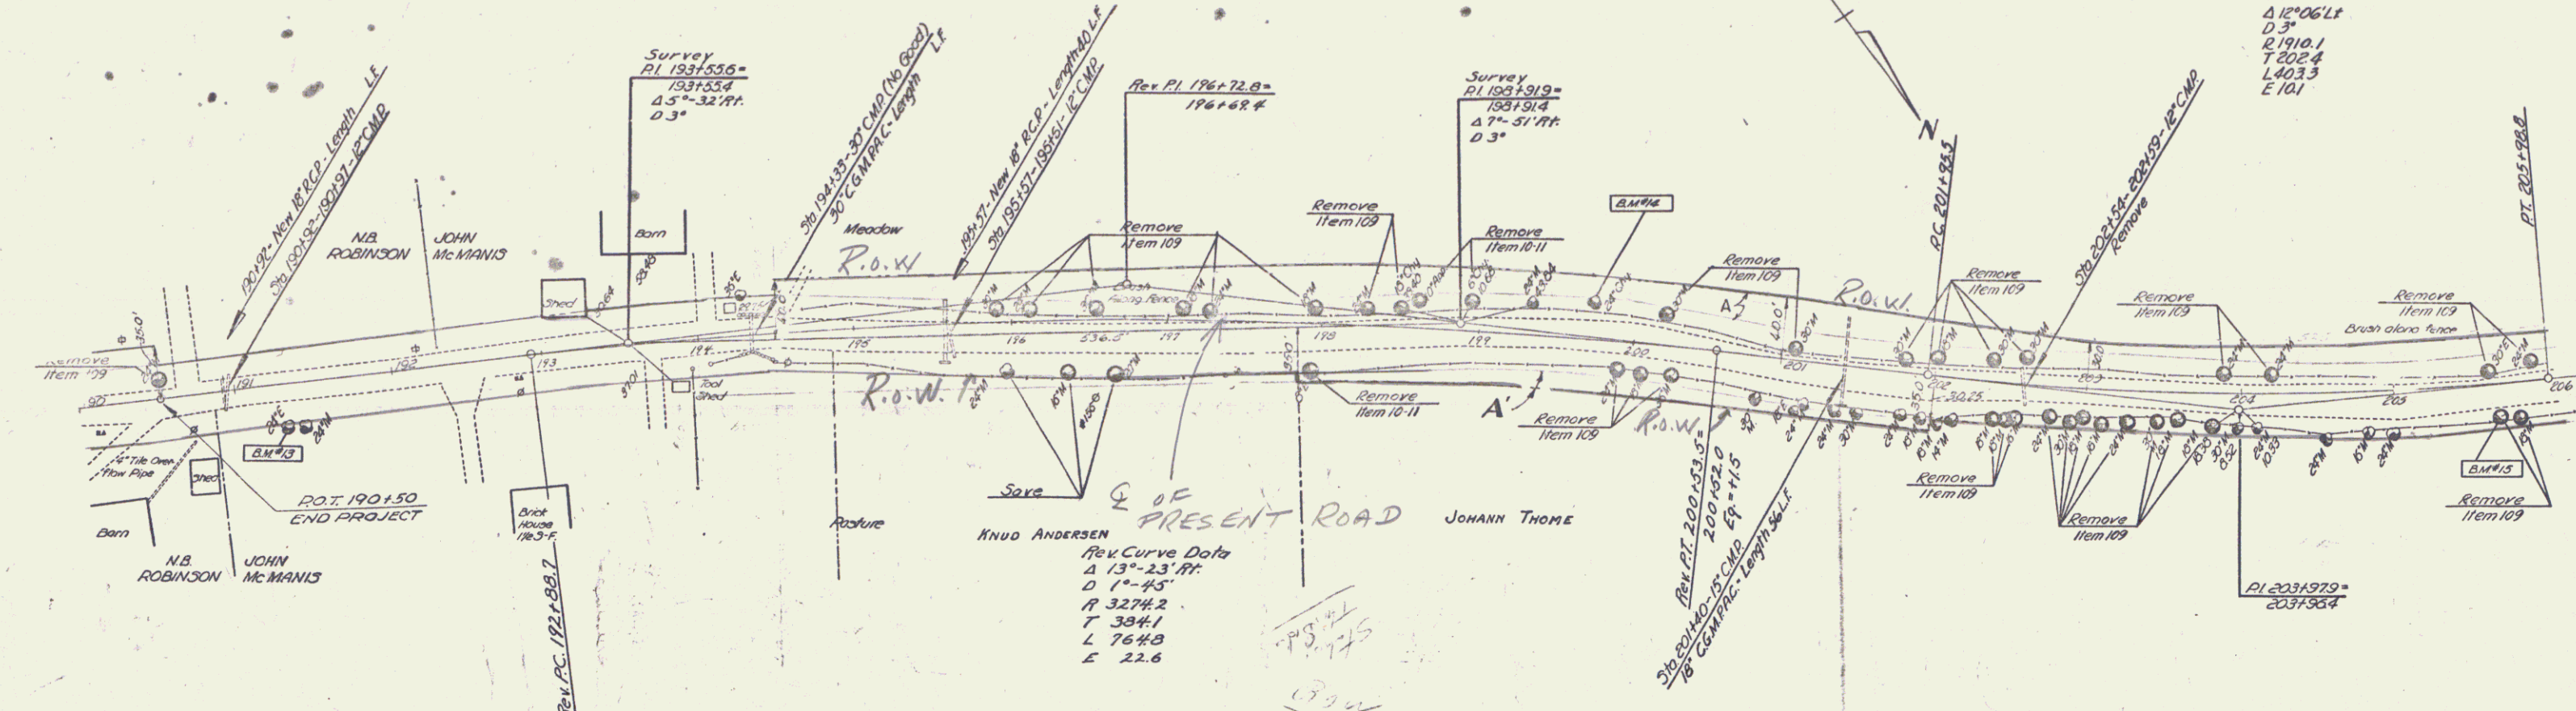

190 B.M. 19  
 191 Spike in Roof of 24' Elm 24 Ft. Rt. of Sta. 191+30 Elev. 420.33  
 192 Spike in Trunk of 24' Cherry 18 Ft. Lt. of Sta. 199+75 Elev. 430.05  
 193 Spike in Root of 24' Maple 18 Ft. Rt. of Sta. 205+62 Elev. 423.36  
 194  
 195  
Stowe  
 Series  
 Sheet 5  
 No. of