
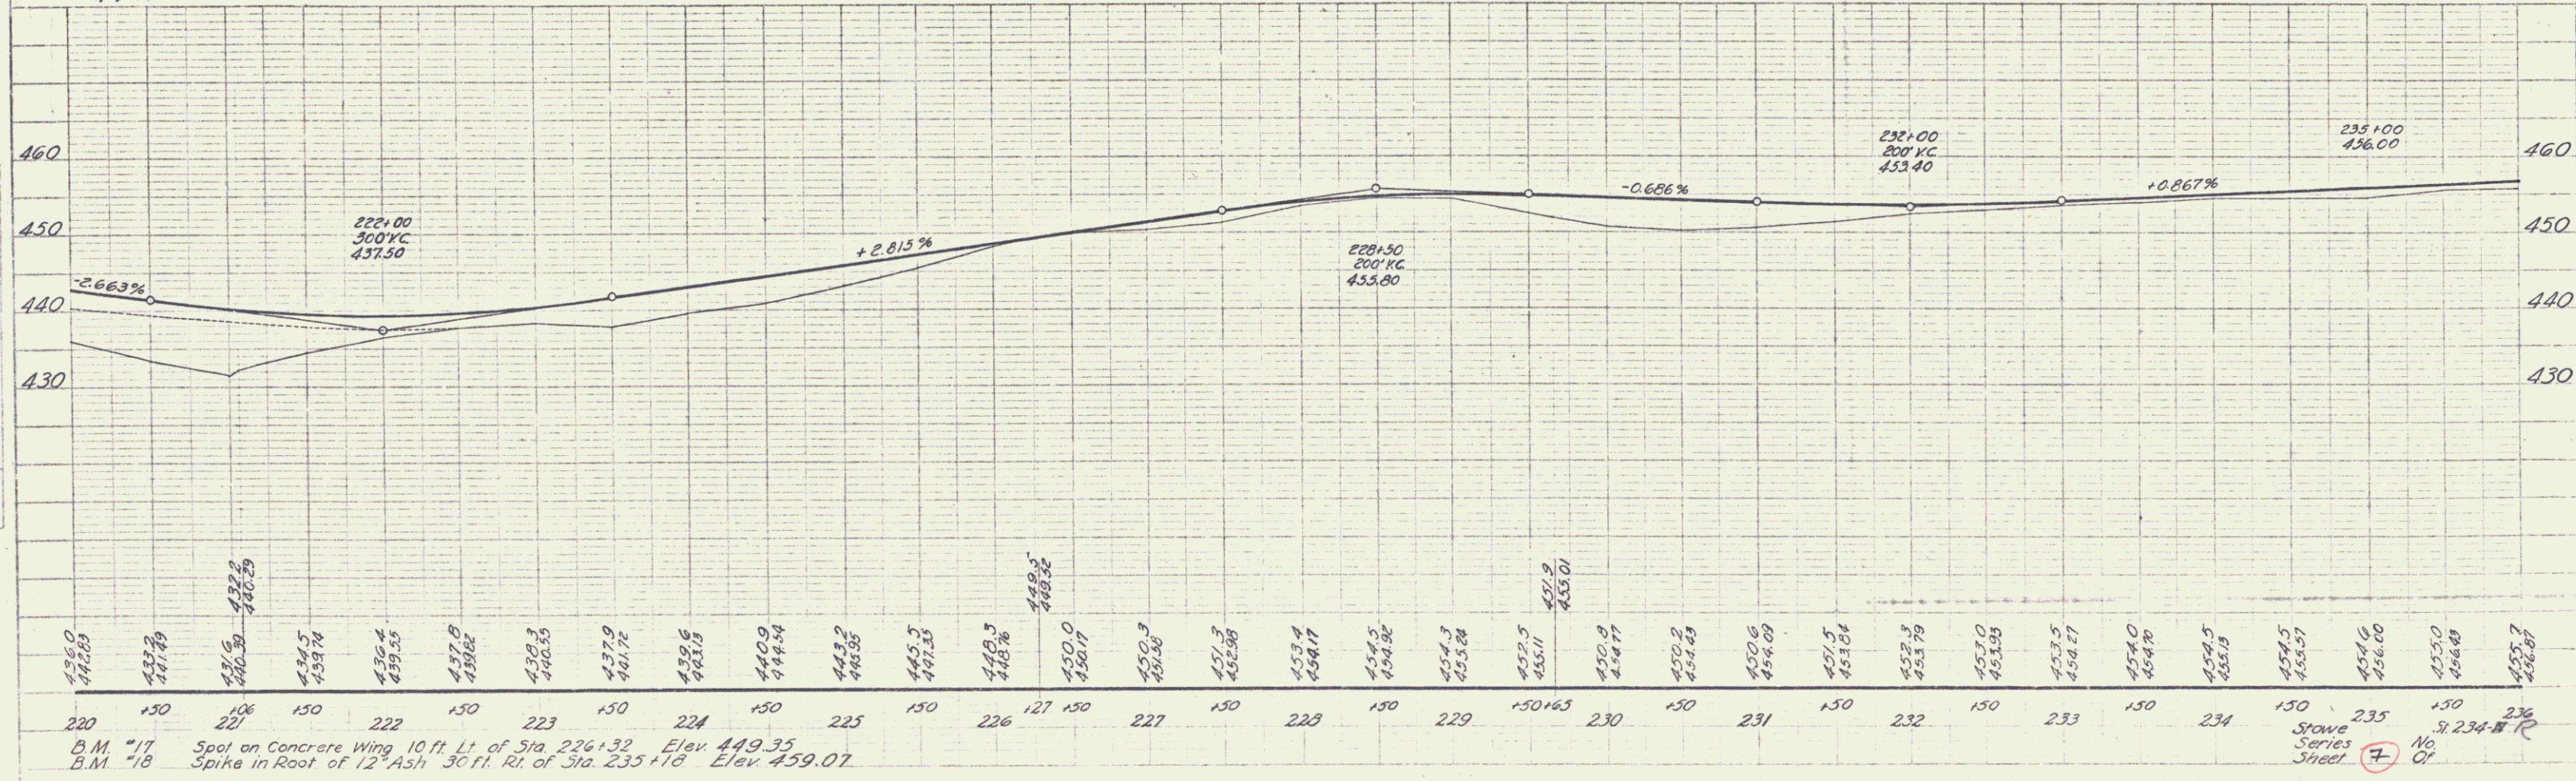


DATE	
BY	
CHECKED	
APPROVED	
SCALE	
PROJECT	
DESCRIPTION	
DATE	

DATE	
BY	
CHECKED	
APPROVED	
SCALE	
PROJECT	
DESCRIPTION	
DATE	

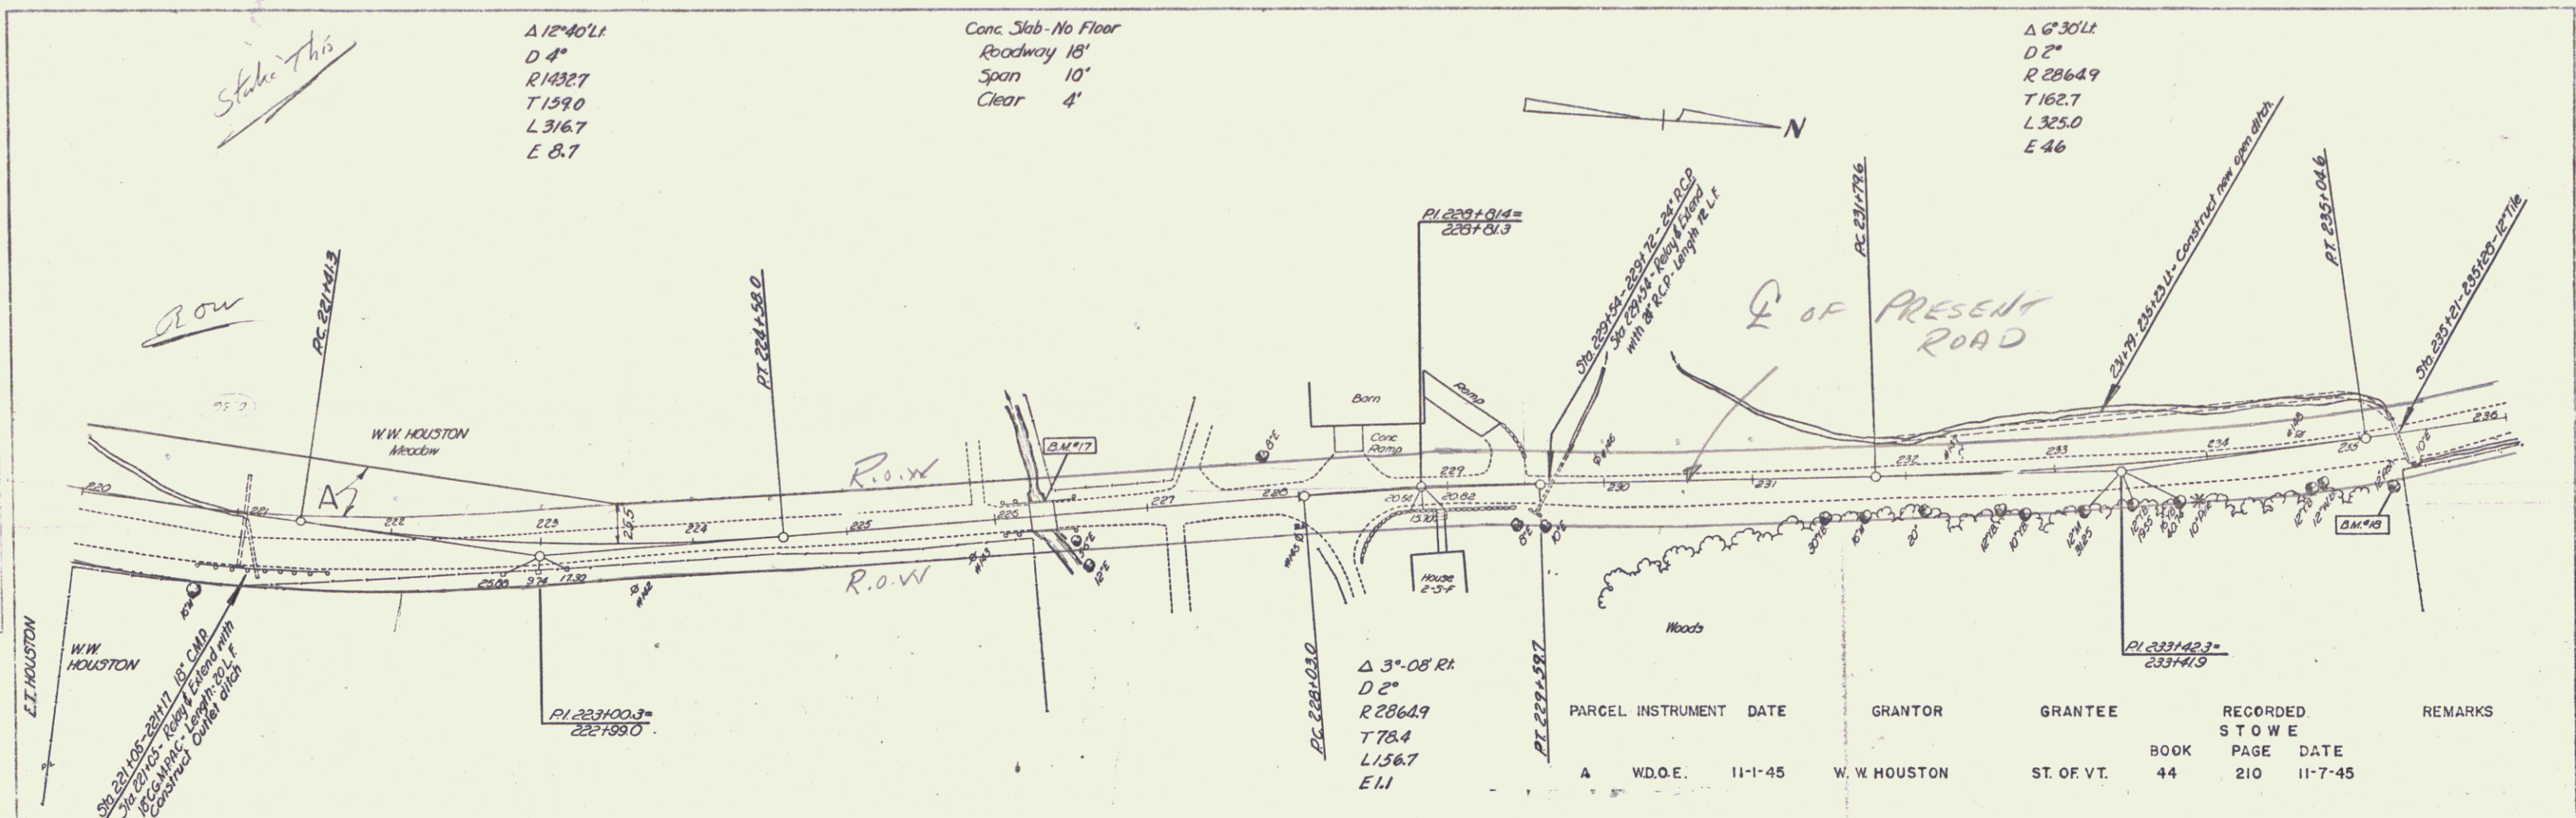

B.M. #17 Spike on Concrete Wing 10 ft Lt. of Sta. 226+32 Elev 449.35
 B.M. #18 Spike in Root of 12' Ash 30 ft. Rt. of Sta. 235+16 Elev 459.07

Stowe Series Sheet 7 of 7
 No. 234-11-C