
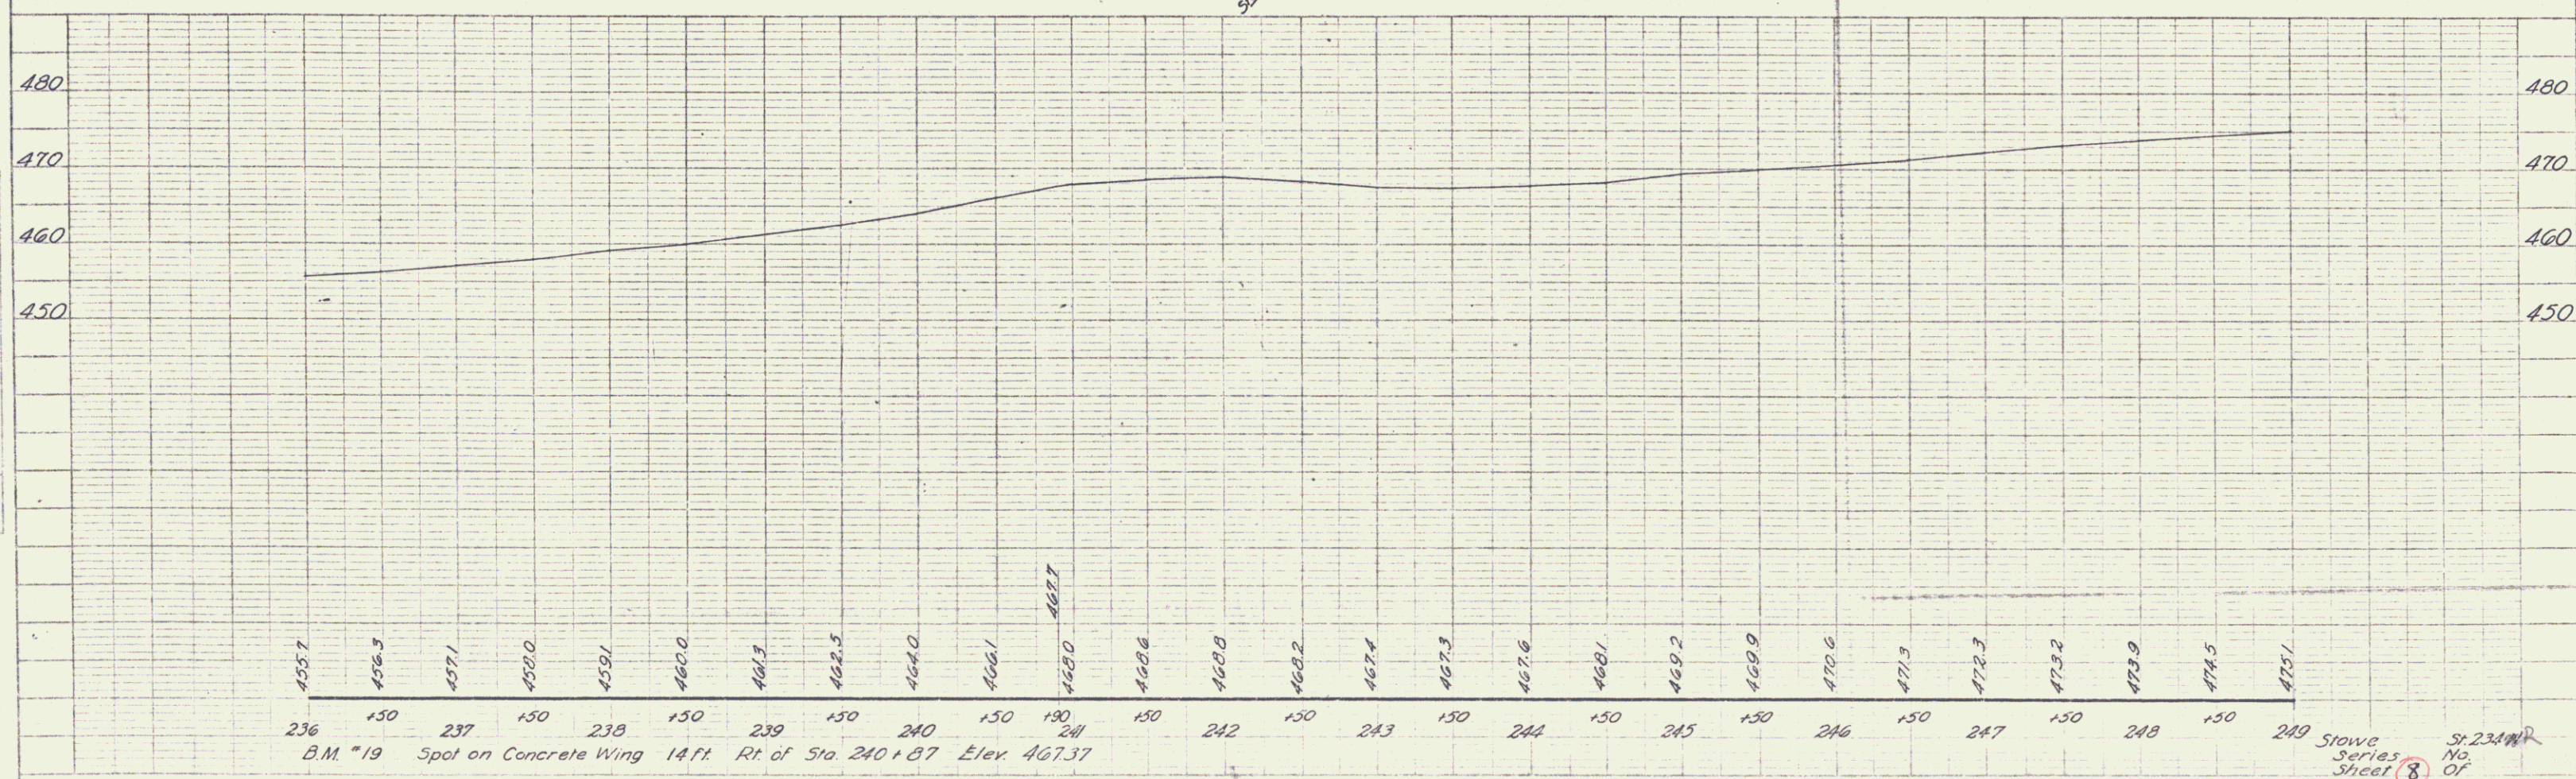


PLAN  
 STATIONING  
 46+00  
 50+00

PLAN  
 STATIONING  
 46+00  
 50+00

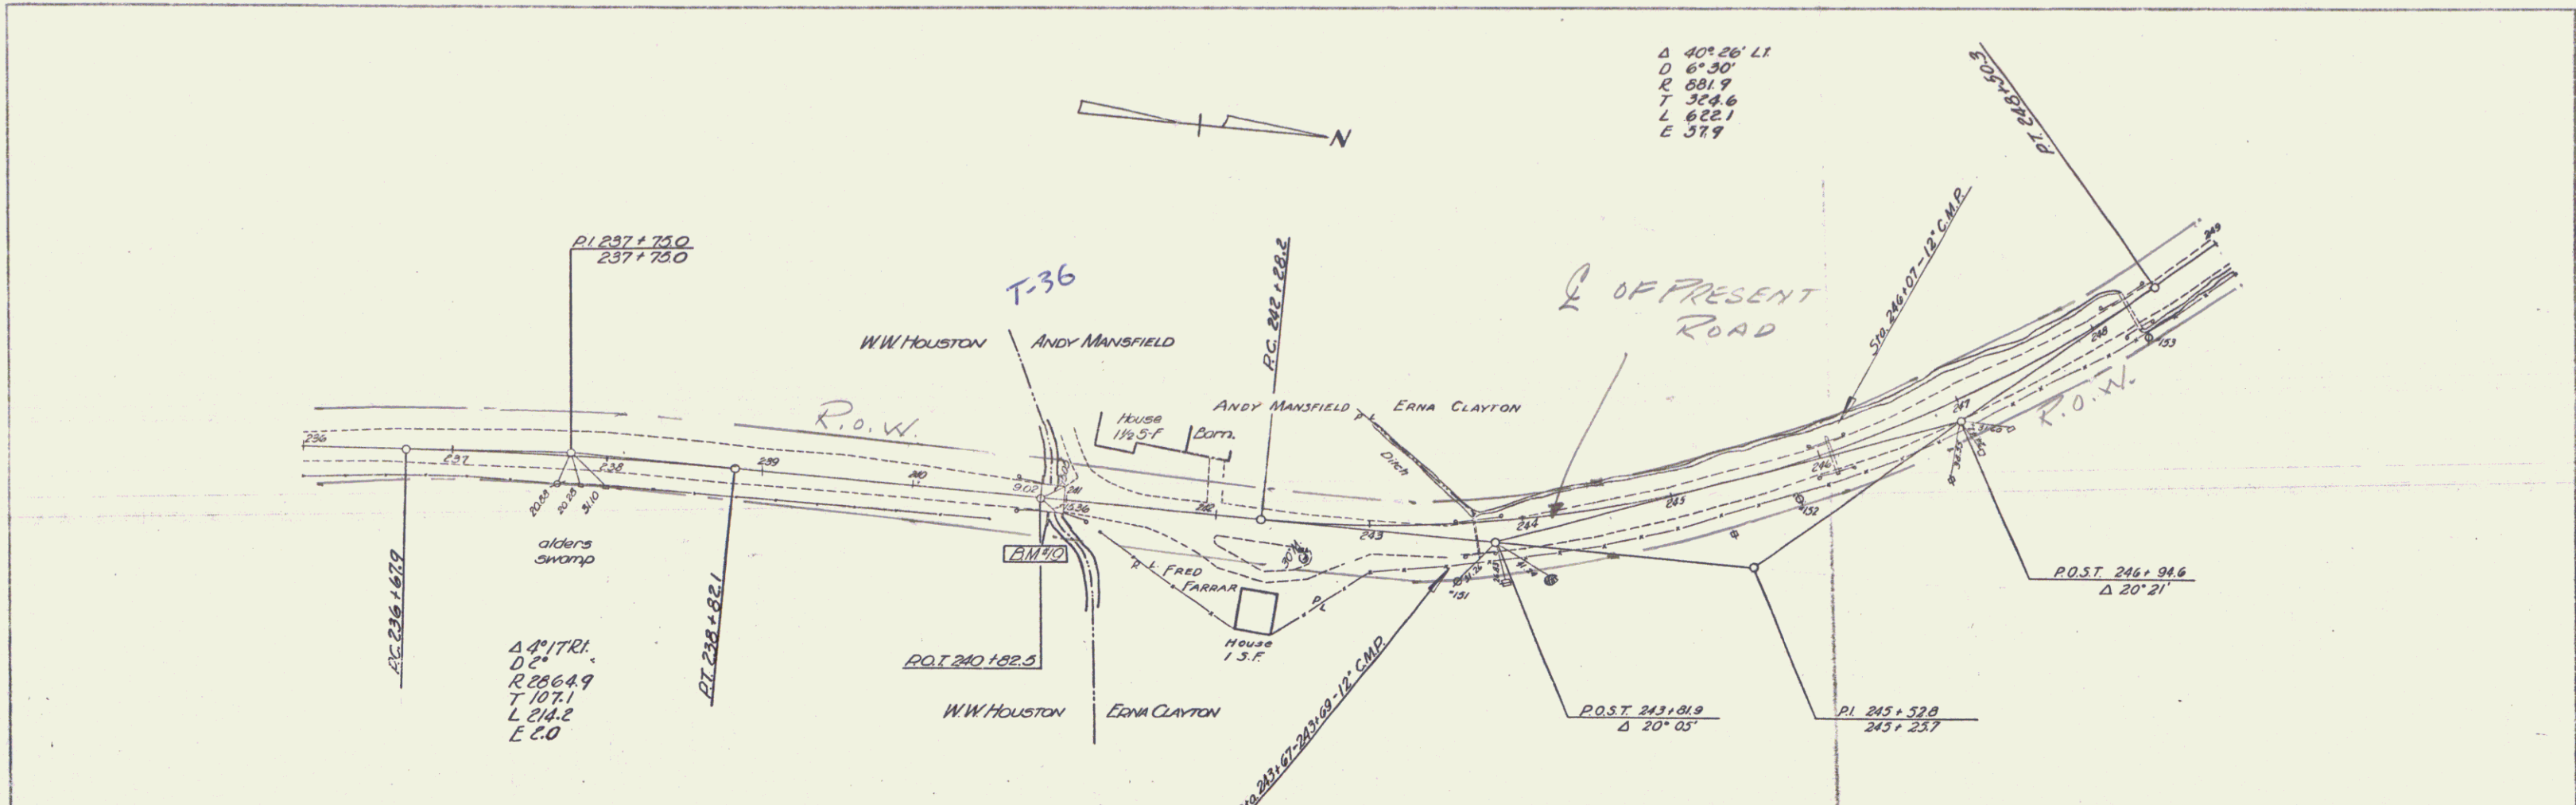

Stowe Series  
 Sheet 8  
 No. 8  
 Of 8

9