

DATE: 5-29-59
 DRAWN BY: J. J. [unclear]
 CHECKED BY: [unclear]
 SCALE: 1" = 40'

DATE: 5-29-59
 DRAWN BY: J. J. [unclear]
 CHECKED BY: [unclear]
 SCALE: 1" = 40'

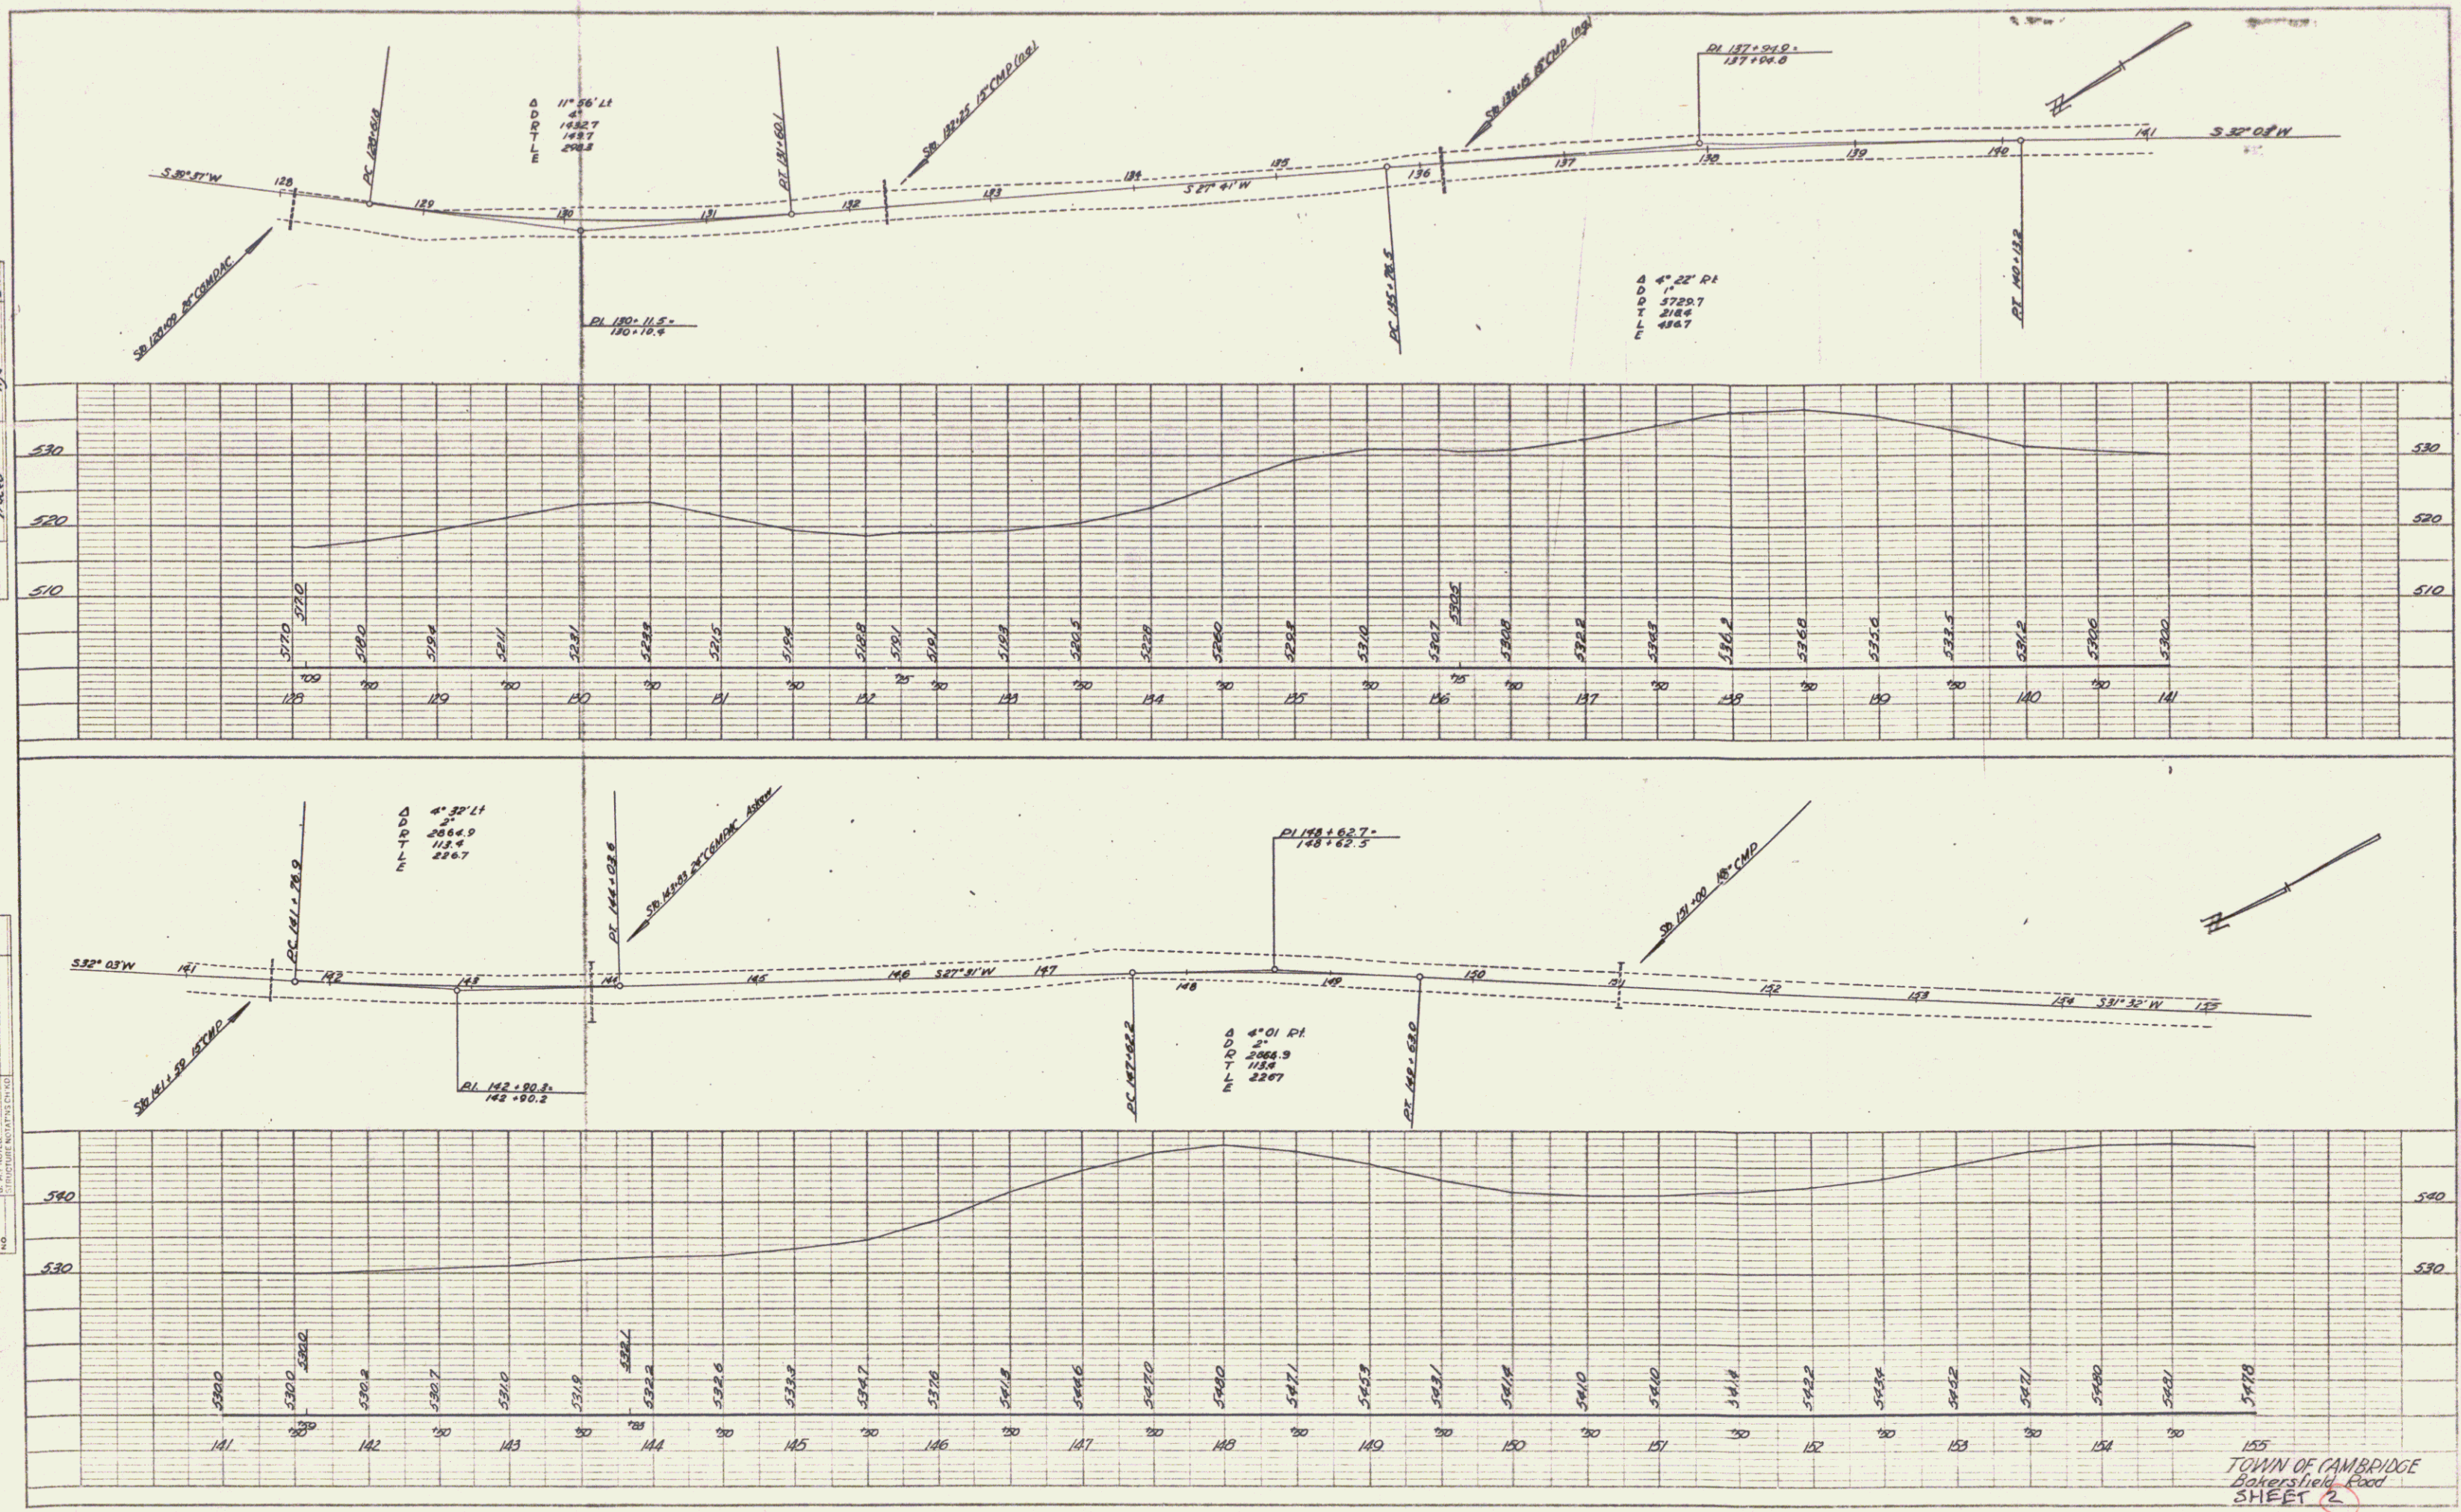


PLATE 2 PLAN PROFILE OF BAKER ROAD
 TOWN OF CAMBRIDGE
 SHEET 2

155
 TOWN OF CAMBRIDGE
 Baker Road
 SHEET 2