


DATE: 5-49
 DRAWN BY: D. J. O'NEILL
 CHECKED BY: J. J. O'NEILL
 PLAN NO.: 5-49

DATE: 6-49
 DRAWN BY: D. J. O'NEILL
 CHECKED BY: J. J. O'NEILL
 PROFILE NO.: 5-49

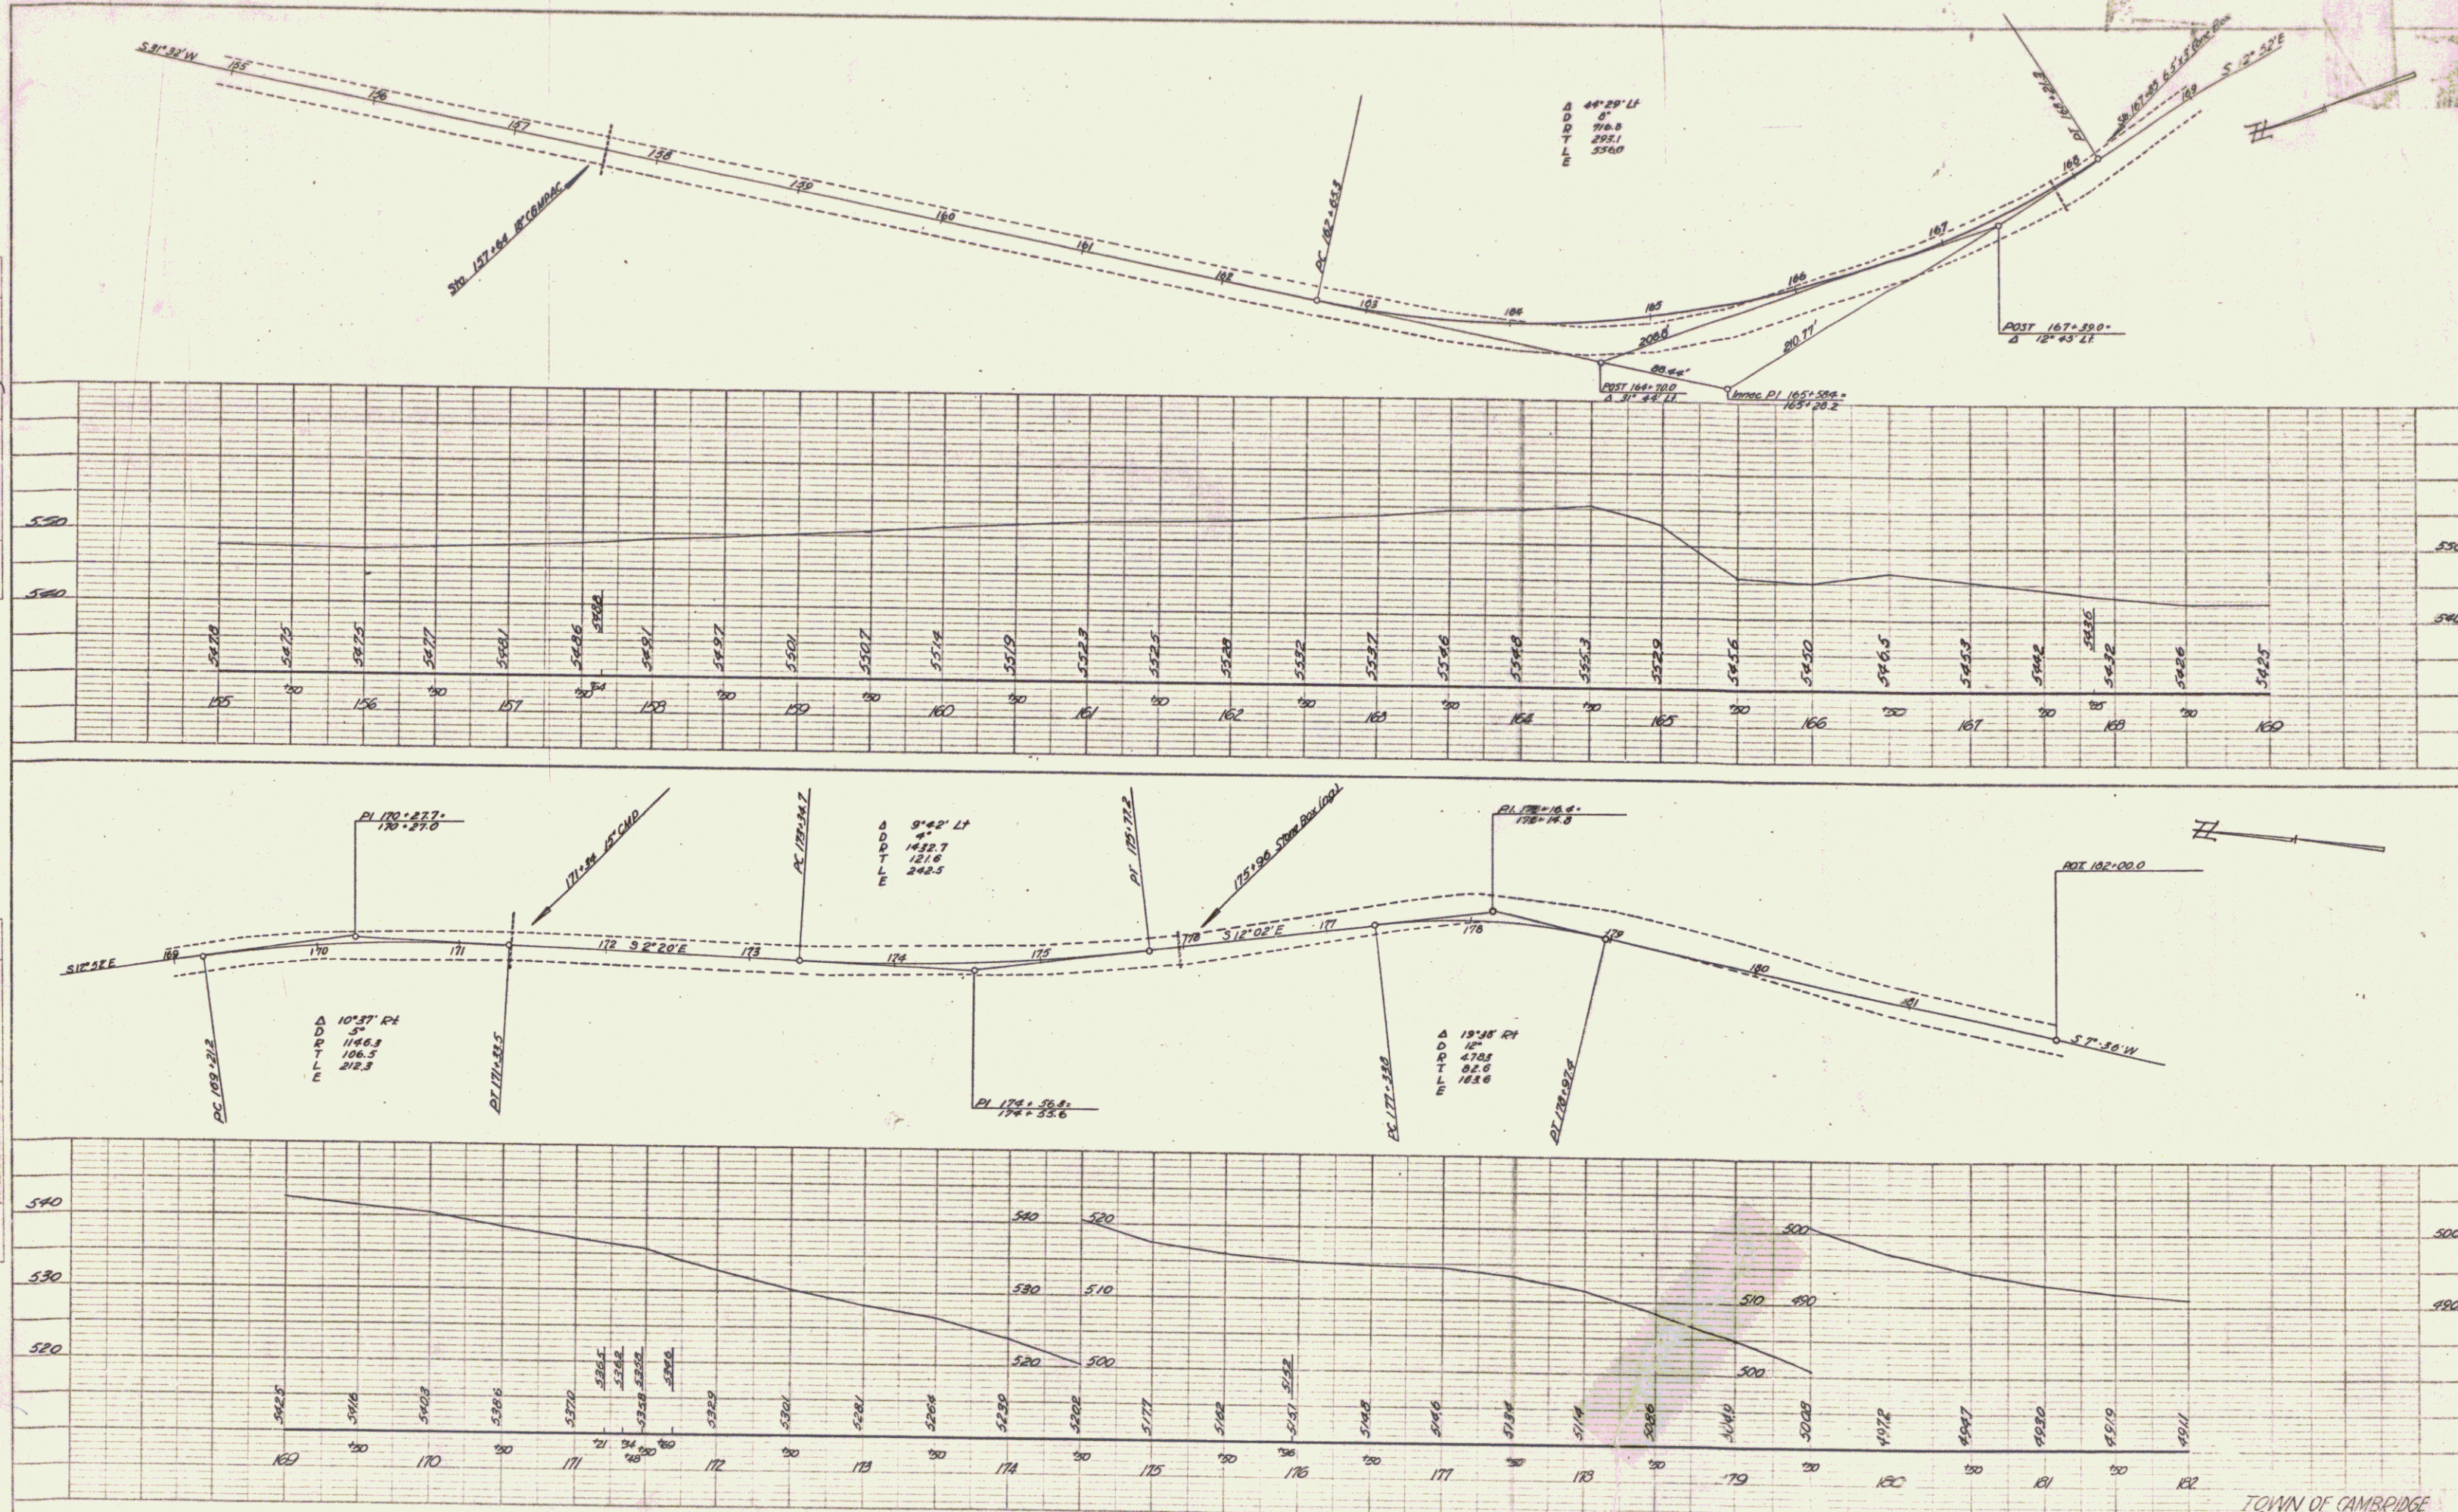

TOWN OF CAMBRIDGE
 Bowersfield Road
 SHEET 3