



Note: Scales
 Plan 1" = 50'
 Profile Hor. 1" = 50'
 Vert. 1" = 10'
 Cross Sections 1" = 5'

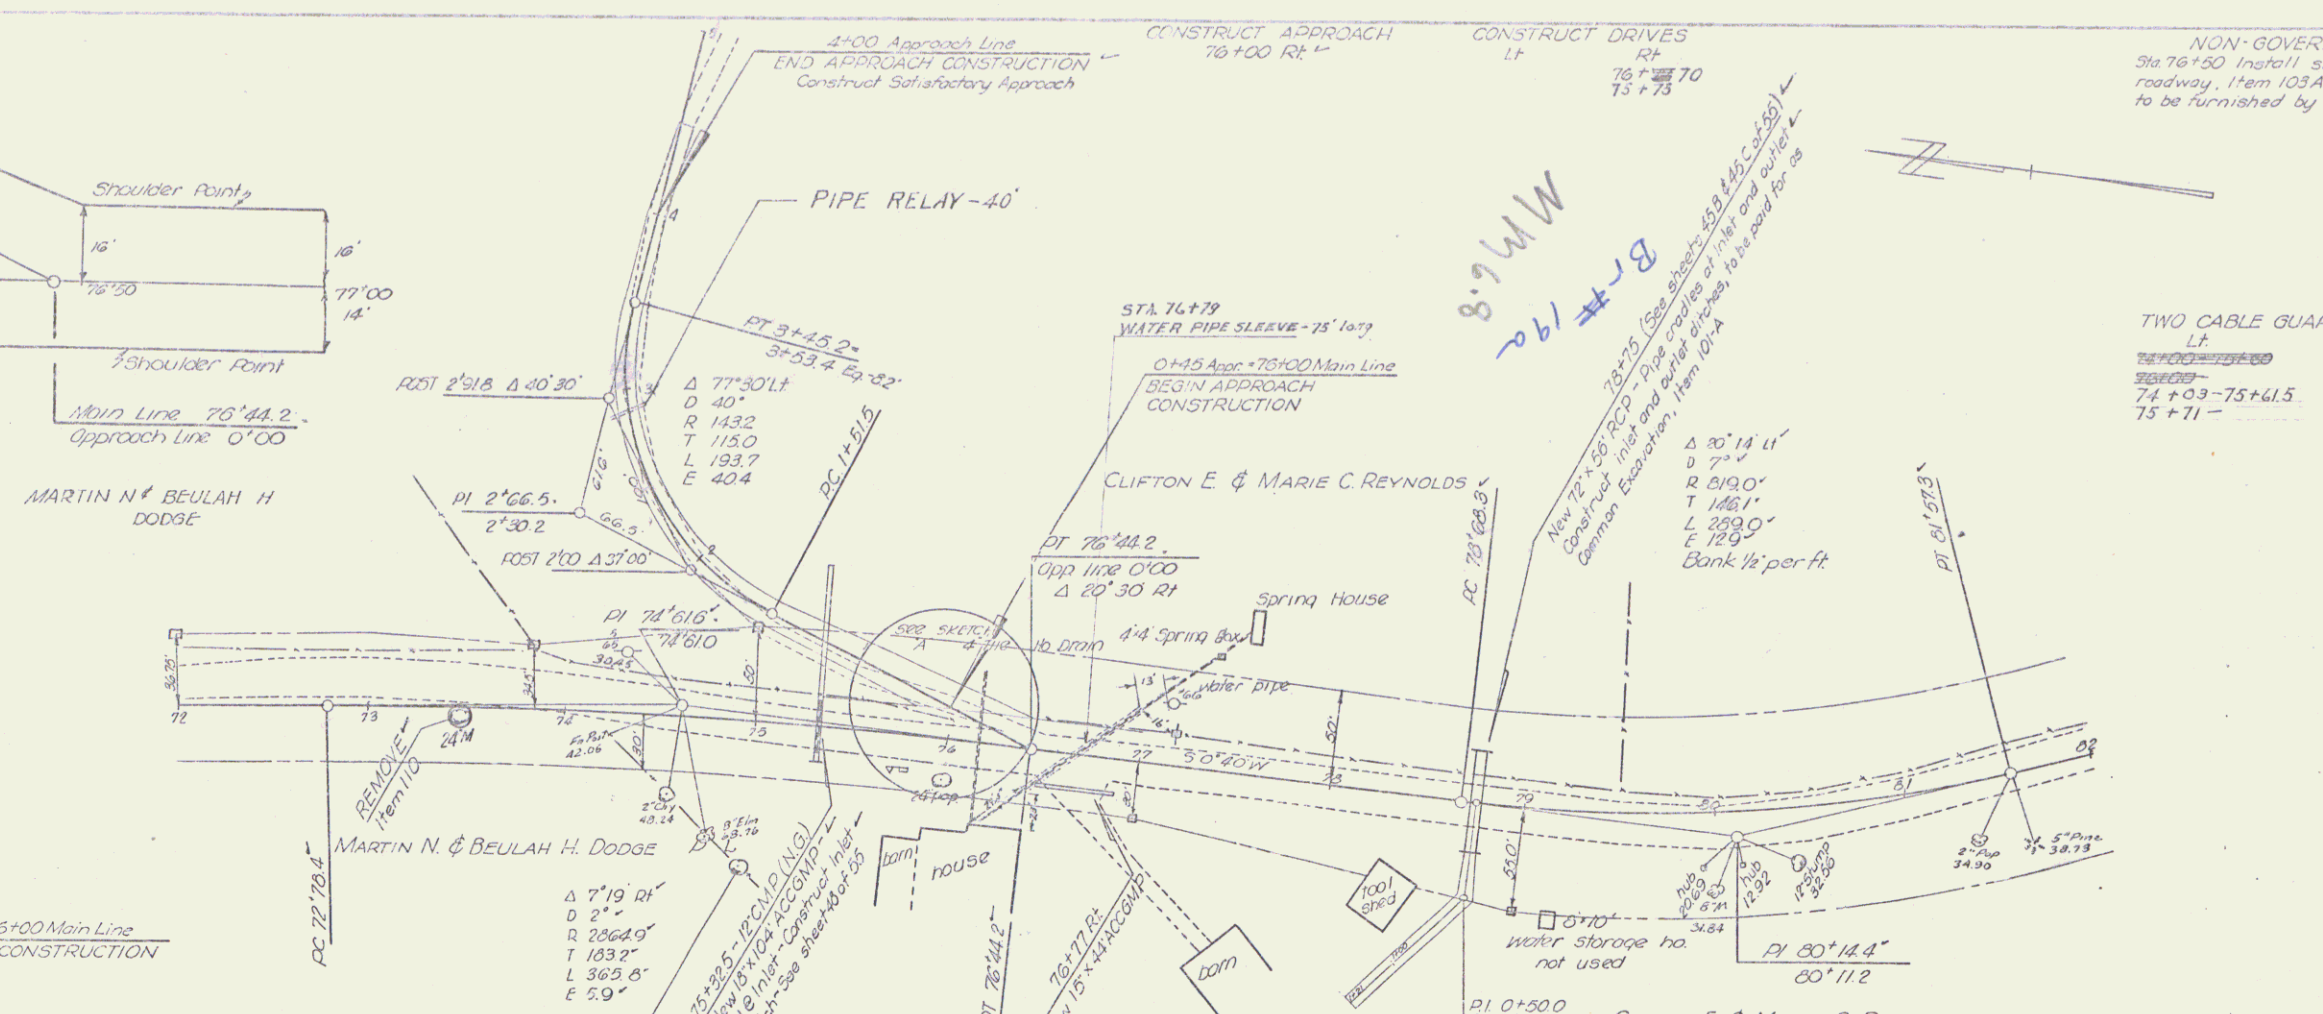

NON-GOVERNMENT PARTICIPATION
 Sta 76+50 Install sleeve for water pipe across roadway. Item 105A & 105B, Non gov't Sleeve to be furnished by property owner.

TWO CABLE GUARD RAIL
 Lt. 74+03-75+61.5
 Rt. 75+71-

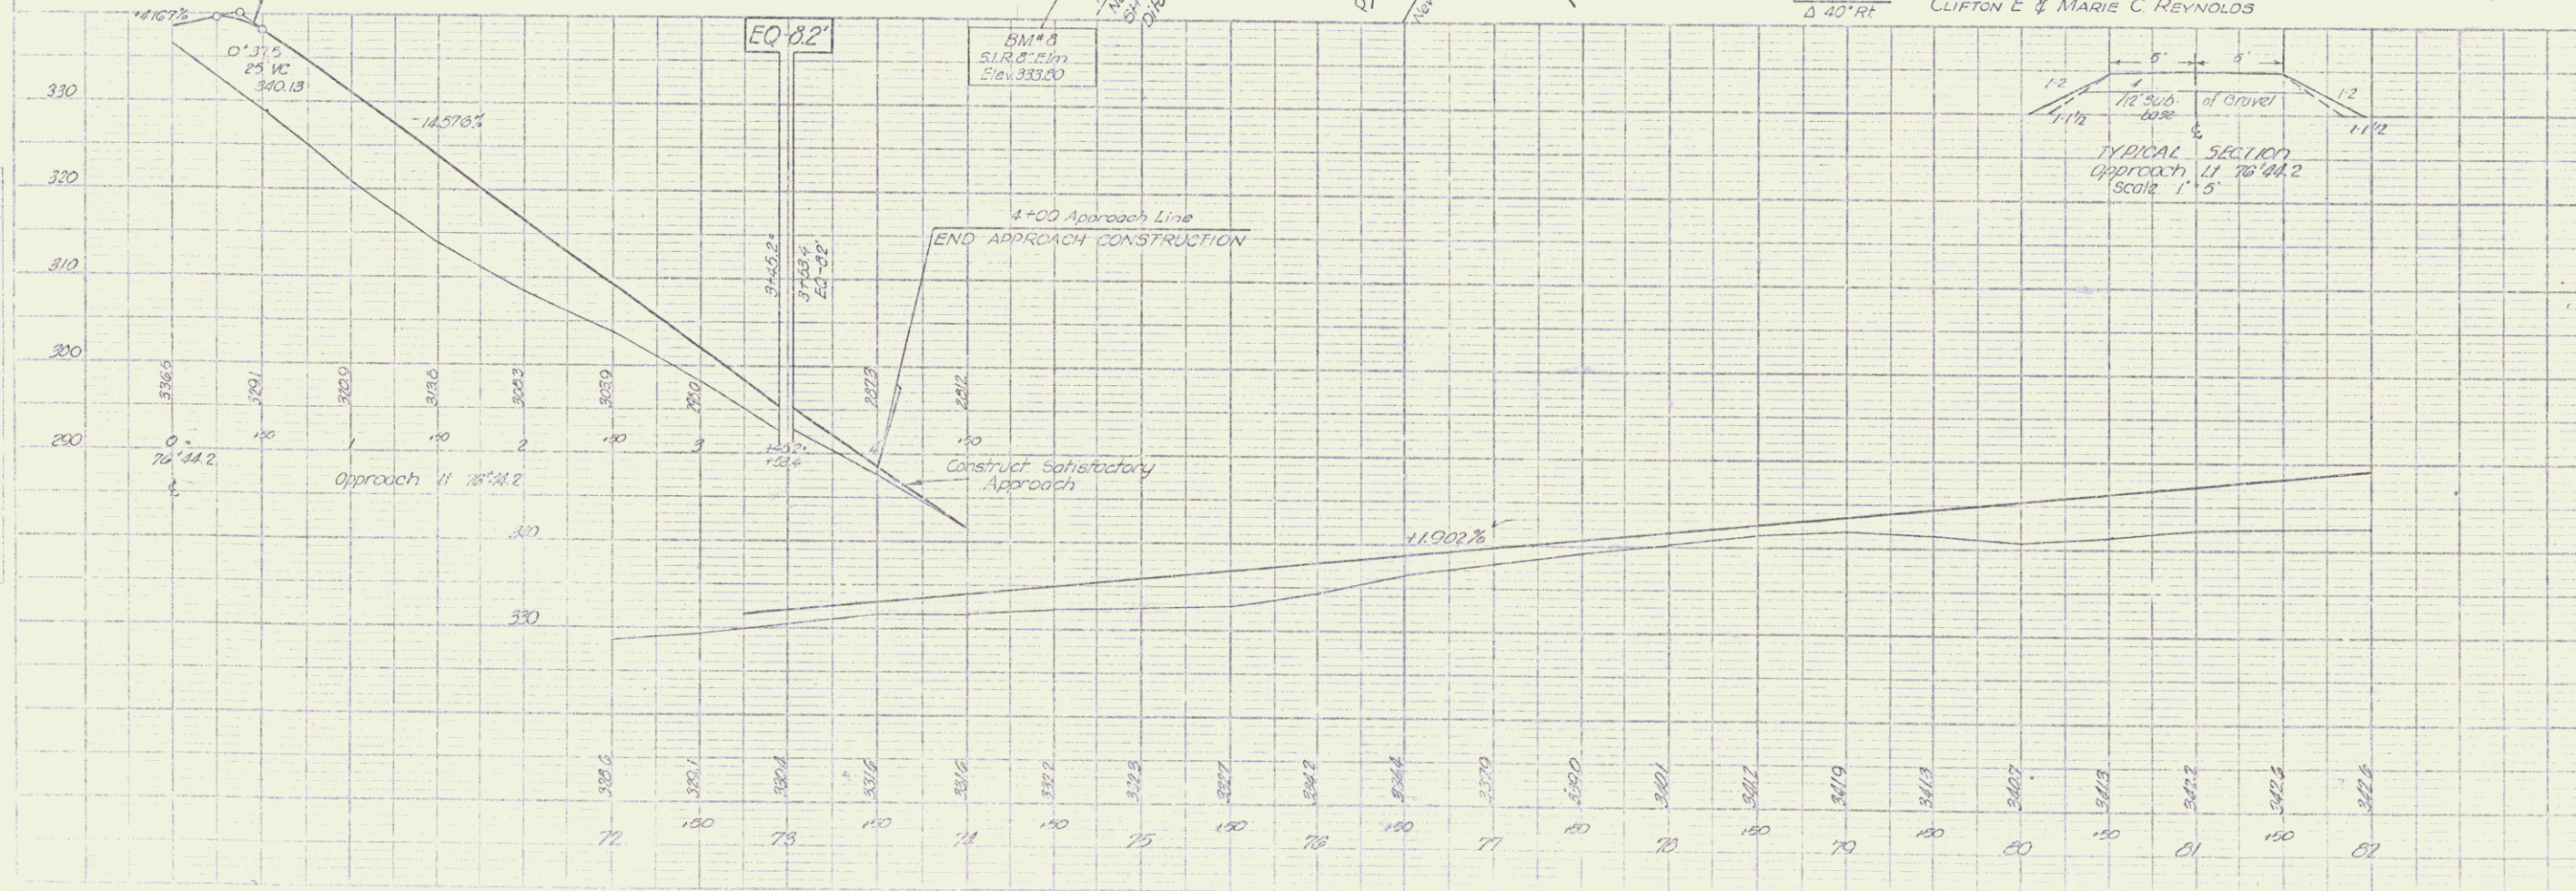

CAMBRIDGE S 234 (1)
 Proj. S 10 33470
 Sheet 3A of 55