

DATE	7/83
BY	JM
CHECKED	JM
IN CHARGE	JM
PROJECT	JEFFERSONVILLE VILLAGE
NO.	108
DATE	7/83

DATE	7/83
BY	JM
CHECKED	JM
IN CHARGE	JM
PROJECT	JEFFERSONVILLE VILLAGE
NO.	108
DATE	7/83

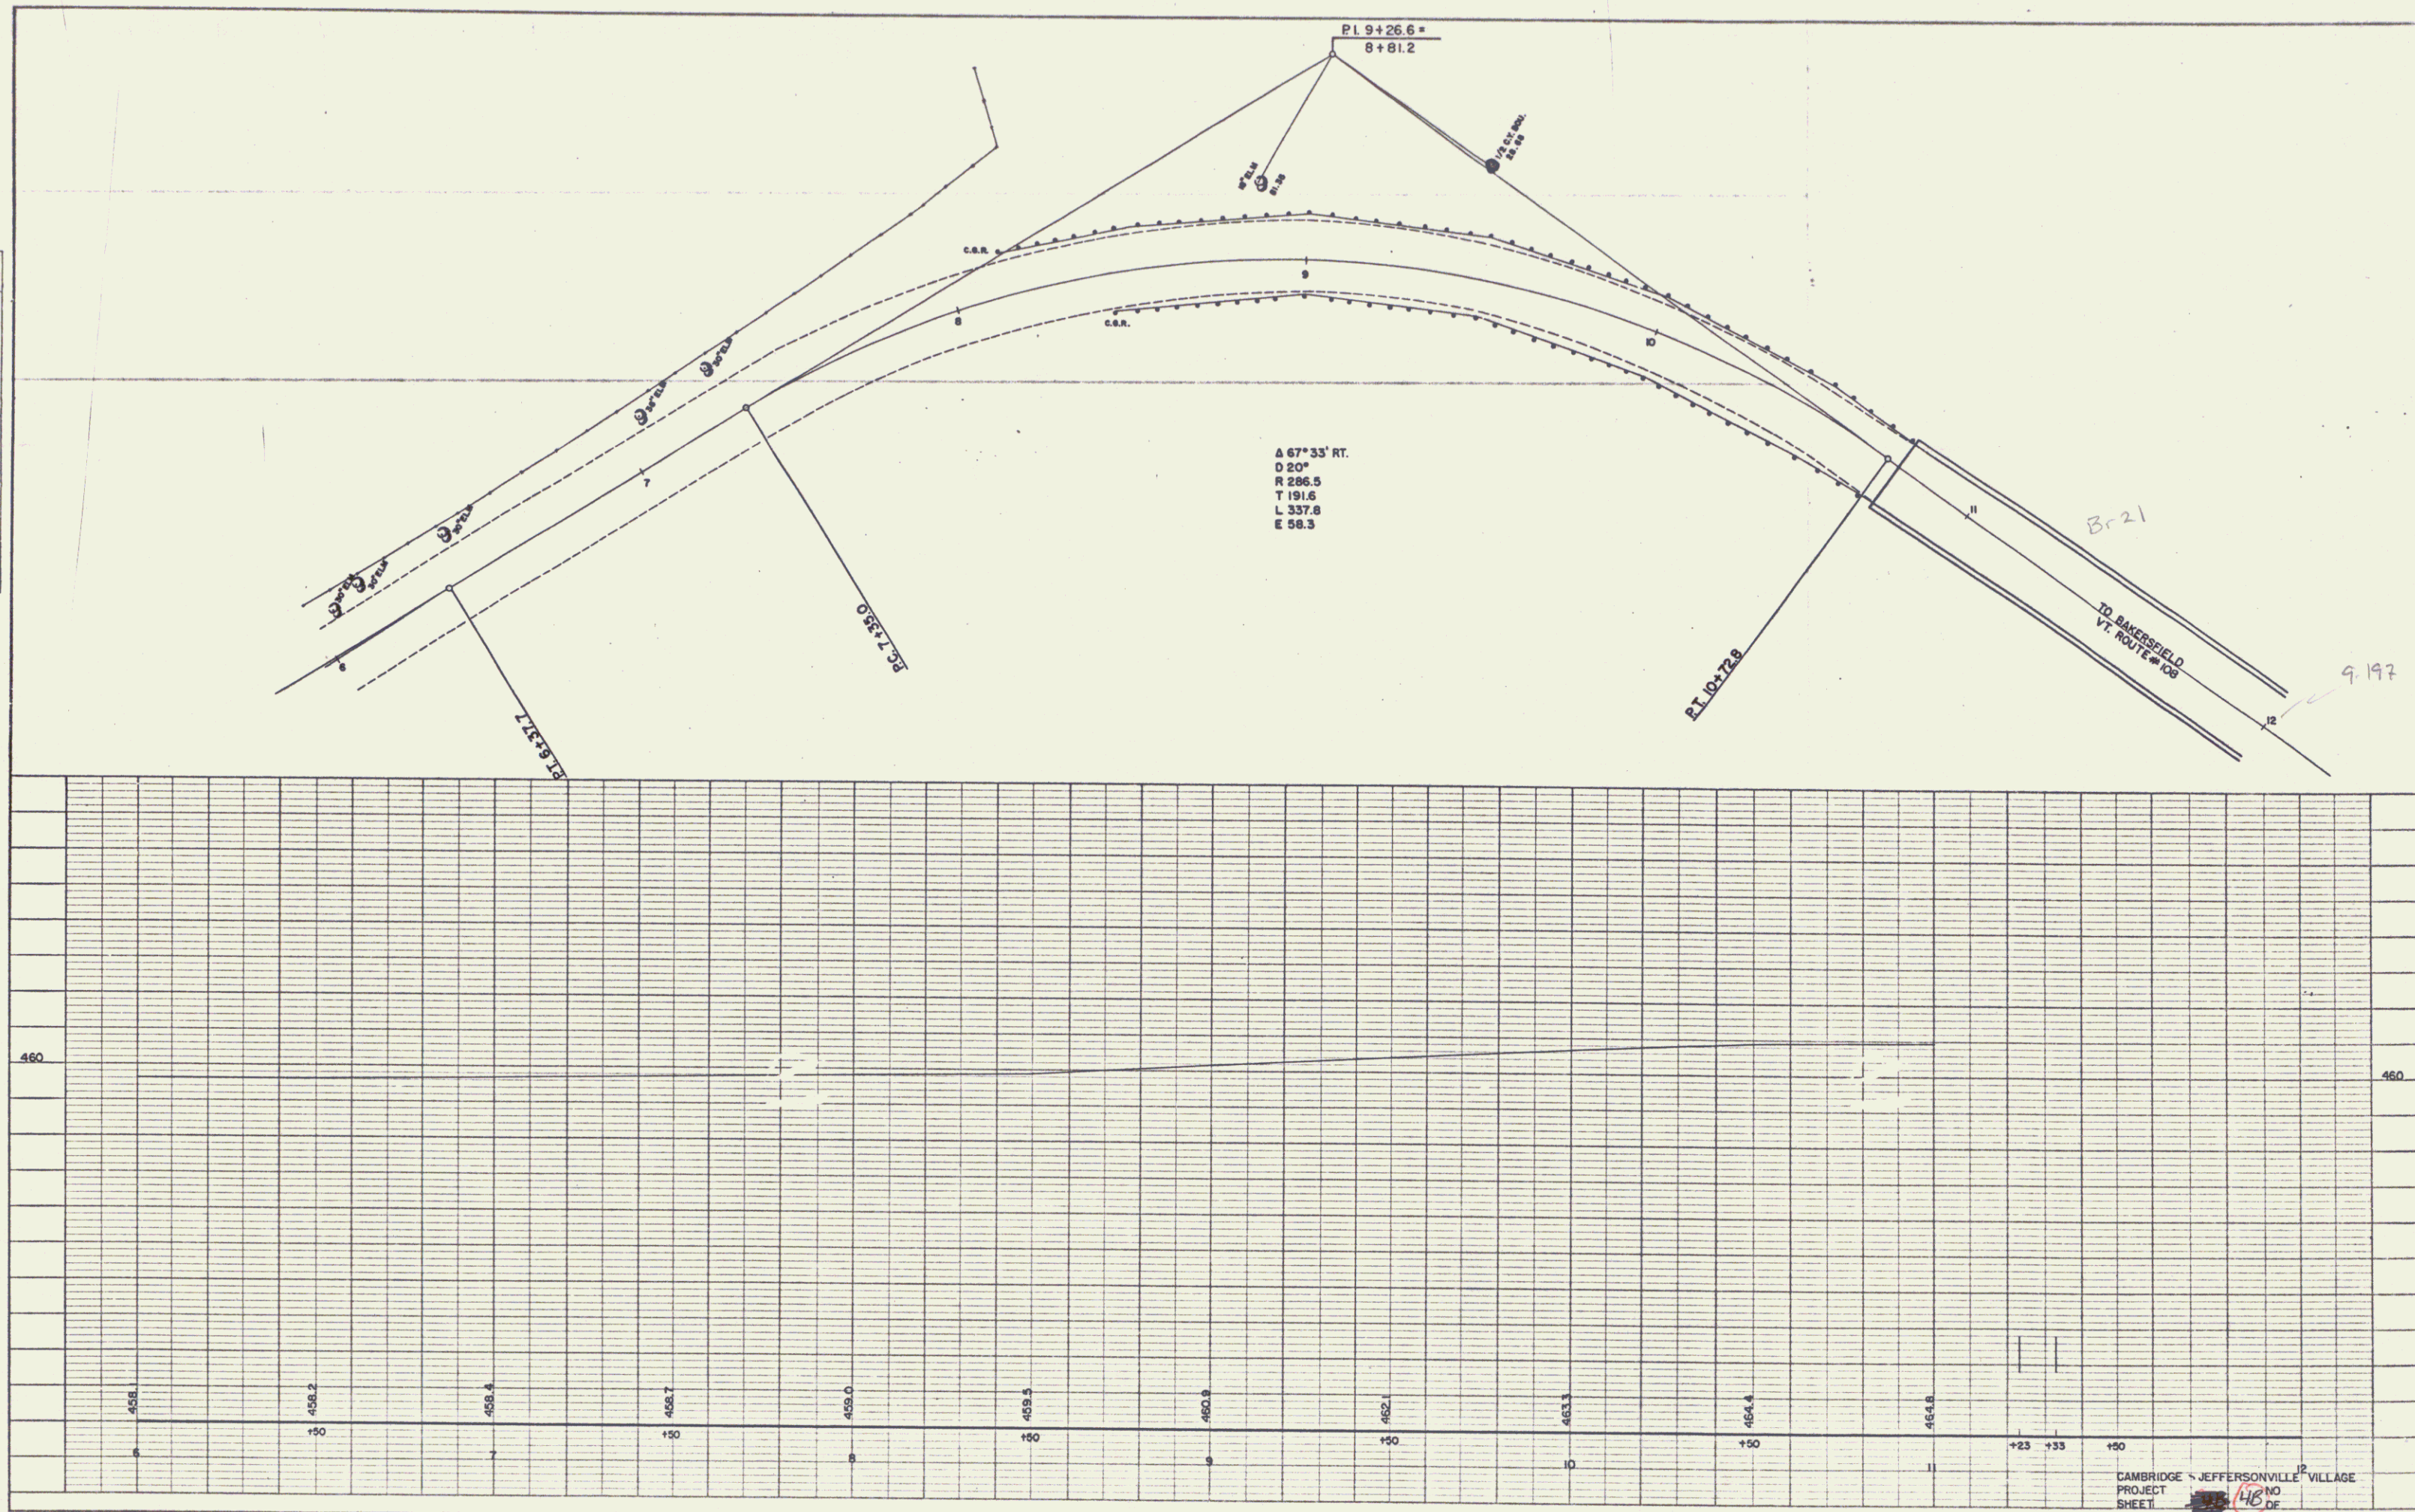


PLATE 1 - PLAN-PROFILE  
 H & E, INC. NO. 348-10  
 NEW YORK, N.Y.

CAMBRIDGE & JEFFERSONVILLE VILLAGE  
 PROJECT  
 SHEET NO. 108 OF 108

8