

PLAN		DATE	BY
PROJECT	NO.	DATE	NAME
ALLOTTED	NO.	DATE	NAME
NOTED	NO.	DATE	NAME
STRUCTURE	NO.	DATE	NAME

PROFILE		DATE	BY
PROJECT	NO.	DATE	NAME
ALLOTTED	NO.	DATE	NAME
NOTED	NO.	DATE	NAME
STRUCTURE	NO.	DATE	NAME

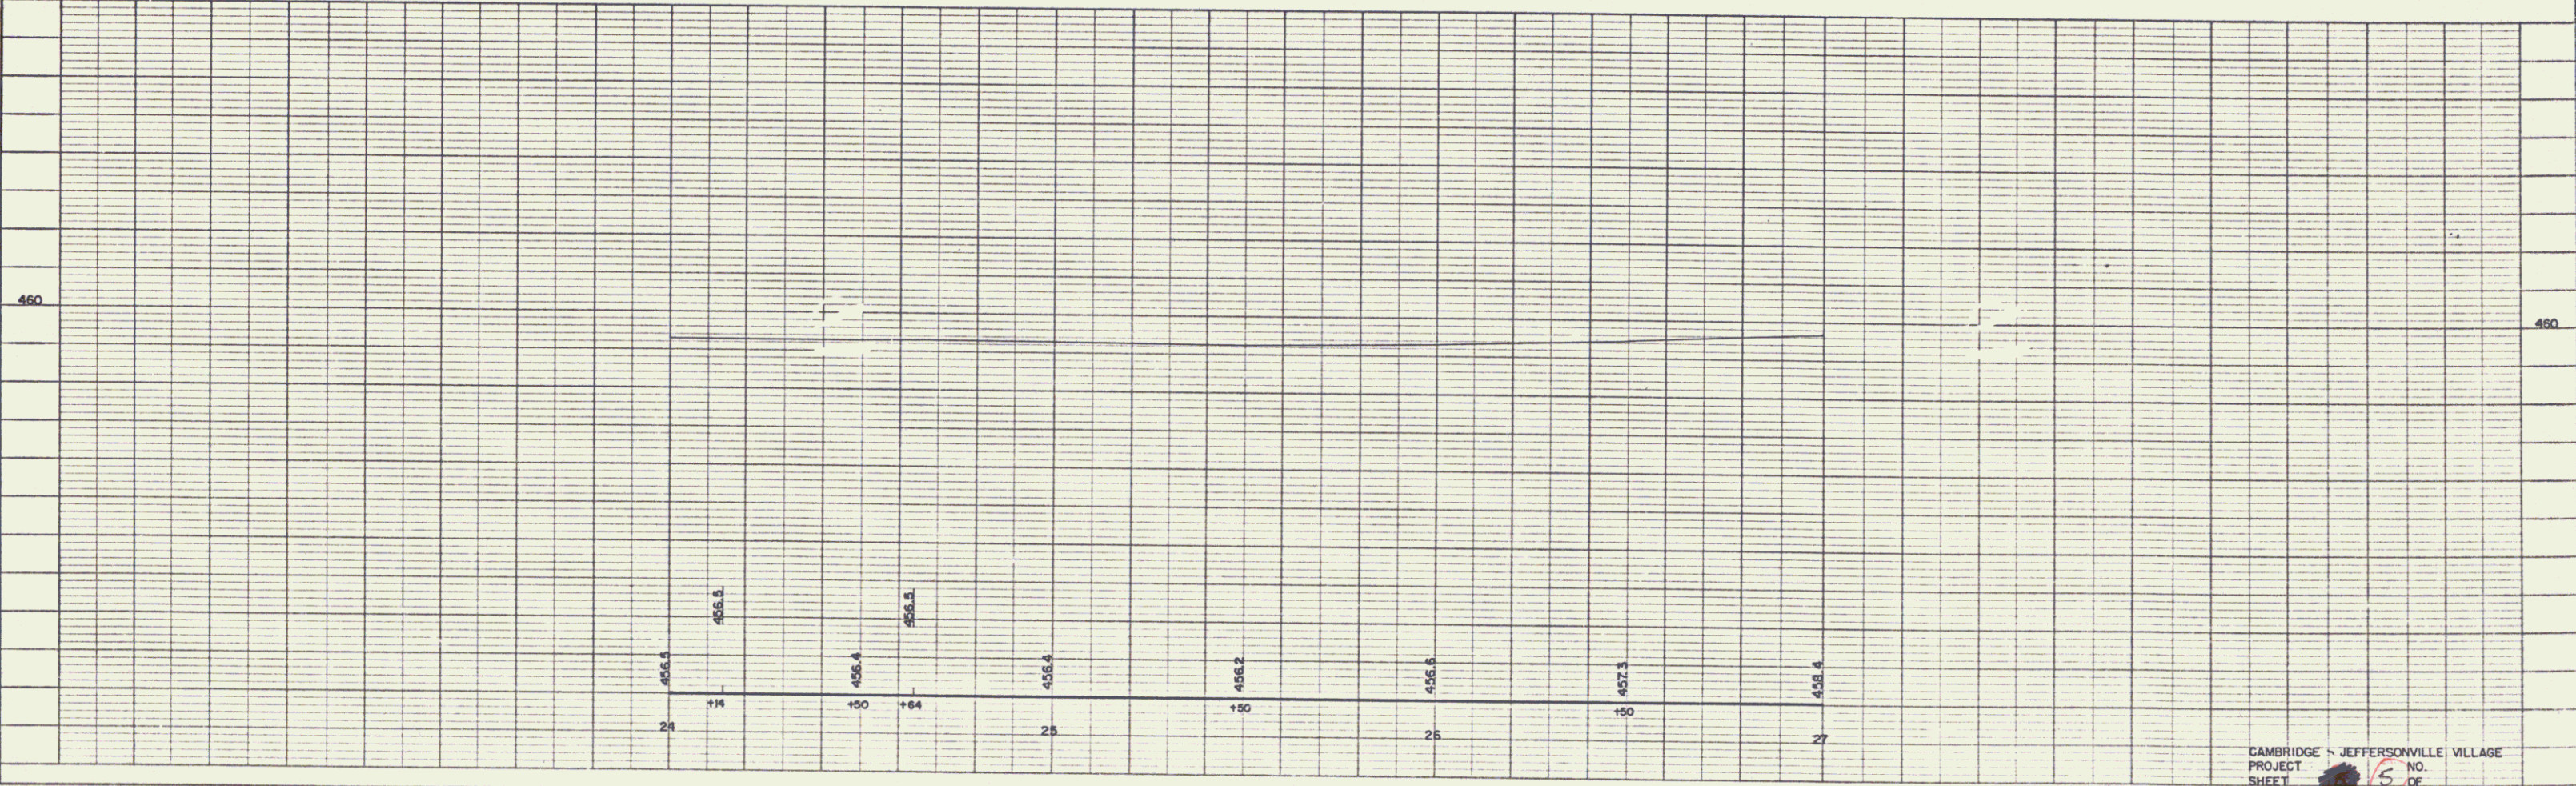
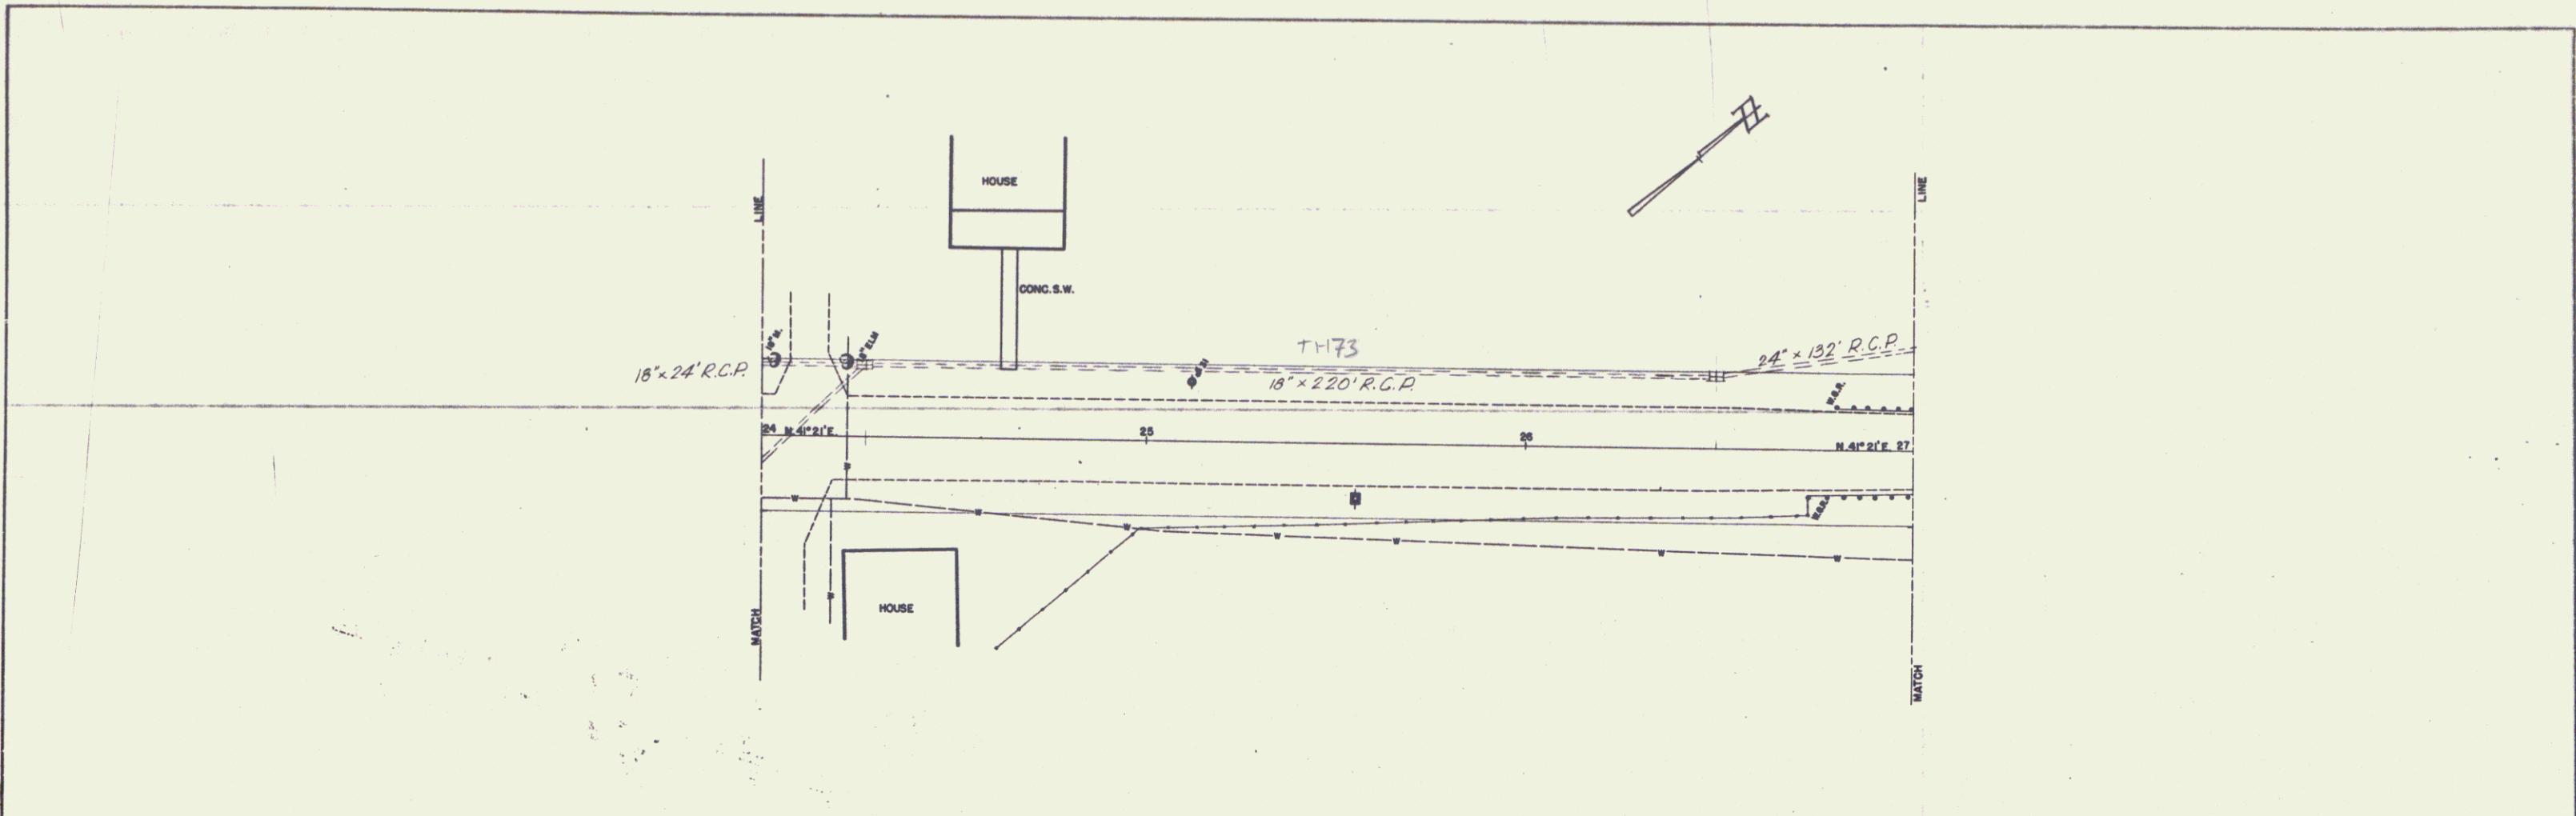


PLATE 1 - PLAN - PROFILE
 REUFF & ESMAH CO. NEW YORK
 P. E. & C. N.Y. 348-10

CAMBRIDGE - JEFFERSONVILLE VILLAGE
 PROJECT SHEET NO. 5 DE