

PLAN	DATE	BY
REVISED	7/78	JL
PLOTTED		
BY		
DATE		
BY		
DATE		
BY		
DATE		
BY		
DATE		

PROFILE	DATE	BY
REVISED	7/78	JL
PLOTTED		
BY		
DATE		
BY		
DATE		
BY		
DATE		
BY		
DATE		

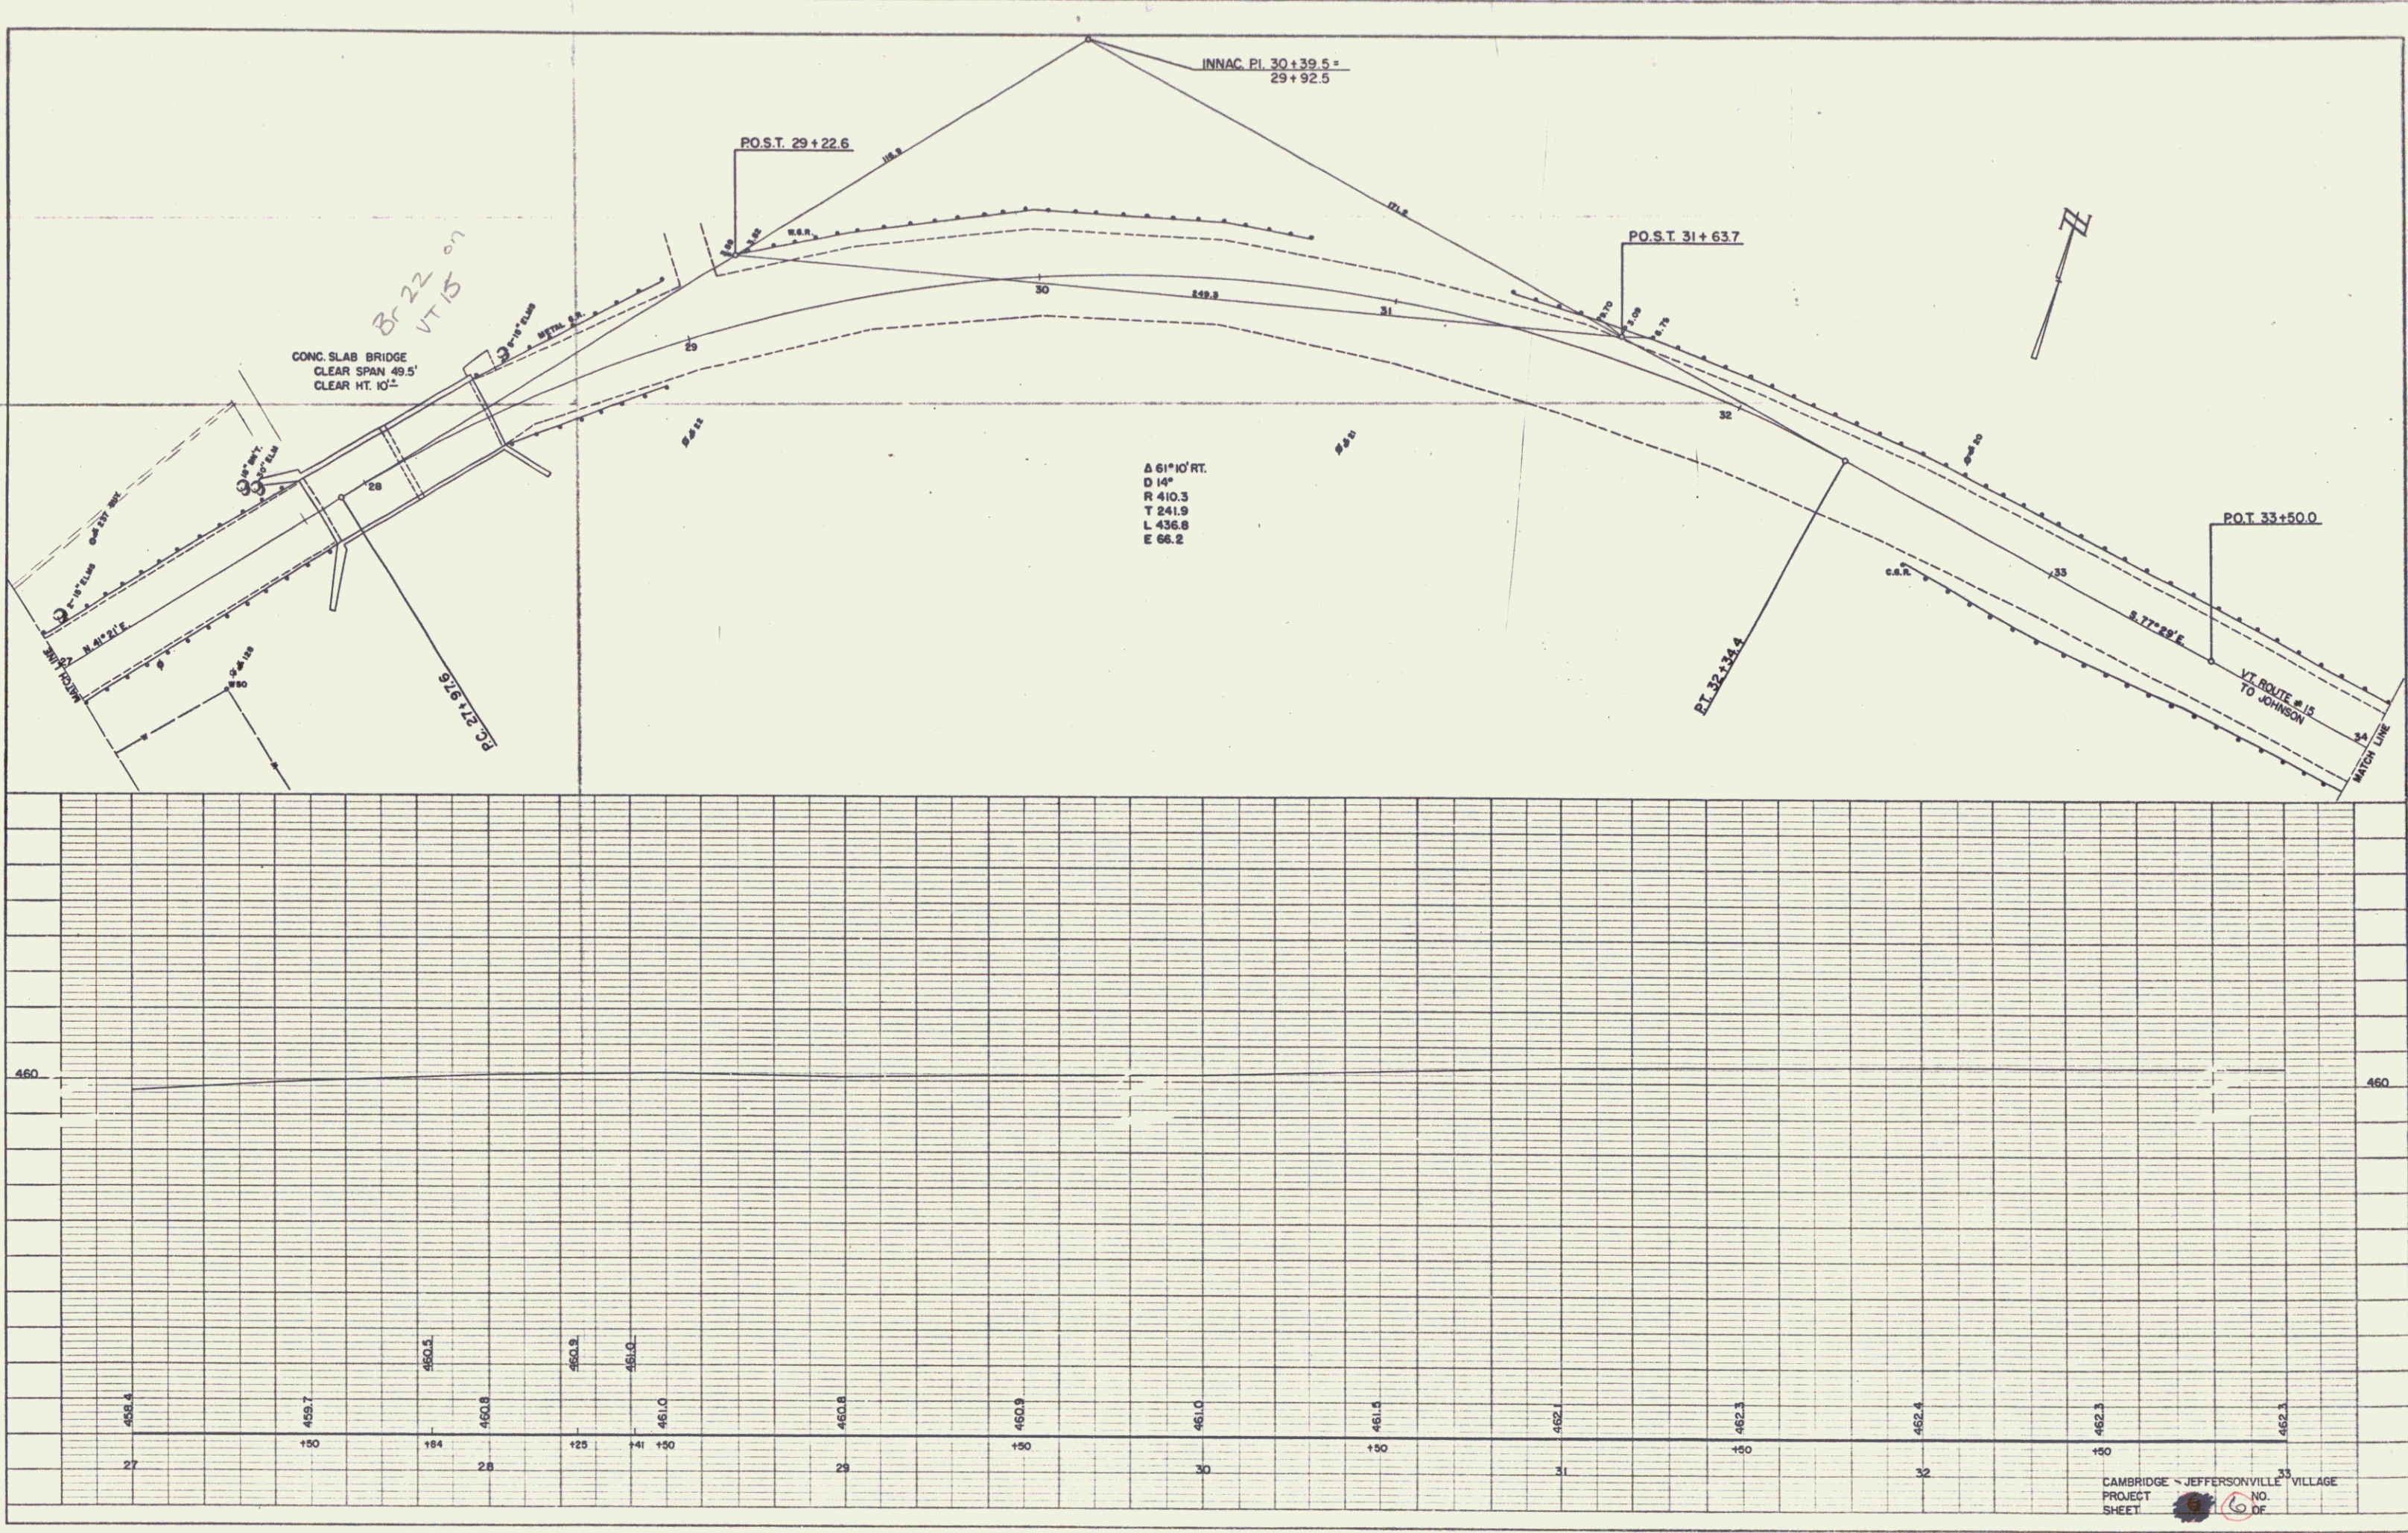


PLATE 1 - PLAN - PROFILE OF P. R. R. & B. HIGHWAY
KELLY & EIDER CO., NEW YORK
P. & E. CO. NO. 348-C

CAMBRIDGE - JEFFERSONVILLE VILLAGE
PROJECT NO. 6
SHEET 10