


THESE GRADES ARE FOR THE SUB-GRADE FINISHED GRADES TO BE 6" HIGHER.

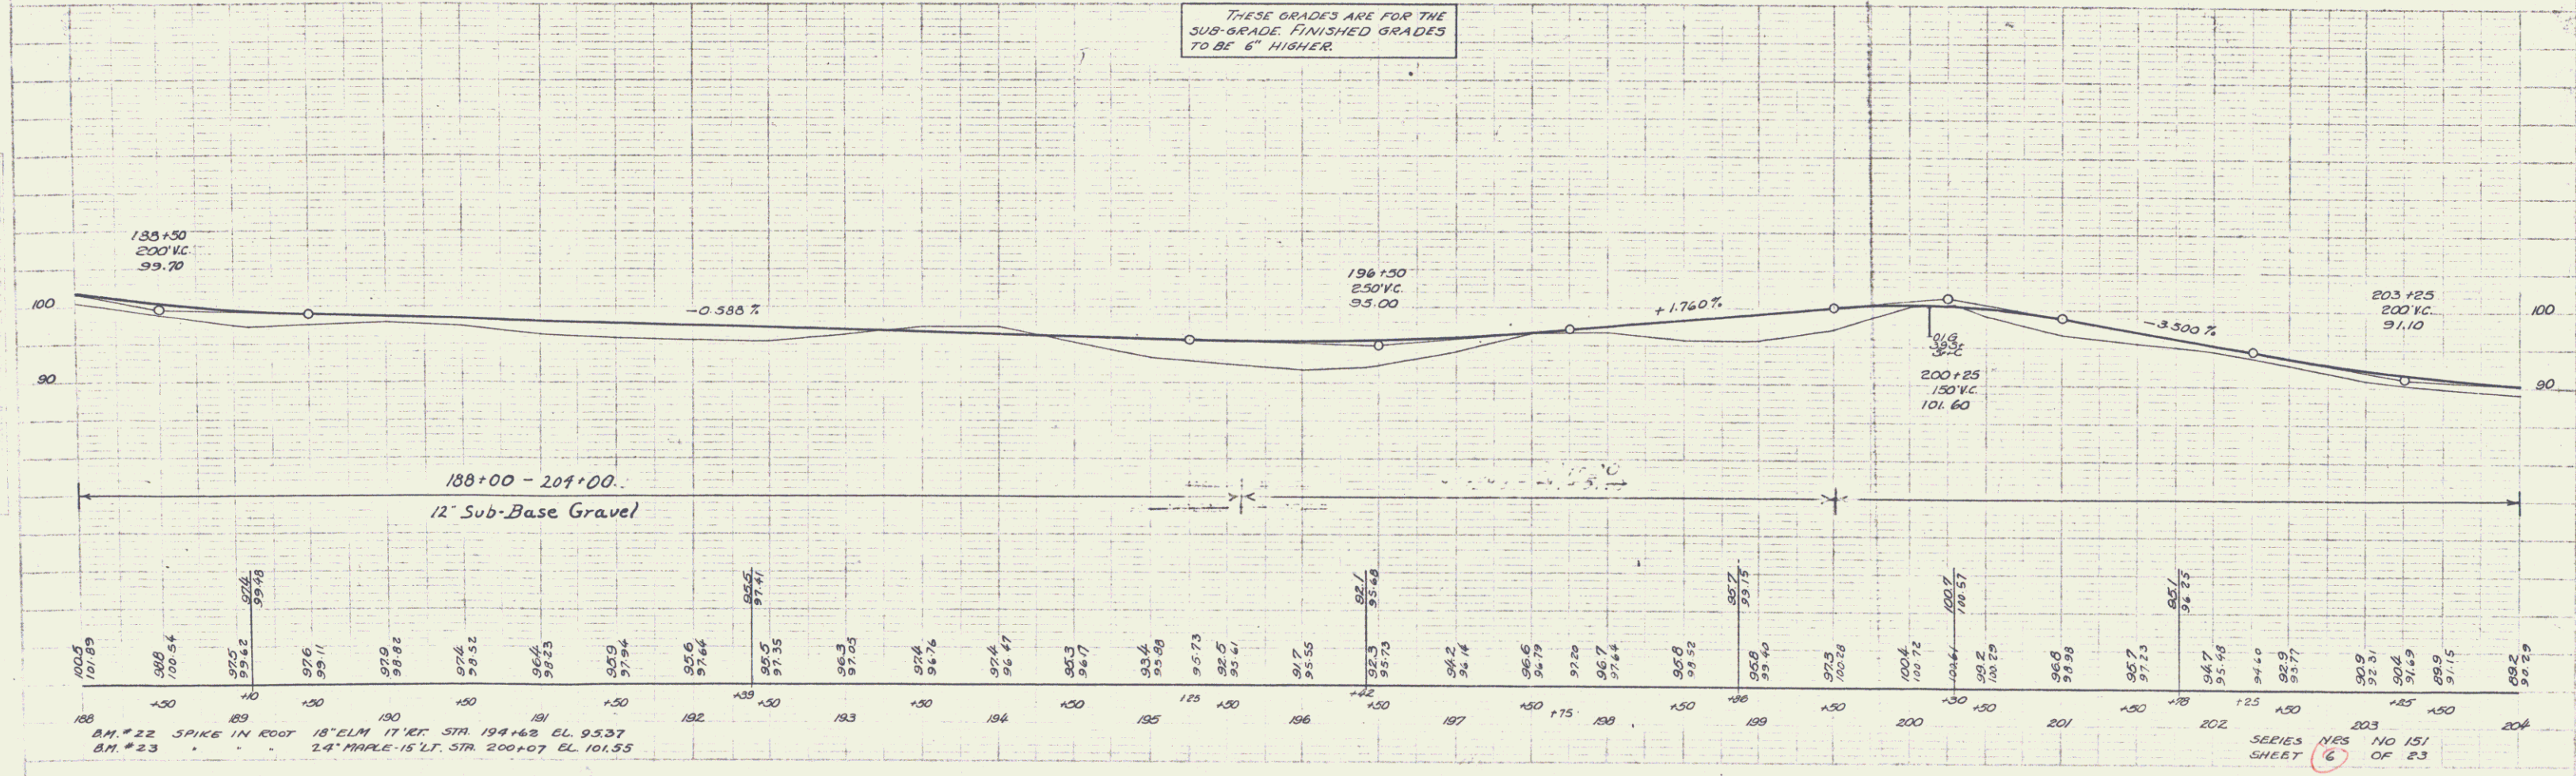

BM #22 SPIKE IN ROOT 18" ELM 17' RT. STR. 194+63 EL. 93.37
 BM #23 2.4" MAPLE 15' LT. STR. 200+07 EL. 101.55

SERIES NOS. NO 151 OF 23 SHEET 6