

INDEX OF SHEETS

SHEET NO.	1	TITLE PAGE
	2	TYPICAL CROSS SECTION OF IMPROVEMENT CRUSHED GRAVEL MIXED-IN-PLACE SURFACE COURSE WITH OUTBACK ASPHALT AND PRIME COAT OF REFINED TAR, ITEM 3-4.2 MOD.
	3	BANKING AND WIDENING TABLES
	4	QUANTITY SHEET (ITEMS)
	5	QUANTITY SHEET (DRAINAGE)
	6-10	EARTHWORK SHEETS
	11-22	PLAN AND PROFILE SHEETS
	23	CONSTRUCTION DETAILS (DRAINAGE AND MARKERS)
	24	CONSTRUCTION DETAILS (DITCHES)
	25	CONSTRUCTION DETAILS (TYPICAL GRADING)
	26	STANDARD STRUCTURE SHEET S-40 (BARRICADES, SIGNS AND LIGHTS)
	27	STANDARD STRUCTURE SHEET S-45-45 (PLANK GUARD RAIL)
	28	STANDARD STRUCTURE SHEET S-48-48 (THREE CABLE GUARD RAIL)
	29	PLAN OF 10' X 6' COMBINATION BOX AND RIGID FRAME
	30	CONSTRUCTION DETAILS - RIGID FRAME
	31	CONSTRUCTION DETAILS - COMBINATION BOX
	32	REINFORCING STEEL SCHEDULE
	33	CHANNEL SECTIONS
	34	STANDARD STRUCTURE SHEET SB 20 (BRIDGE DETAILS)
	35	CONSTRUCTION DETAILS - 12' X 9' FR/MP
	36	REINFORCING STEEL SCHEDULE
	37-38	CHANNEL SECTIONS
	39-108	CROSS SECTIONS

STANDARD STRUCTURE SHEET APPROVED BY THE CHIEF ENGINEER, VERMONT STATE DEPARTMENT OF HIGHWAYS.
S 40 JUNE 10, 1950

STATE OF VERMONT
DEPARTMENT OF HIGHWAYS
PROPOSED IMPROVEMENT

FEDERAL PROJECT


TOWNS OF FLETCHER-BAKERSFIELD
COUNTY OF FRANKLIN
VERMONT ROUTE 108
CAMBRIDGE-BAKERSFIELD ROAD

BEGINNING AT A POINT 8112.1 FEET SOUTHERLY OF THE FLETCHER-BAKERSFIELD TOWN LINE AND EXTENDING NORTHERLY 17,156.1 FEET

LENGTH OF PROJECT 17,156.1 FT = 3.249 MILES


PROJECT NAME & NUMBER	TYPE	PAVEMENT AREA
FLETCHER-BAKERSFIELD F 151 (4)	MIP SURFACE	41937 S.Y.
RECORD PLANS		
MATERIALS		
SUB-BASE OF GRAVEL (TUPPER PIT) BAKERSFIELD	REINF. STEEL VT. STRUCT. STEEL CO., BURLINGTON	
SUB-BASE OF SAND (JORDAN PIT) BAKERSFIELD	R.C.P. VT. CONC. PIPE CORP., WINDSOR	
CRUSHED GRAVEL NADEAU SA. & GR. CO., JOHNSON	A.C.C.G.M.P. NEW ENG. MET. CULV. CO. BOSTON, MASS.	
OUTBACK ASPHALT ESSO CO., EVERETT, MASS.	CABLE FOR G.R.A.M. ST. A WIRE CO., NEW HAVEN, CONN.	
CEMENT LONE STAR PORT. CEM. CO., HUDSON, N.Y.	GUARD RAIL PAINT BRADLEY LABS, BRATTLEBORO	
CONTRACTOR LEWIS & SCOTT, ANDOVER, MASS.	CONTRACT DATED JULY 20, 1953	
RESIDENT ENG'R. H. G. GARRETS	CONTRACT STARTED JULY 20, 1953	
INSPECTORS S. R. JENKINS	CONTRACT COMPLETED AUGUST 28, 1954	
RECORD PLANS S. R. JENKINS-A.D. ALDRICH	CONTRACT ACCEPTED AUGUST 28, 1954	

RES. ROAD DISTRICT	STATE PROJECT NO.	TOTAL SHEETS	TOTAL SHEETS
F 151 (4)	424	1	109

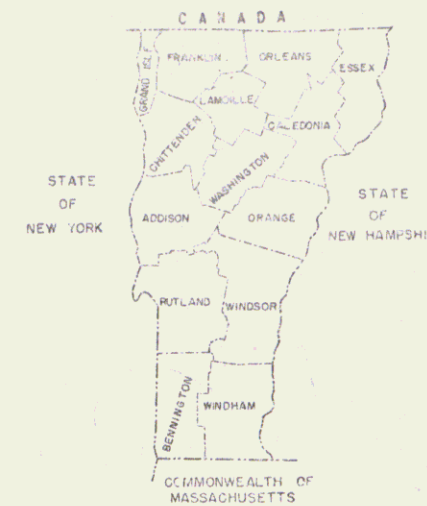

RIGHT-OF-WAY DIVISION
TOWN FILE

PERPETUAL
Town of Bte vt 108
(To Be Returned To R.O.W. Division)
MP 1.713

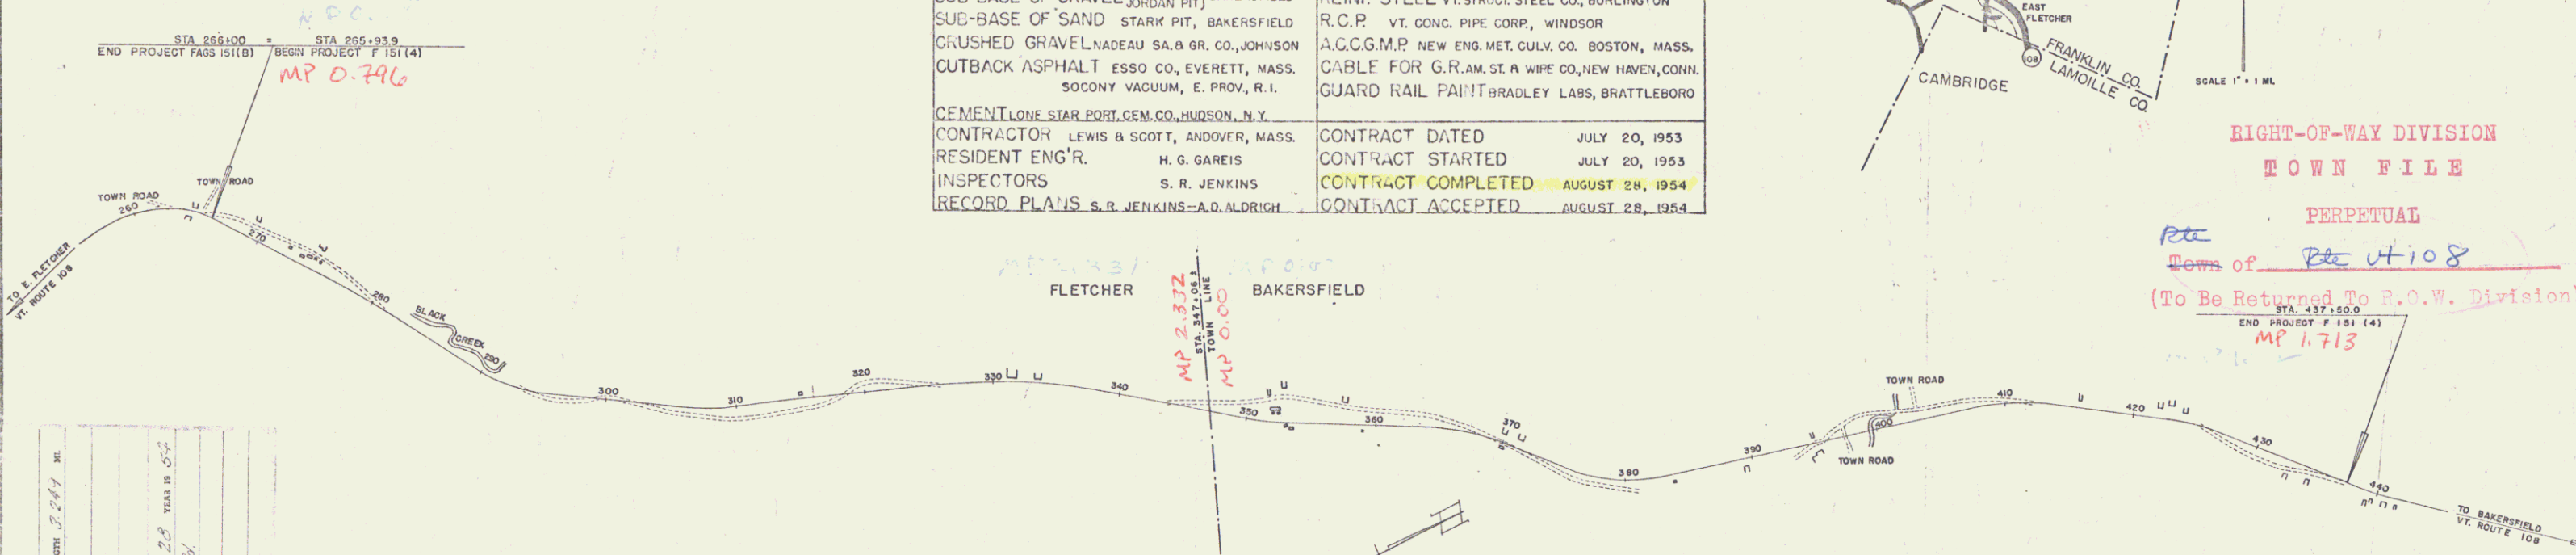

PROJECT Fletcher-Bakersfield
NUMBER F 151 (4)
DATE June 24, 1953
DESIGNED BY M.T.P. Surf. Eng.
CHECKED BY Lewis & Scott
RECORD PLANS S.R. JENKINS-A.D. ALDRICH
CONST. COMPLETED 8-28-54

CURVE DATA	
DEFLECTION OF ANGLE	A
DEGREE OF CURVE	D
RADIUS OF CURVE	R
TANGENT DISTANCE	T
LENGTH OF CURVE	L
EXTERNAL DISTANCE	E
POINT OF INTERSECTION	P.I.
POINT OF CURVE	P.C.
POINT OF TANGENT	P.T.
POINT ON TANGENT	P.O.T.
POINT ON SUB-TANGENT	P.O.S.T.

SCALES	
TITLE	1" = 800'
TYPICAL	1" = 2'
PLAN	1" = 50'
PROFILE HORIZONTAL	1" = 50'
PROFILE VERTICAL	1" = 10'
CROSS-SECTIONS	1" = 5'

APPROVED [Signature] DISTRICT ENGINEER DATE JUNE 20 1953	APPROVED [Signature] BUREAU ENGINEER DATE	APPROVED G.H. Pierce DISTRICT ENGINEER DATE June 24 1953	APPROVED [Signature] DISTRICT ENGINEER DATE JUNE 19 1953	APPROVED H.E. August CHIEF ENGINEER DATE JUNE 22 1953
---	--	---	---	--

Pin # 00043

DEPARTMENT OF COMMERCE
BUREAU OF PUBLIC ROADS

RECOMMENDED FOR APPROVAL [Signature] DISTRICT ENGINEER DATE

APPROVED [Signature] DISTRICT ENGINEER DATE

PROJECT F NO. 151 (4)

SHEET 108 OF 108 SHEETS

THESE PLANS ARE SUBJECT TO SUCH REVISIONS AS MAY BE REQUIRED BY THE BUREAU OF PUBLIC ROADS OR THE COMMISSIONER OF HIGHWAYS.

CONSTRUCTION IS TO BE CARRIED ON IN ACCORDANCE WITH THE PLANS AND THE STANDARD ROAD AND BRIDGE SPECIFICATIONS OF 1946, AS APPROVED JULY 25, 1949 BY THE BUREAU OF PUBLIC ROADS, INCLUDING ALL SUBSEQUENT APPROVED REVISIONS AND SUCH REVISED SPECIFICATIONS AND SPECIAL PROVISIONS AS ARE SUBMITTED WITH THE PLANS.