


PLAN
 DATE: 8/22
 DRAWN BY: [illegible]
 CHECKED BY: [illegible]

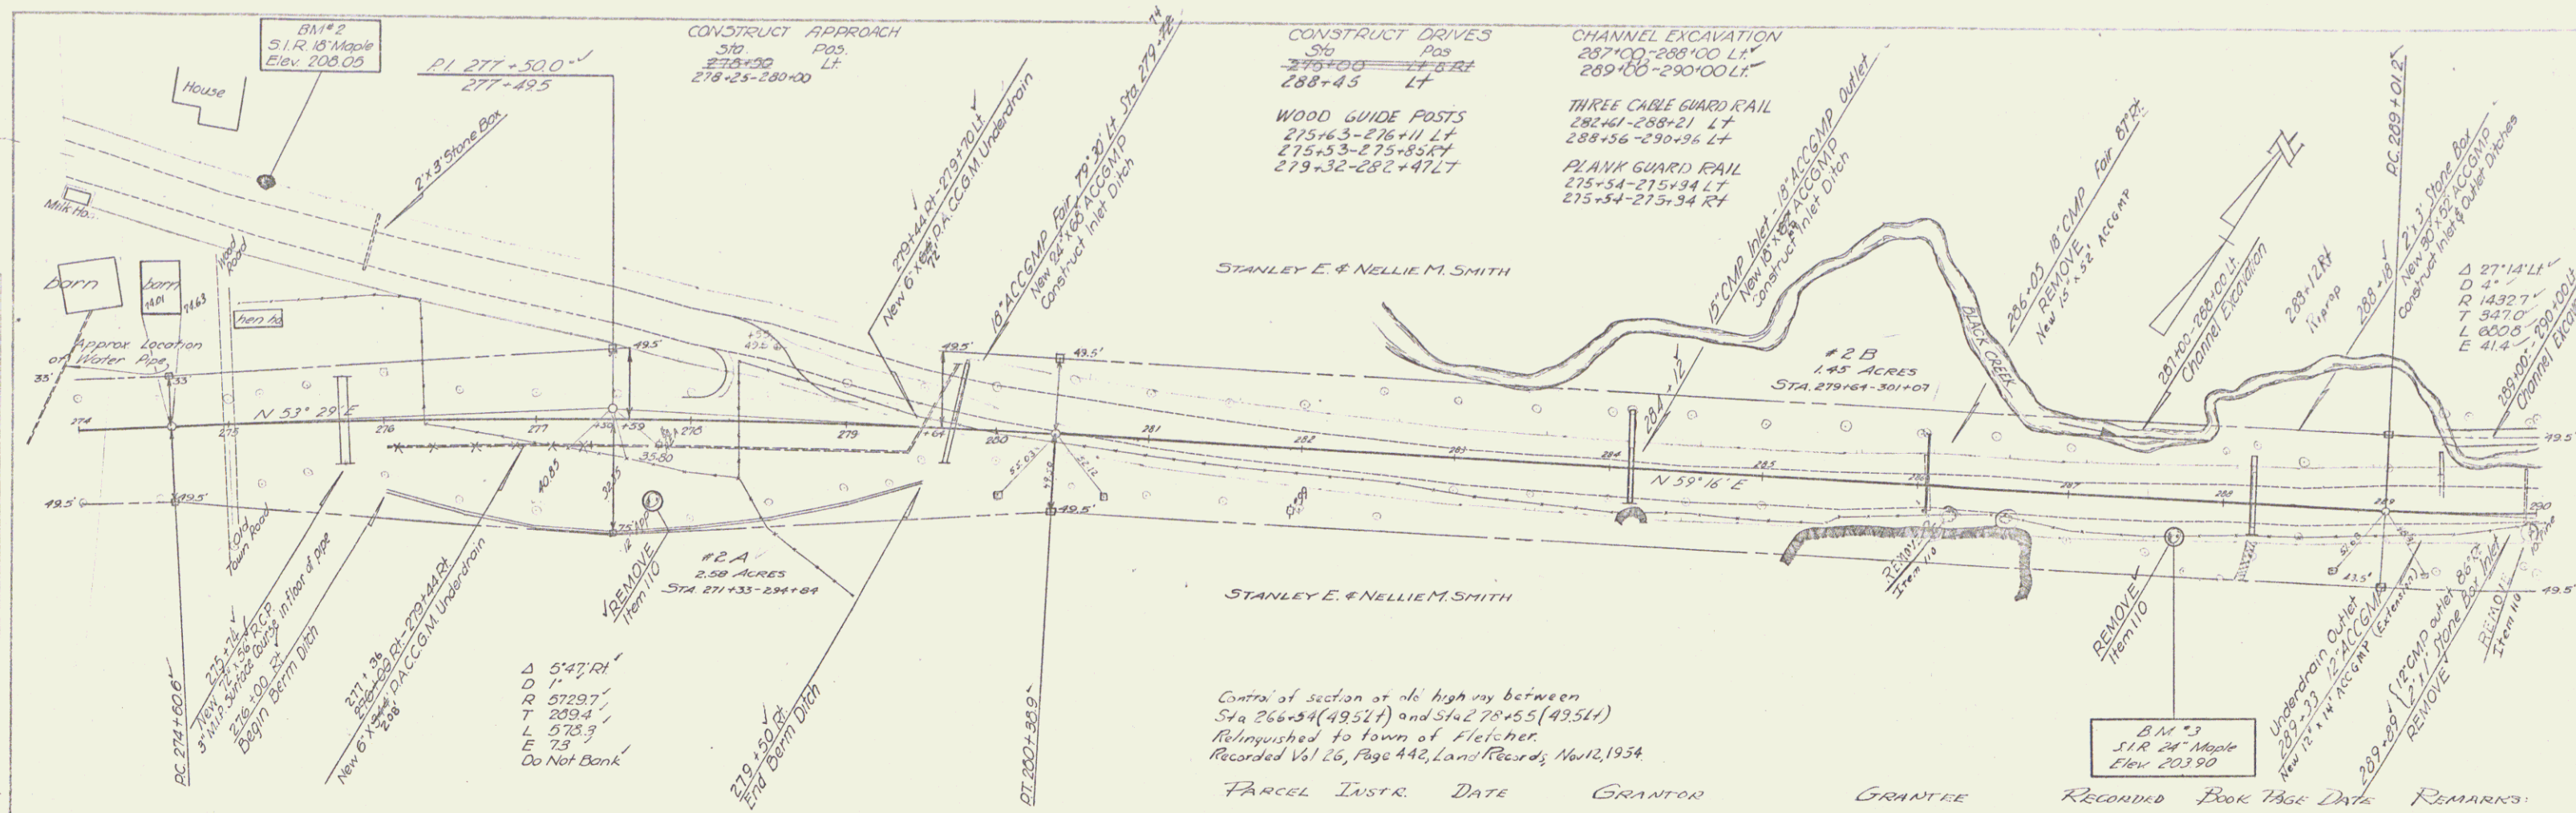

PROFILE
 DATE: 8/22
 DRAWN BY: [illegible]
 CHECKED BY: [illegible]

