
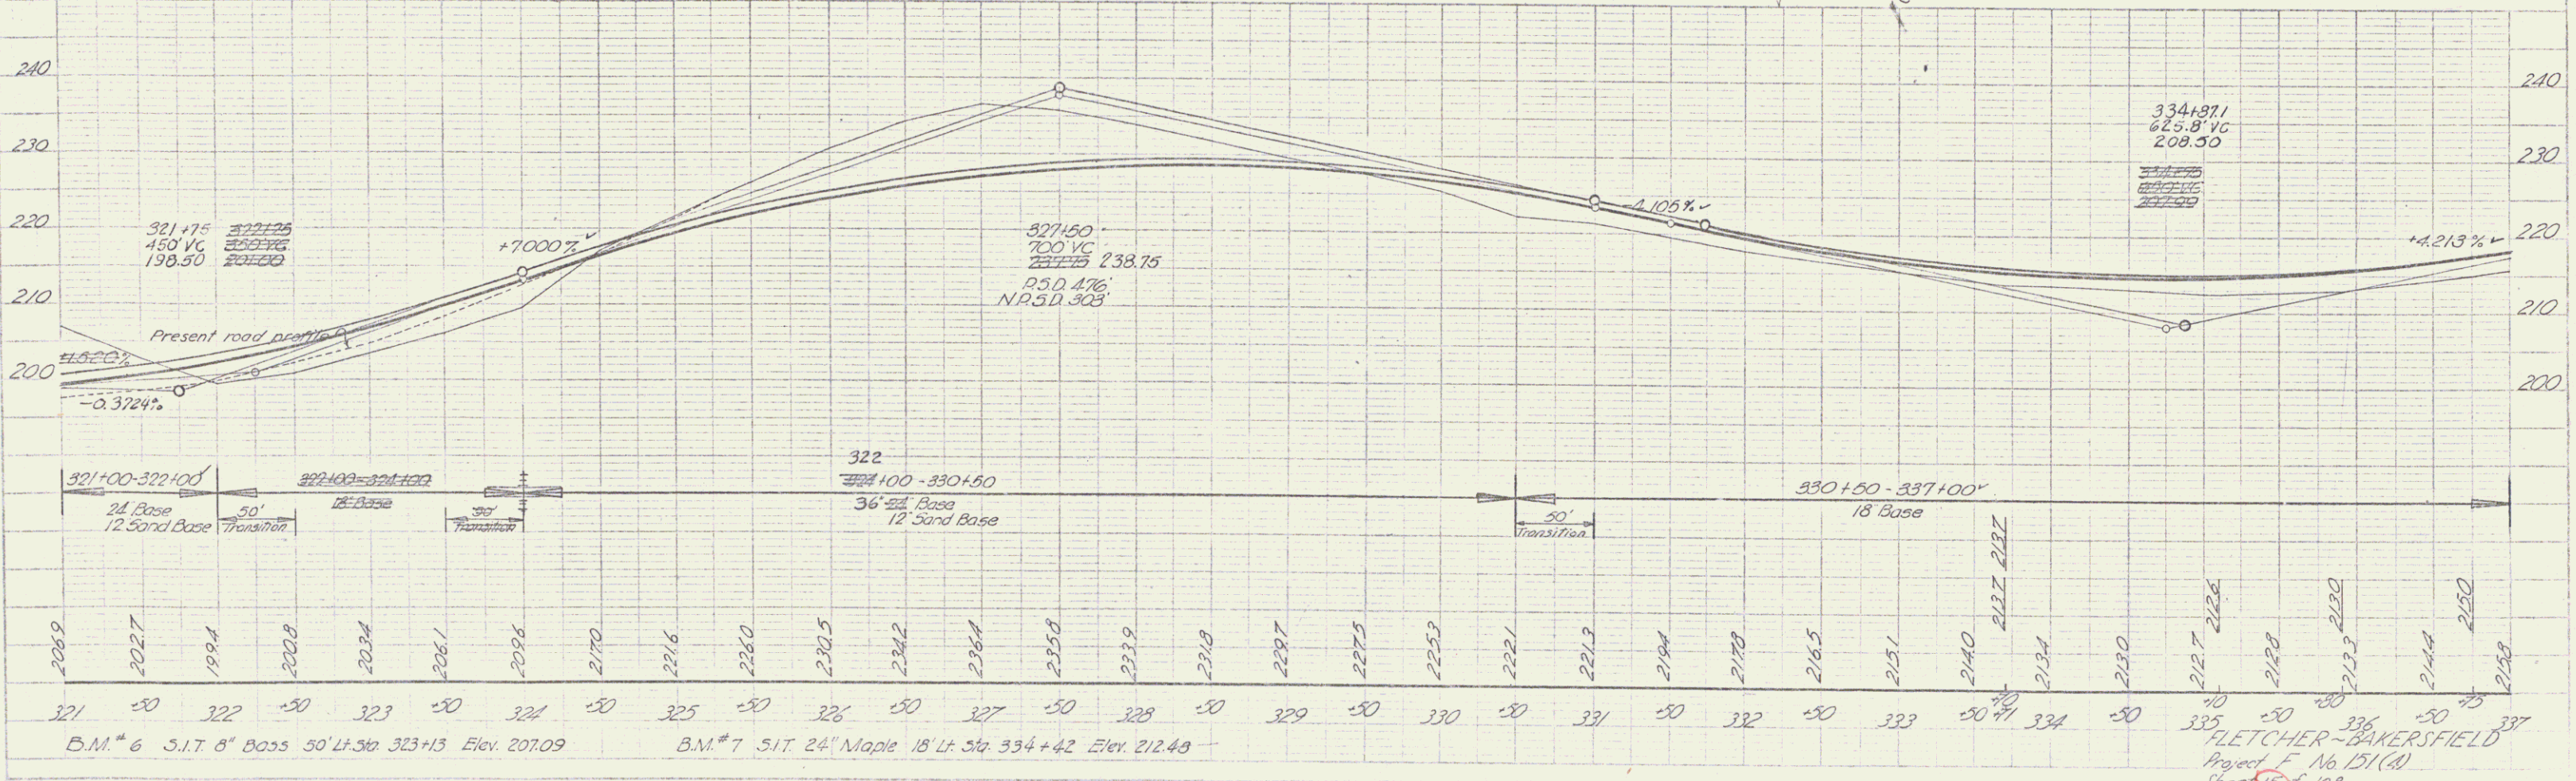


FARCEL INSTR. DATE GRANTOR GRANTEE RECORDED BOOK PAGE DATE REMARKS
 #31, B.C. W.D.O.E. 6-24-53 GORDON K. & MYRTLE LONGE JR. & W. FLETCHER 27-132-133 7-9-53 See also sheets 14 & 16

Construct Drives
 L1 40 24
 333+71 333+71
 330+70 330+70

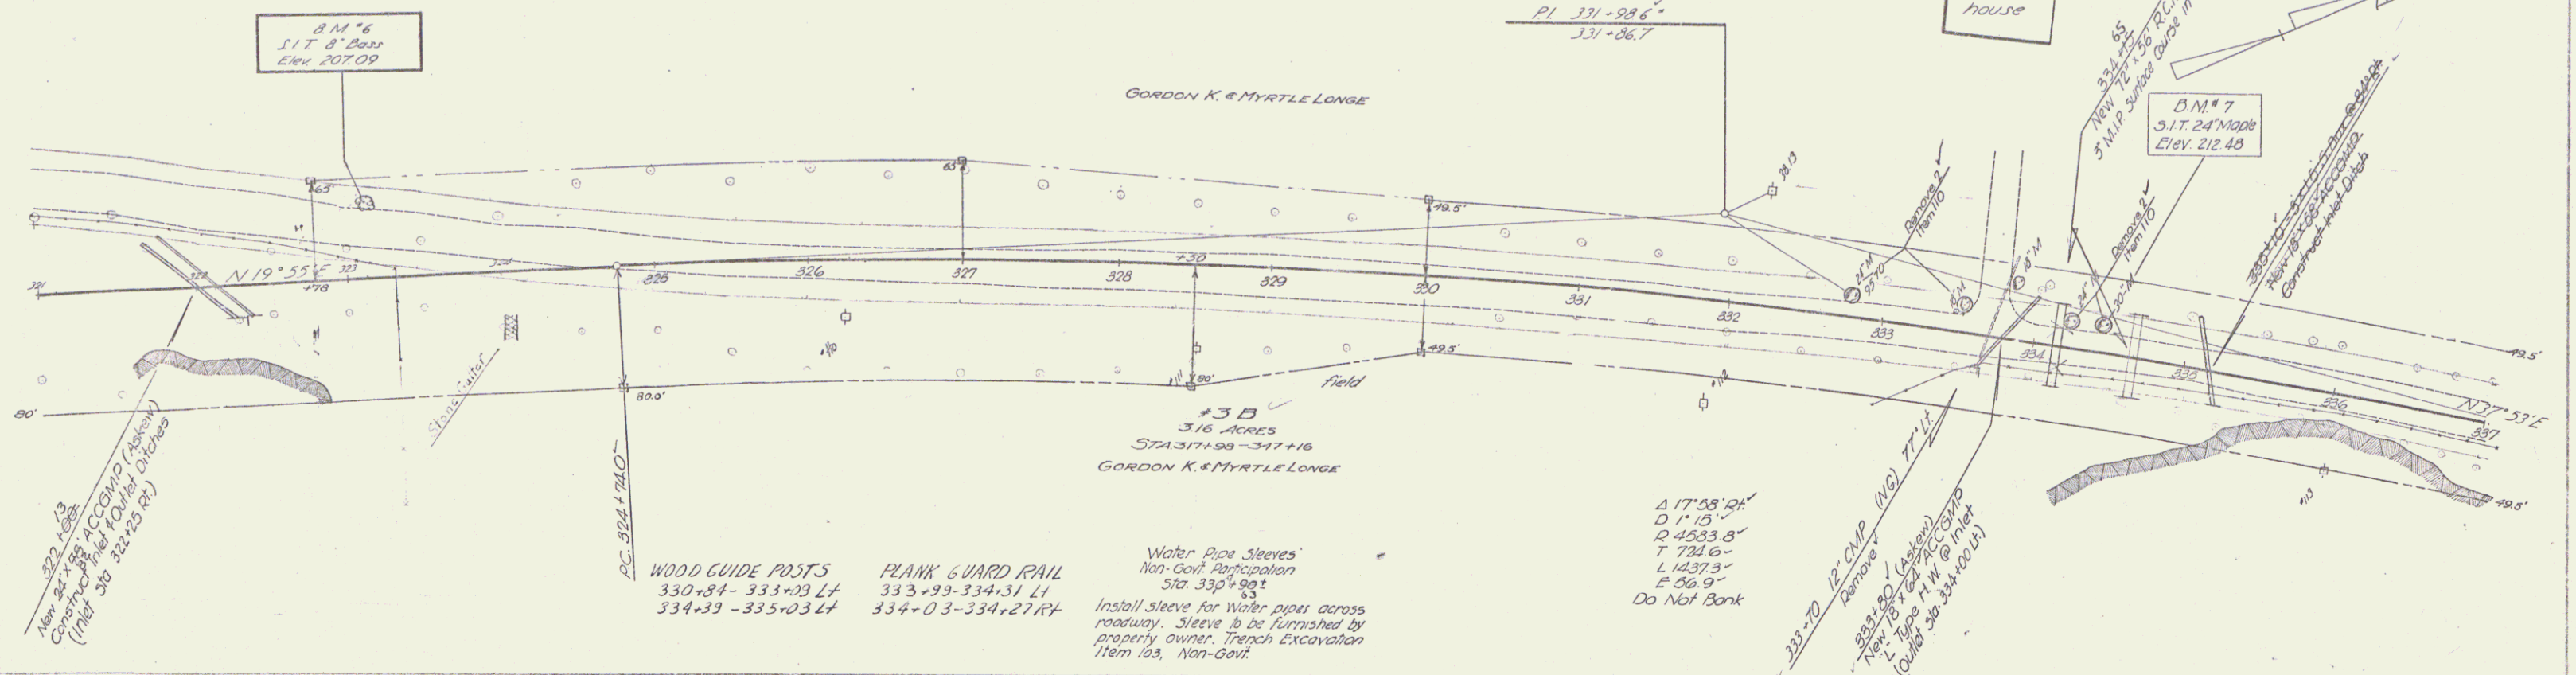

FLETCHER-BAKERSFIELD
 Project No. 151(A)
 Sheet 15 of 108