

PARCEL INSTRUMENT DATE GRANTOR  
 #11 W.DOE 6-24-53 JOHN H. & IRENE E. BOESCH

GRANTEE RECORDED BOOK PAGE DATE  
 ST. OF VT. BAKERSFIELD 1 54 7-7-53

DRIVES CONST'D  
 420+30-423+75 LT  
 430+58 LT

B.M. #16  
 S.I.R. 24°M  
 El. 372.19

P.I. 424+92.00  
 424+89.6

Water Pipe Sleeves  
 Non-Govt. Participation  
 Sta. 422+40±

APPROACH CONST.  
 426+0-427+50 RT

Install Sleeve for water pipes across roadway. Sleeve to be furnished by property owner. Trench Excavation Item 103 Non-Govt.

6/52  
 9/52  
 8/52  
 7/52  
 6/52  
 5/52  
 4/52  
 3/52  
 2/52  
 1/52  
 0/52  
 11/51  
 10/51  
 9/51  
 8/51  
 7/51  
 6/51  
 5/51  
 4/51  
 3/51  
 2/51  
 1/51  
 0/51  
 11/50  
 10/50  
 9/50  
 8/50  
 7/50  
 6/50  
 5/50  
 4/50  
 3/50  
 2/50  
 1/50  
 0/50  
 11/49  
 10/49  
 9/49  
 8/49  
 7/49  
 6/49  
 5/49  
 4/49  
 3/49  
 2/49  
 1/49  
 0/49  
 11/48  
 10/48  
 9/48  
 8/48  
 7/48  
 6/48  
 5/48  
 4/48  
 3/48  
 2/48  
 1/48  
 0/48  
 11/47  
 10/47  
 9/47  
 8/47  
 7/47  
 6/47  
 5/47  
 4/47  
 3/47  
 2/47  
 1/47  
 0/47  
 11/46  
 10/46  
 9/46  
 8/46  
 7/46  
 6/46  
 5/46  
 4/46  
 3/46  
 2/46  
 1/46  
 0/46  
 11/45  
 10/45  
 9/45  
 8/45  
 7/45  
 6/45  
 5/45  
 4/45  
 3/45  
 2/45  
 1/45  
 0/45  
 11/44  
 10/44  
 9/44  
 8/44  
 7/44  
 6/44  
 5/44  
 4/44  
 3/44  
 2/44  
 1/44  
 0/44  
 11/43  
 10/43  
 9/43  
 8/43  
 7/43  
 6/43  
 5/43  
 4/43  
 3/43  
 2/43  
 1/43  
 0/43  
 11/42  
 10/42  
 9/42  
 8/42  
 7/42  
 6/42  
 5/42  
 4/42  
 3/42  
 2/42  
 1/42  
 0/42  
 11/41  
 10/41  
 9/41  
 8/41  
 7/41  
 6/41  
 5/41  
 4/41  
 3/41  
 2/41  
 1/41  
 0/41  
 11/40  
 10/40  
 9/40  
 8/40  
 7/40  
 6/40  
 5/40  
 4/40  
 3/40  
 2/40  
 1/40  
 0/40  
 11/39  
 10/39  
 9/39  
 8/39  
 7/39  
 6/39  
 5/39  
 4/39  
 3/39  
 2/39  
 1/39  
 0/39  
 11/38  
 10/38  
 9/38  
 8/38  
 7/38  
 6/38  
 5/38  
 4/38  
 3/38  
 2/38  
 1/38  
 0/38  
 11/37  
 10/37  
 9/37  
 8/37  
 7/37  
 6/37  
 5/37  
 4/37  
 3/37  
 2/37  
 1/37  
 0/37  
 11/36  
 10/36  
 9/36  
 8/36  
 7/36  
 6/36  
 5/36  
 4/36  
 3/36  
 2/36  
 1/36  
 0/36  
 11/35  
 10/35  
 9/35  
 8/35  
 7/35  
 6/35  
 5/35  
 4/35  
 3/35  
 2/35  
 1/35  
 0/35  
 11/34  
 10/34  
 9/34  
 8/34  
 7/34  
 6/34  
 5/34  
 4/34  
 3/34  
 2/34  
 1/34  
 0/34  
 11/33  
 10/33  
 9/33  
 8/33  
 7/33  
 6/33  
 5/33  
 4/33  
 3/33  
 2/33  
 1/33  
 0/33  
 11/32  
 10/32  
 9/32  
 8/32  
 7/32  
 6/32  
 5/32  
 4/32  
 3/32  
 2/32  
 1/32  
 0/32  
 11/31  
 10/31  
 9/31  
 8/31  
 7/31  
 6/31  
 5/31  
 4/31  
 3/31  
 2/31  
 1/31  
 0/31  
 11/30  
 10/30  
 9/30  
 8/30  
 7/30  
 6/30  
 5/30  
 4/30  
 3/30  
 2/30  
 1/30  
 0/30  
 11/29  
 10/29  
 9/29  
 8/29  
 7/29  
 6/29  
 5/29  
 4/29  
 3/29  
 2/29  
 1/29  
 0/29  
 11/28  
 10/28  
 9/28  
 8/28  
 7/28  
 6/28  
 5/28  
 4/28  
 3/28  
 2/28  
 1/28  
 0/28  
 11/27  
 10/27  
 9/27  
 8/27  
 7/27  
 6/27  
 5/27  
 4/27  
 3/27  
 2/27  
 1/27  
 0/27  
 11/26  
 10/26  
 9/26  
 8/26  
 7/26  
 6/26  
 5/26  
 4/26  
 3/26  
 2/26  
 1/26  
 0/26  
 11/25  
 10/25  
 9/25  
 8/25  
 7/25  
 6/25  
 5/25  
 4/25  
 3/25  
 2/25  
 1/25  
 0/25  
 11/24  
 10/24  
 9/24  
 8/24  
 7/24  
 6/24  
 5/24  
 4/24  
 3/24  
 2/24  
 1/24  
 0/24  
 11/23  
 10/23  
 9/23  
 8/23  
 7/23  
 6/23  
 5/23  
 4/23  
 3/23  
 2/23  
 1/23  
 0/23  
 11/22  
 10/22  
 9/22  
 8/22  
 7/22  
 6/22  
 5/22  
 4/22  
 3/22  
 2/22  
 1/22  
 0/22  
 11/21  
 10/21  
 9/21  
 8/21  
 7/21  
 6/21  
 5/21  
 4/21  
 3/21  
 2/21  
 1/21  
 0/21  
 11/20  
 10/20  
 9/20  
 8/20  
 7/20  
 6/20  
 5/20  
 4/20  
 3/20  
 2/20  
 1/20  
 0/20  
 11/19  
 10/19  
 9/19  
 8/19  
 7/19  
 6/19  
 5/19  
 4/19  
 3/19  
 2/19  
 1/19  
 0/19  
 11/18  
 10/18  
 9/18  
 8/18  
 7/18  
 6/18  
 5/18  
 4/18  
 3/18  
 2/18  
 1/18  
 0/18  
 11/17  
 10/17  
 9/17  
 8/17  
 7/17  
 6/17  
 5/17  
 4/17  
 3/17  
 2/17  
 1/17  
 0/17  
 11/16  
 10/16  
 9/16  
 8/16  
 7/16  
 6/16  
 5/16  
 4/16  
 3/16  
 2/16  
 1/16  
 0/16  
 11/15  
 10/15  
 9/15  
 8/15  
 7/15  
 6/15  
 5/15  
 4/15  
 3/15  
 2/15  
 1/15  
 0/15  
 11/14  
 10/14  
 9/14  
 8/14  
 7/14  
 6/14  
 5/14  
 4/14  
 3/14  
 2/14  
 1/14  
 0/14  
 11/13  
 10/13  
 9/13  
 8/13  
 7/13  
 6/13  
 5/13  
 4/13  
 3/13  
 2/13  
 1/13  
 0/13  
 11/12  
 10/12  
 9/12  
 8/12  
 7/12  
 6/12  
 5/12  
 4/12  
 3/12  
 2/12  
 1/12  
 0/12  
 11/11  
 10/11  
 9/11  
 8/11  
 7/11  
 6/11  
 5/11  
 4/11  
 3/11  
 2/11  
 1/11  
 0/11  
 11/10  
 10/10  
 9/10  
 8/10  
 7/10  
 6/10  
 5/10  
 4/10  
 3/10  
 2/10  
 1/10  
 0/10  
 11/9  
 10/9  
 9/9  
 8/9  
 7/9  
 6/9  
 5/9  
 4/9  
 3/9  
 2/9  
 1/9  
 0/9  
 11/8  
 10/8  
 9/8  
 8/8  
 7/8  
 6/8  
 5/8  
 4/8  
 3/8  
 2/8  
 1/8  
 0/8  
 11/7  
 10/7  
 9/7  
 8/7  
 7/7  
 6/7  
 5/7  
 4/7  
 3/7  
 2/7  
 1/7  
 0/7  
 11/6  
 10/6  
 9/6  
 8/6  
 7/6  
 6/6  
 5/6  
 4/6  
 3/6  
 2/6  
 1/6  
 0/6  
 11/5  
 10/5  
 9/5  
 8/5  
 7/5  
 6/5  
 5/5  
 4/5  
 3/5  
 2/5  
 1/5  
 0/5  
 11/4  
 10/4  
 9/4  
 8/4  
 7/4  
 6/4  
 5/4  
 4/4  
 3/4  
 2/4  
 1/4  
 0/4  
 11/3  
 10/3  
 9/3  
 8/3  
 7/3  
 6/3  
 5/3  
 4/3  
 3/3  
 2/3  
 1/3  
 0/3  
 11/2  
 10/2  
 9/2  
 8/2  
 7/2  
 6/2  
 5/2  
 4/2  
 3/2  
 2/2  
 1/2  
 0/2  
 11/1  
 10/1  
 9/1  
 8/1  
 7/1  
 6/1  
 5/1  
 4/1  
 3/1  
 2/1  
 1/1  
 0/1  
 11/0  
 10/0  
 9/0  
 8/0  
 7/0  
 6/0  
 5/0  
 4/0  
 3/0  
 2/0  
 1/0  
 0/0


THREE CABLE GUARD RAIL  
 417+02-421+34 LT  
 425+70-430+22 LT  
 427+71-429+79 RT

WOOD GUIDE POSTS  
 419+29 419+93 RT  
 PLANK GUARD RAIL  
 419+26-419+74 RT

Δ 13° 56' RT  
 D 3'  
 R 1910.1'  
 T 233.4'  
 L 464.4'  
 E 14.2'  
 bank 1/2 per ft.

PT 427+23.0'  
 427+101-102+100 RT  
 420+100  
 30'  
 Constructed line of ditch

B.M. #17  
 S.I.T. 12°E  
 El. 400.05

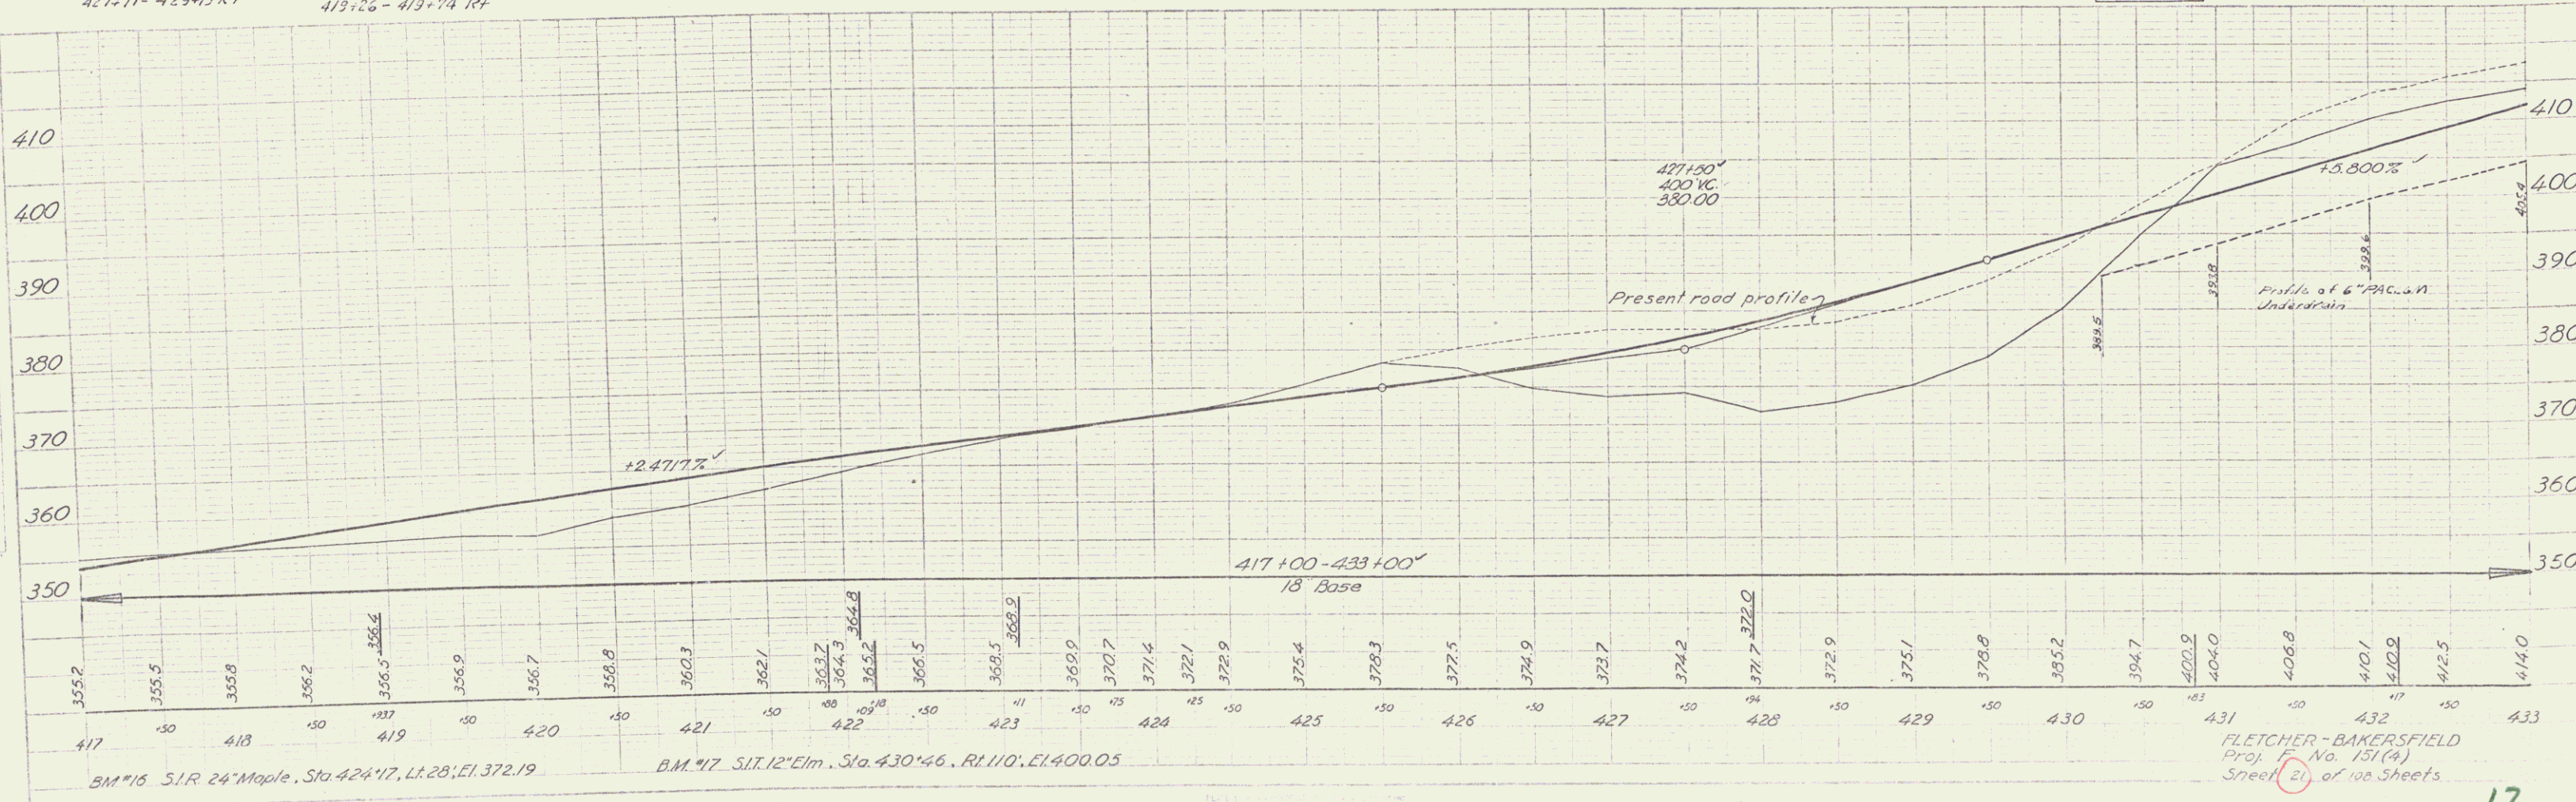

B.M. #16 S.I.R. 24° Maple, Sta. 424+17, Lt. 28', El. 372.19

B.M. #17 S.I.T. 12° Elm, Sta. 430+46, Rt. 110', El. 400.05

FLETCHER-BAKERSFIELD  
 Proj. E. No. 151(4)  
 Sheet 21 of 100 Sheets