
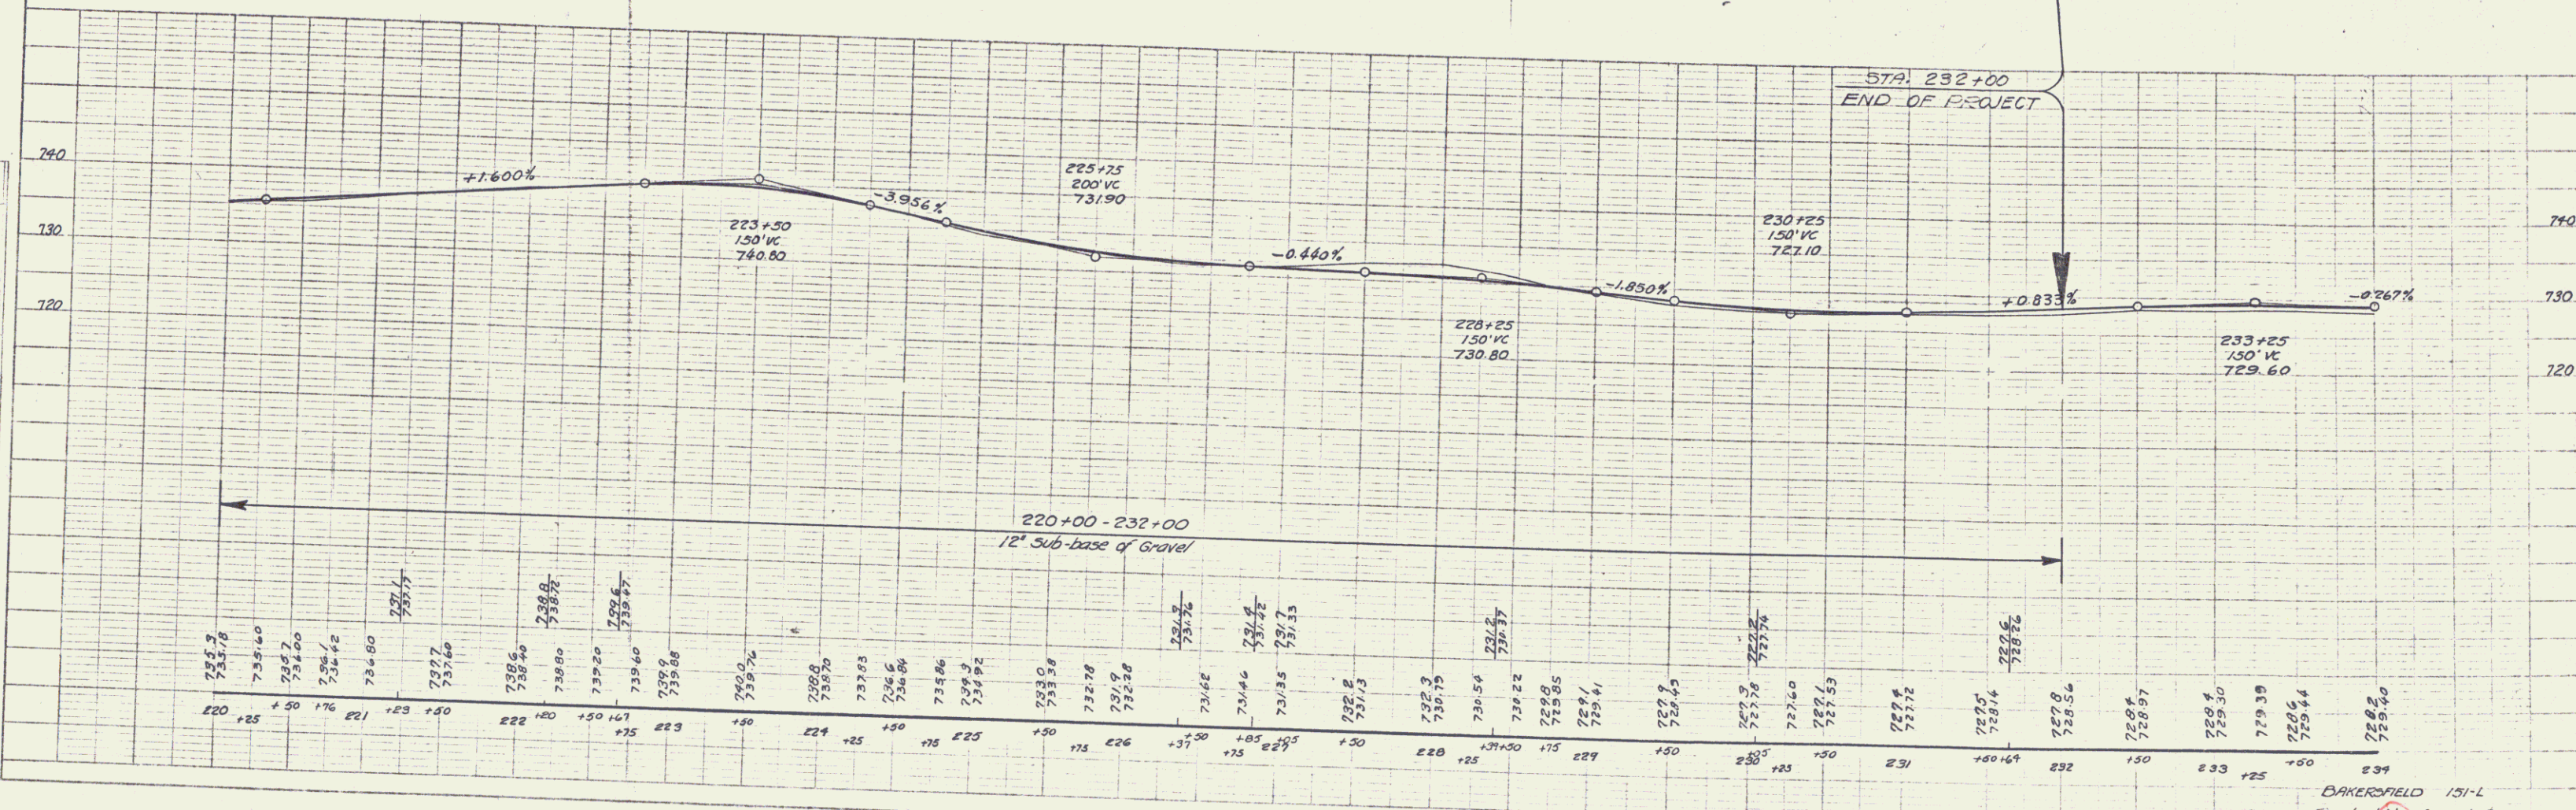


PLAN
 DATE
 DRAWN BY
 CHECKED BY
 IN CHARGE
 NO. OF SHEETS
 SHEET NO.

PROJ. NO. 151-L
 DIST. NO. 4
 STATE VT.
 YEAR 1983
 SHEET NO. 1-1

151-L STATE VT. DIST. NO. 4 YEAR 1983 SHEET NO. 1-1

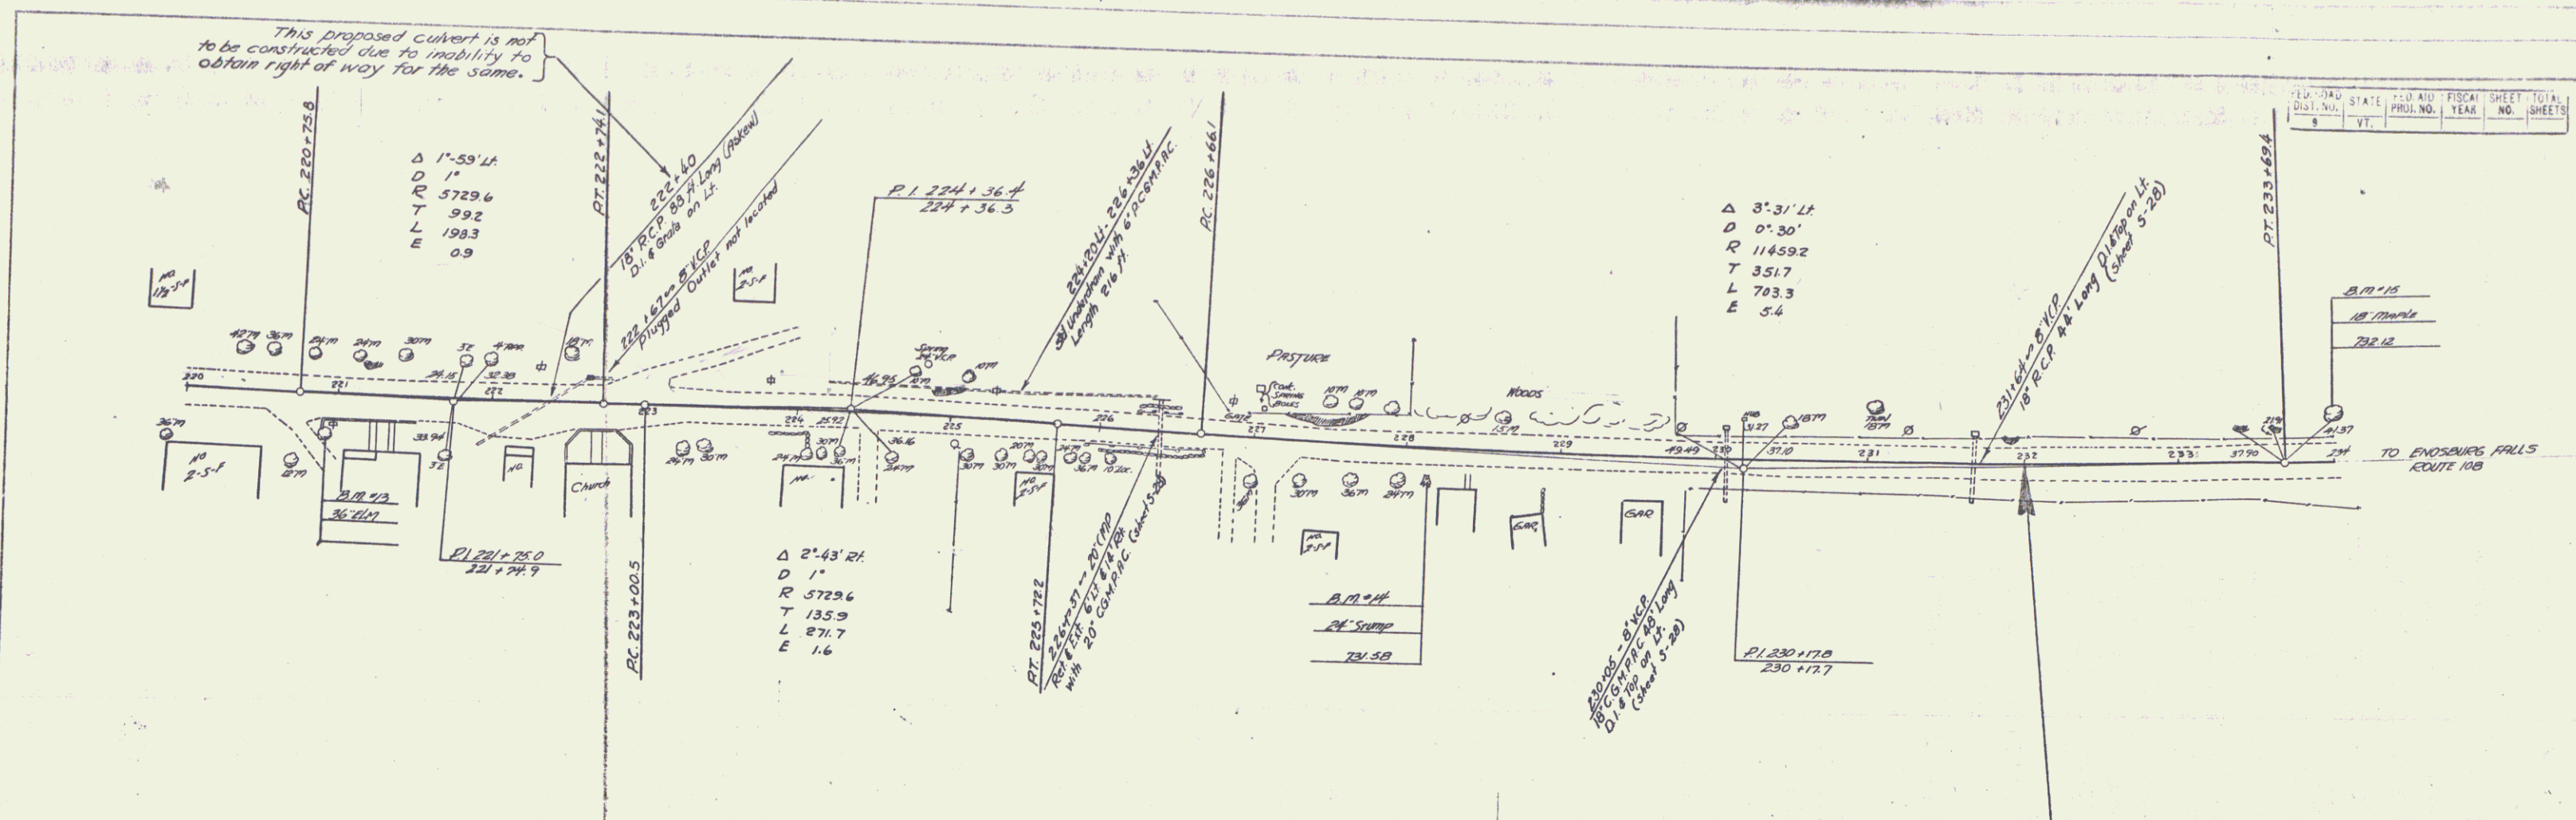

BAKERSFIELD 151-L
 Sheet 4 of 10
 4