
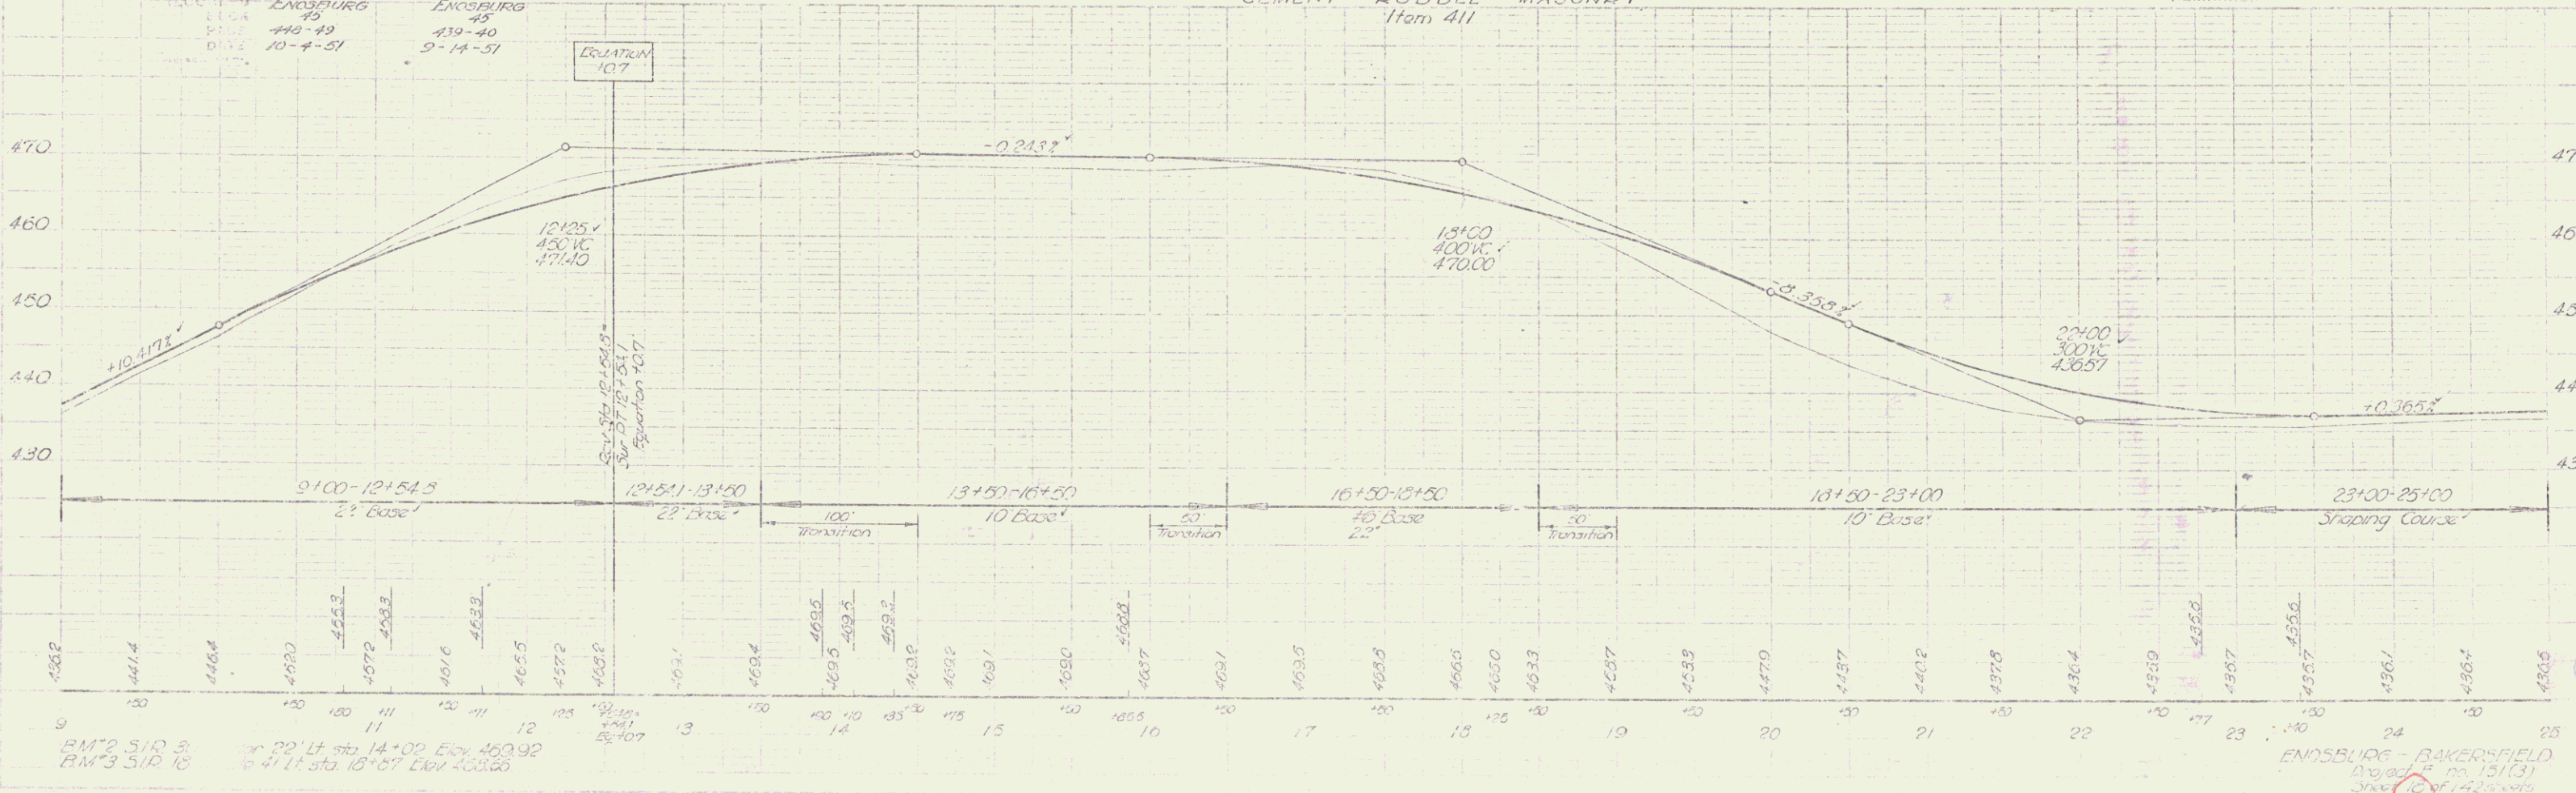


| PL. NO. | STATE | PROJ. NO. | YEAR | SHEET NO. | TOTAL SHEETS |
|---------|-------|-----------|------|-----------|--------------|
| 1 | VT | 12129 | | | |

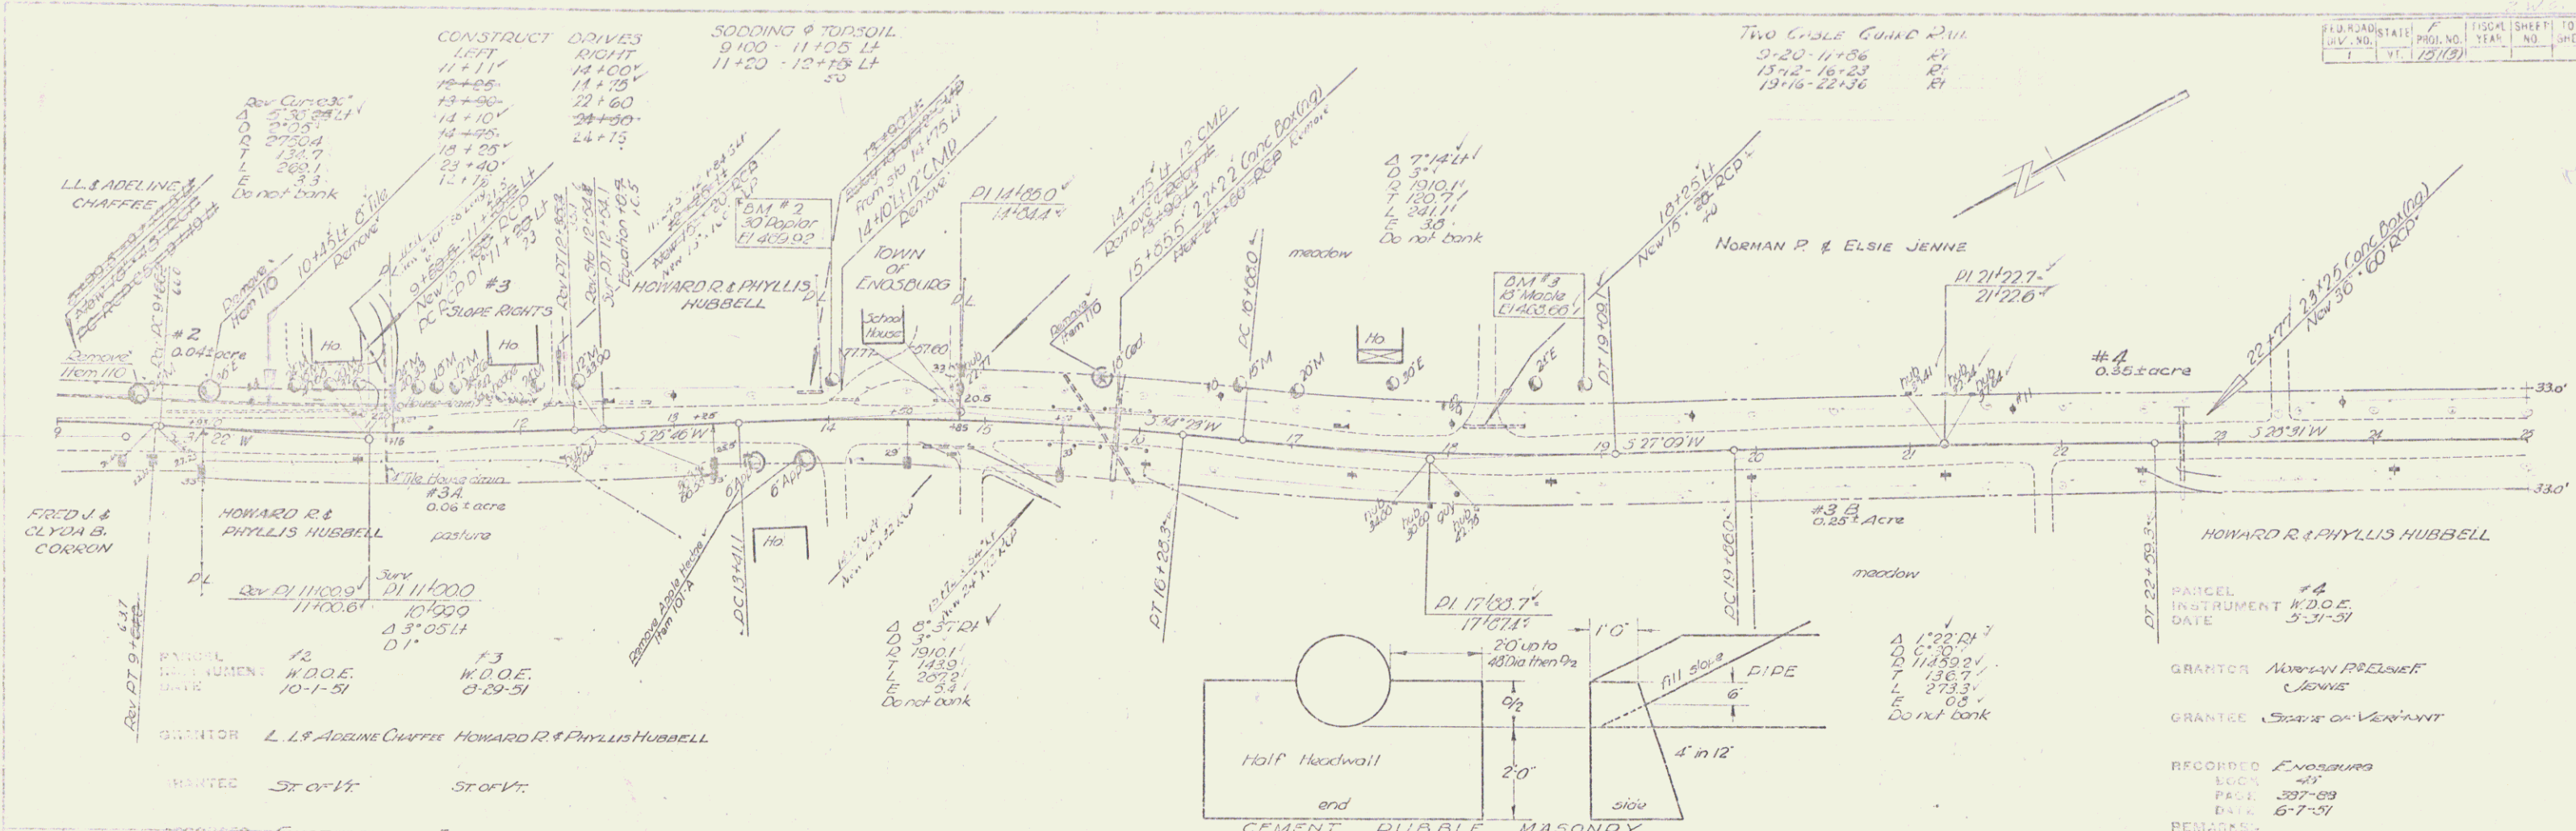

1-41
J. Merrill
C-40

1-16
6-16
6-18

BM #2 S.I.D. 3
BM #3 S.I.D. 10
or 22' Lt. Sta. 14+00 Elev. 459.92
or 41' Lt. Sta. 10+67 Elev. 433.30

ENDSBURG - BAKERSFIELD
Project # 12129
Sheet 10 of 14