
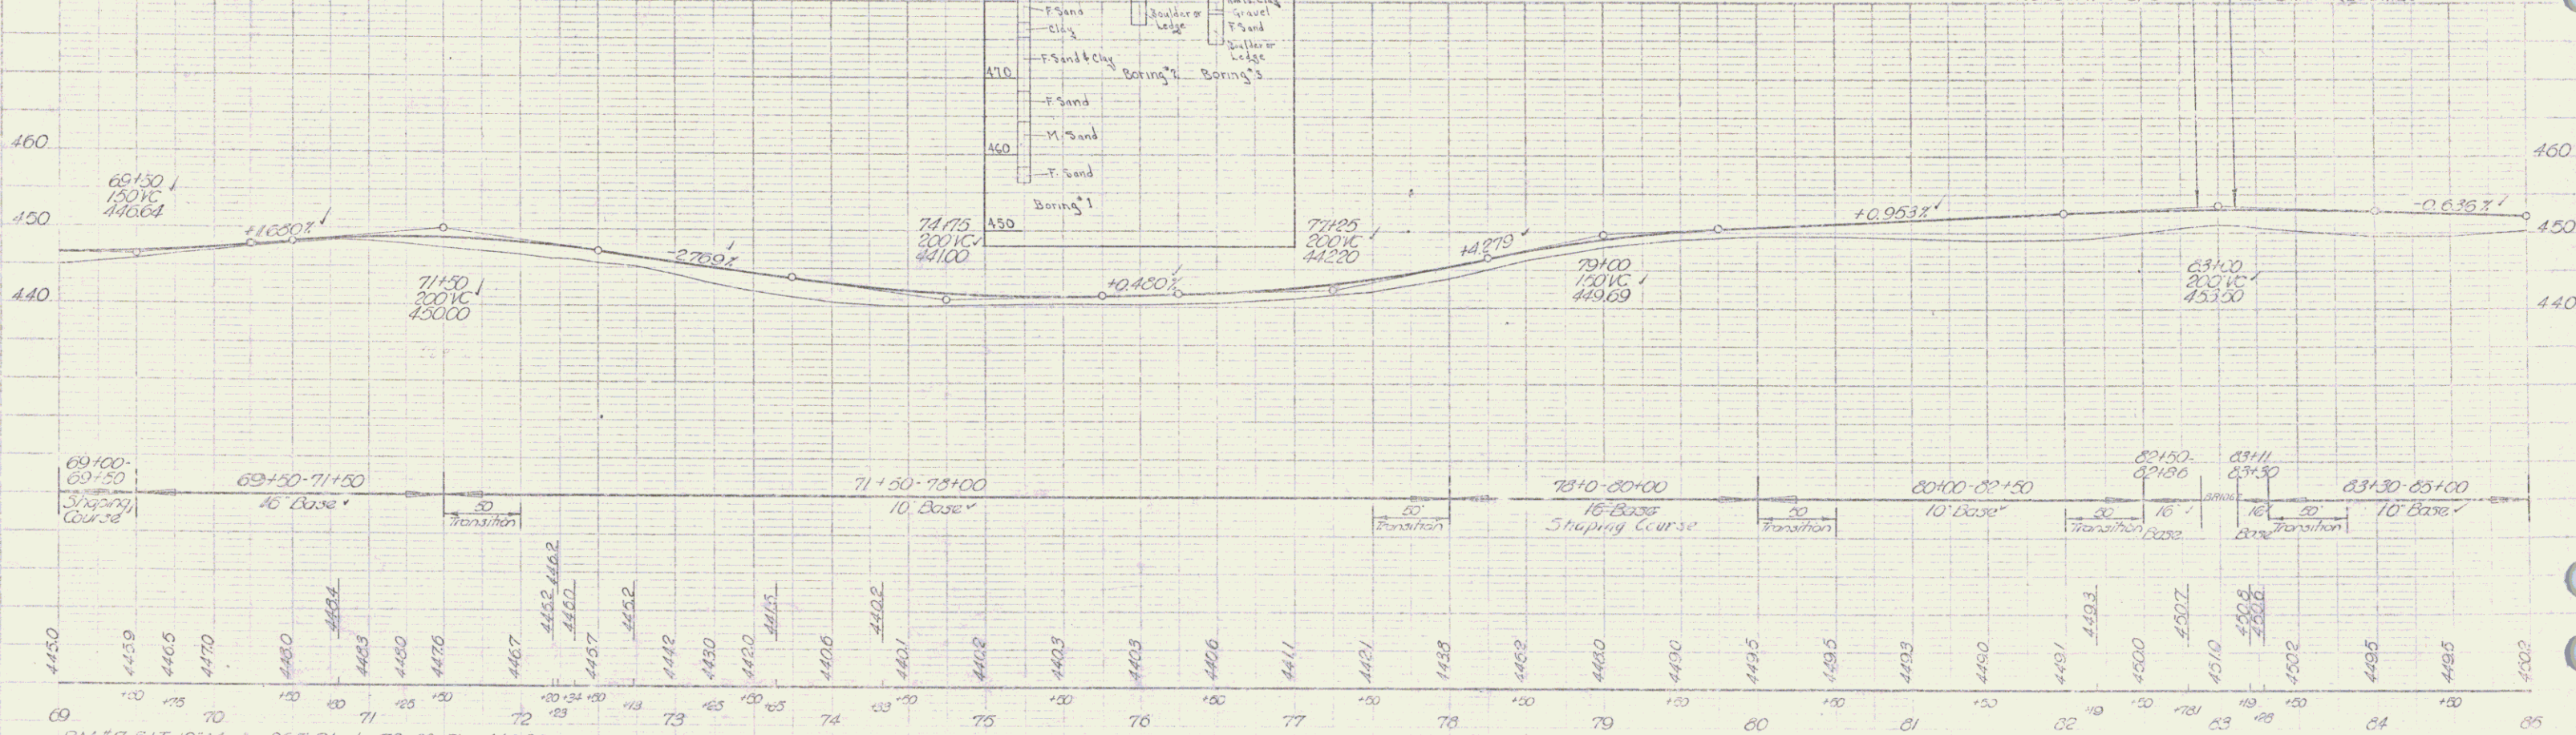


GRANTOR CLYDE H. & DORIS BLAKE TOWN OF BAKERSFIELD
 GRANTEE STATE OF VERMONT ST. OF VT.
 RECORDED ENOSBURG BAKERSFIELD
 BOOK 45 26
 PAGE 385-388 336-37
 DATE 8-7-51 6-2-51
 REMARKS C of steel 23

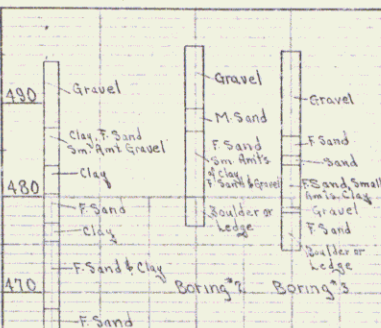

BM #7 31T 12 Maple 26.5 Ft. Sta. 72+30 Elev. 448.27
 BM #8 31D 40 Maple 26 Ft. Sta. 83+93 Elev. 449.32

ED. NO.	STATE	FISCAL YEAR	SHEET NO.	TOTAL SHEETS
1	VT.	1951	9	142

PLAN
 11-47
 8-18
 J. Merrill
 11-47
 8-18

1-42
 6-45
 B. Barber
 1-42
 6-45

ENOSBURG BAKERSFIELD
 Project No. 151(3)
 Sheet 9 of 142 sheets