


FED. ROAD DIST. NO.	STATE	FISCAL YEAR	SHEET NO.	TOTAL SHEETS
1	VT.	1971	121	121

CONSTRUCT DDIVES
LEFT
88+18'
87+00'
93+00'
85+15'

11-47
D. Foster
J. Acarill
0-40

11-48
E. Epner
Jones
0-40

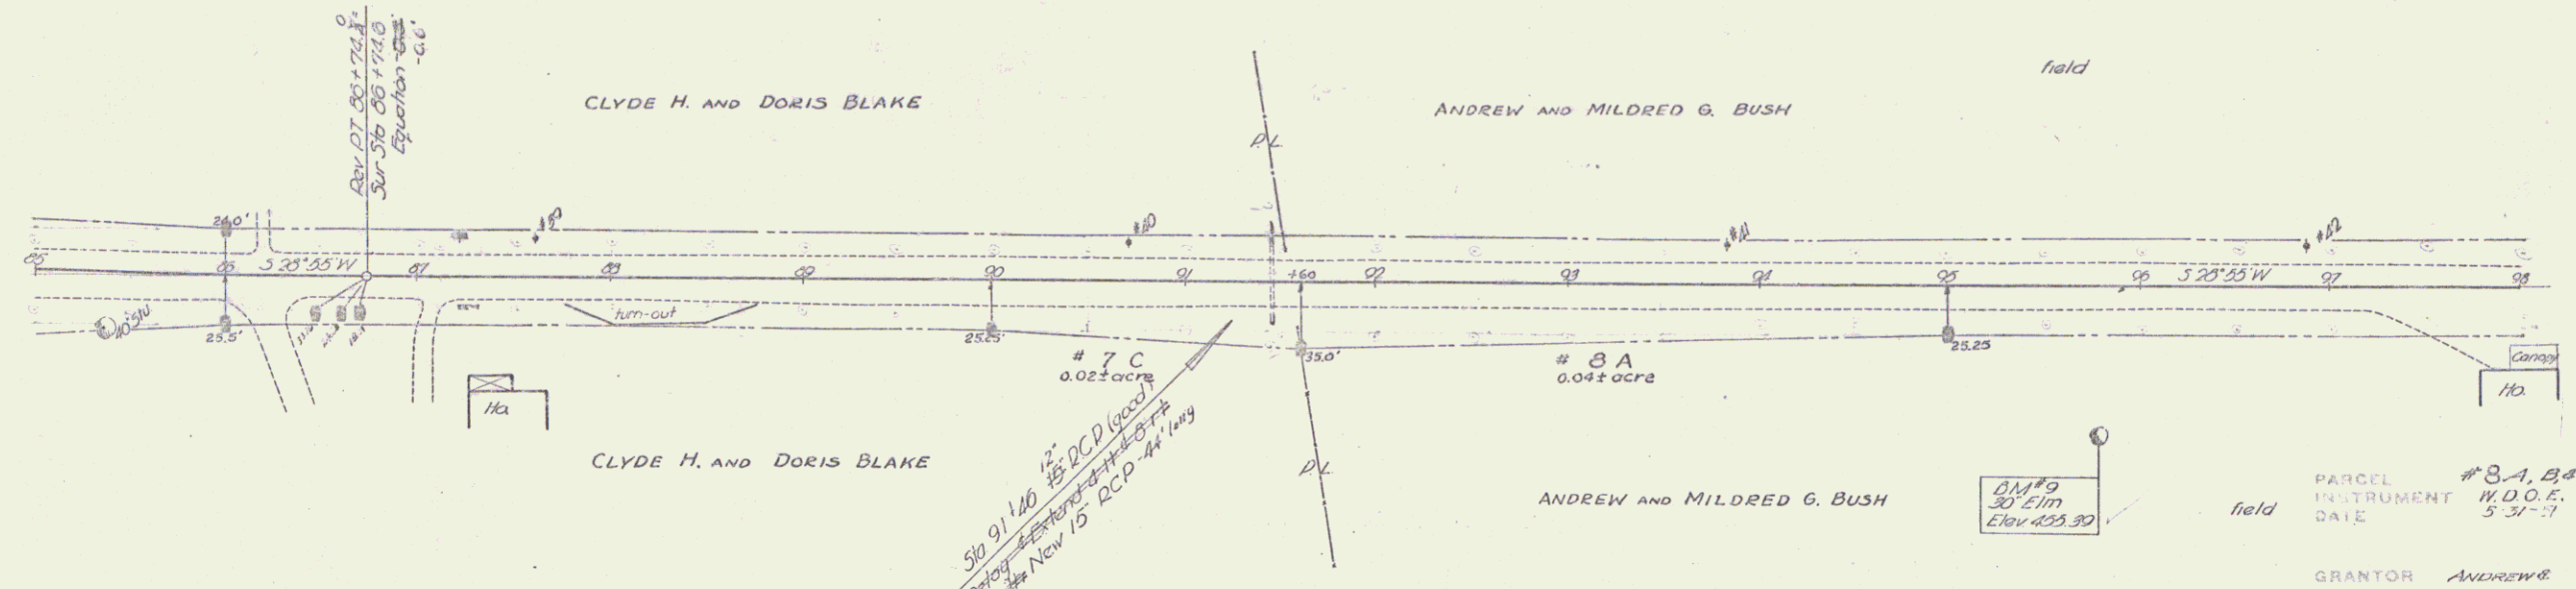

PARCEL #8 A, B, C #8 D
INSTRUMENT W.D.O.E. W.D.O.E.
DATE 5-31-51 8-11-52

GRANTOR Andrew & Mildred G. Bush Andrew & Mildred G. Bush
GRANTEE STATE OF VERMONT STATE OF VERMONT

RECORDED ENOSBURG ENOSBURG
BOOK 49 47
PAGE 380-81-82 3-4
DATE 6-7-51 8-11-52
REMARKS B&C on sheet of D on sheet 24.

