
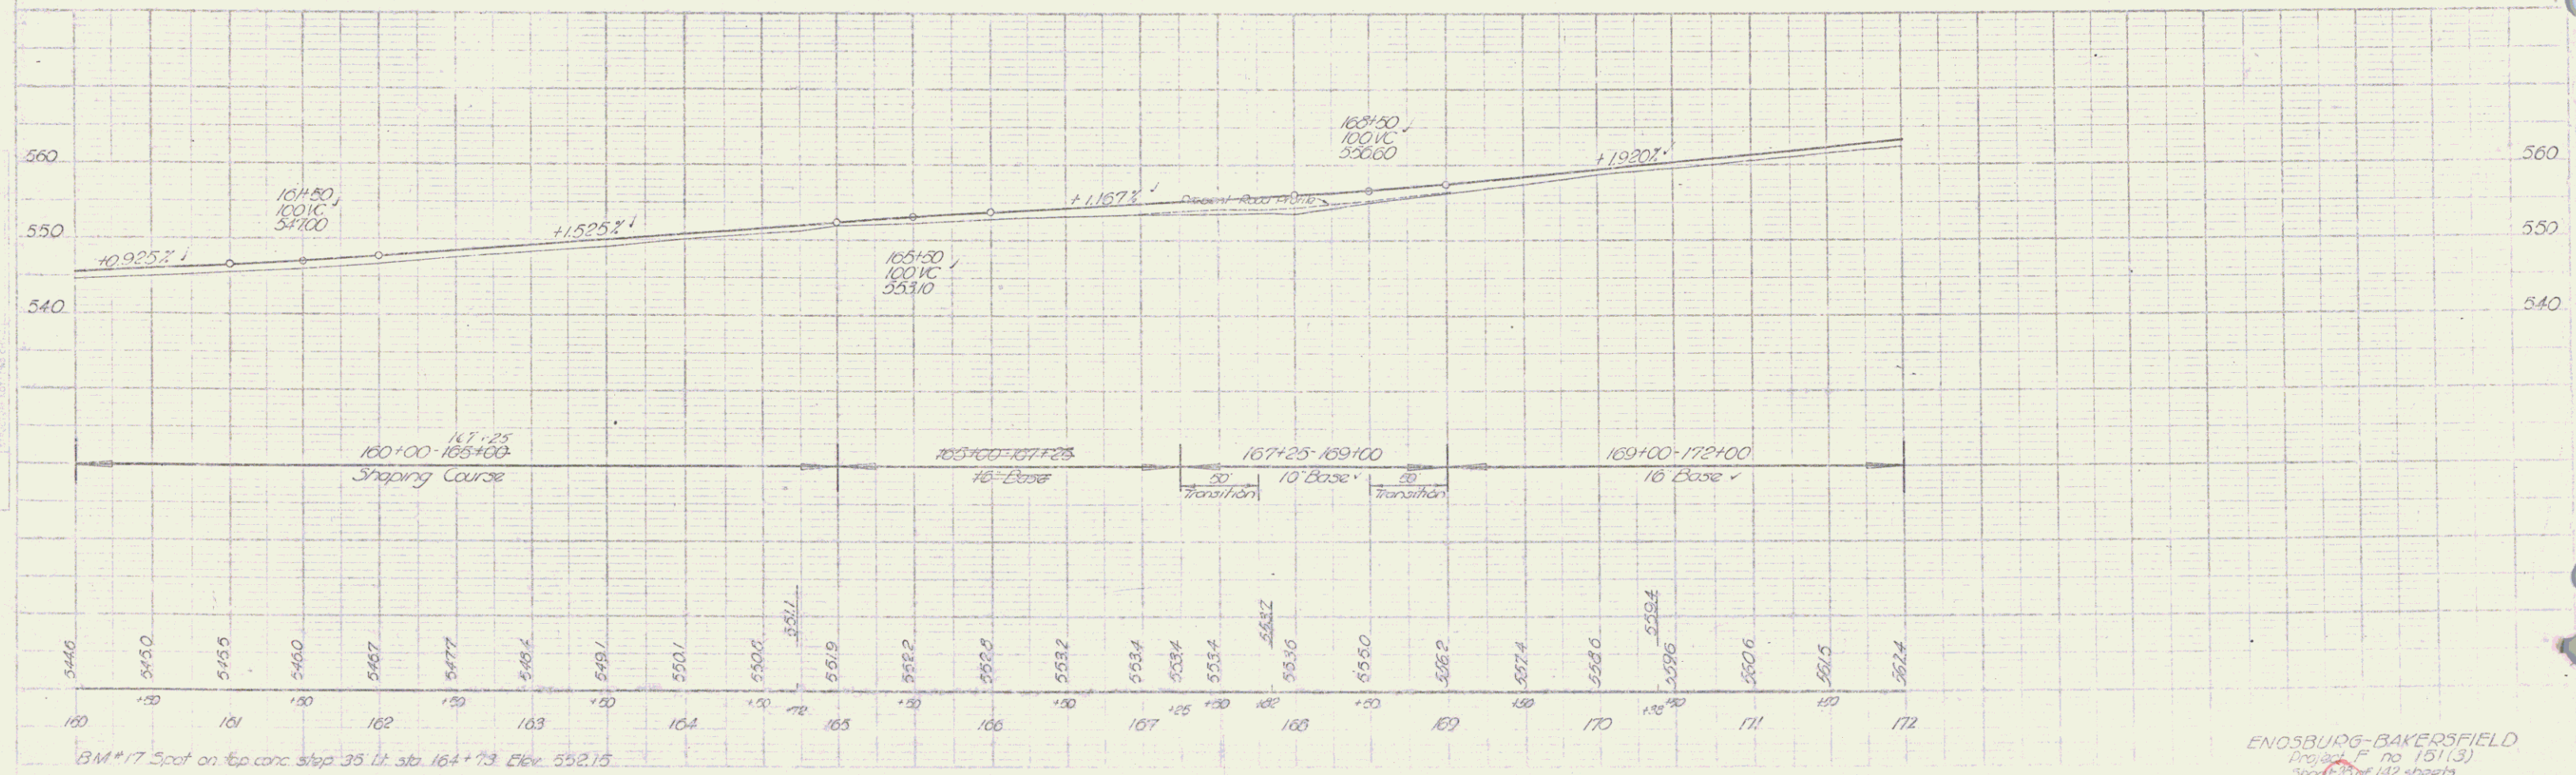


FED. ROAD DIST.	STATE	PROJ. NO.	SHEET NO.	TOTAL SHEETS
1	VT			

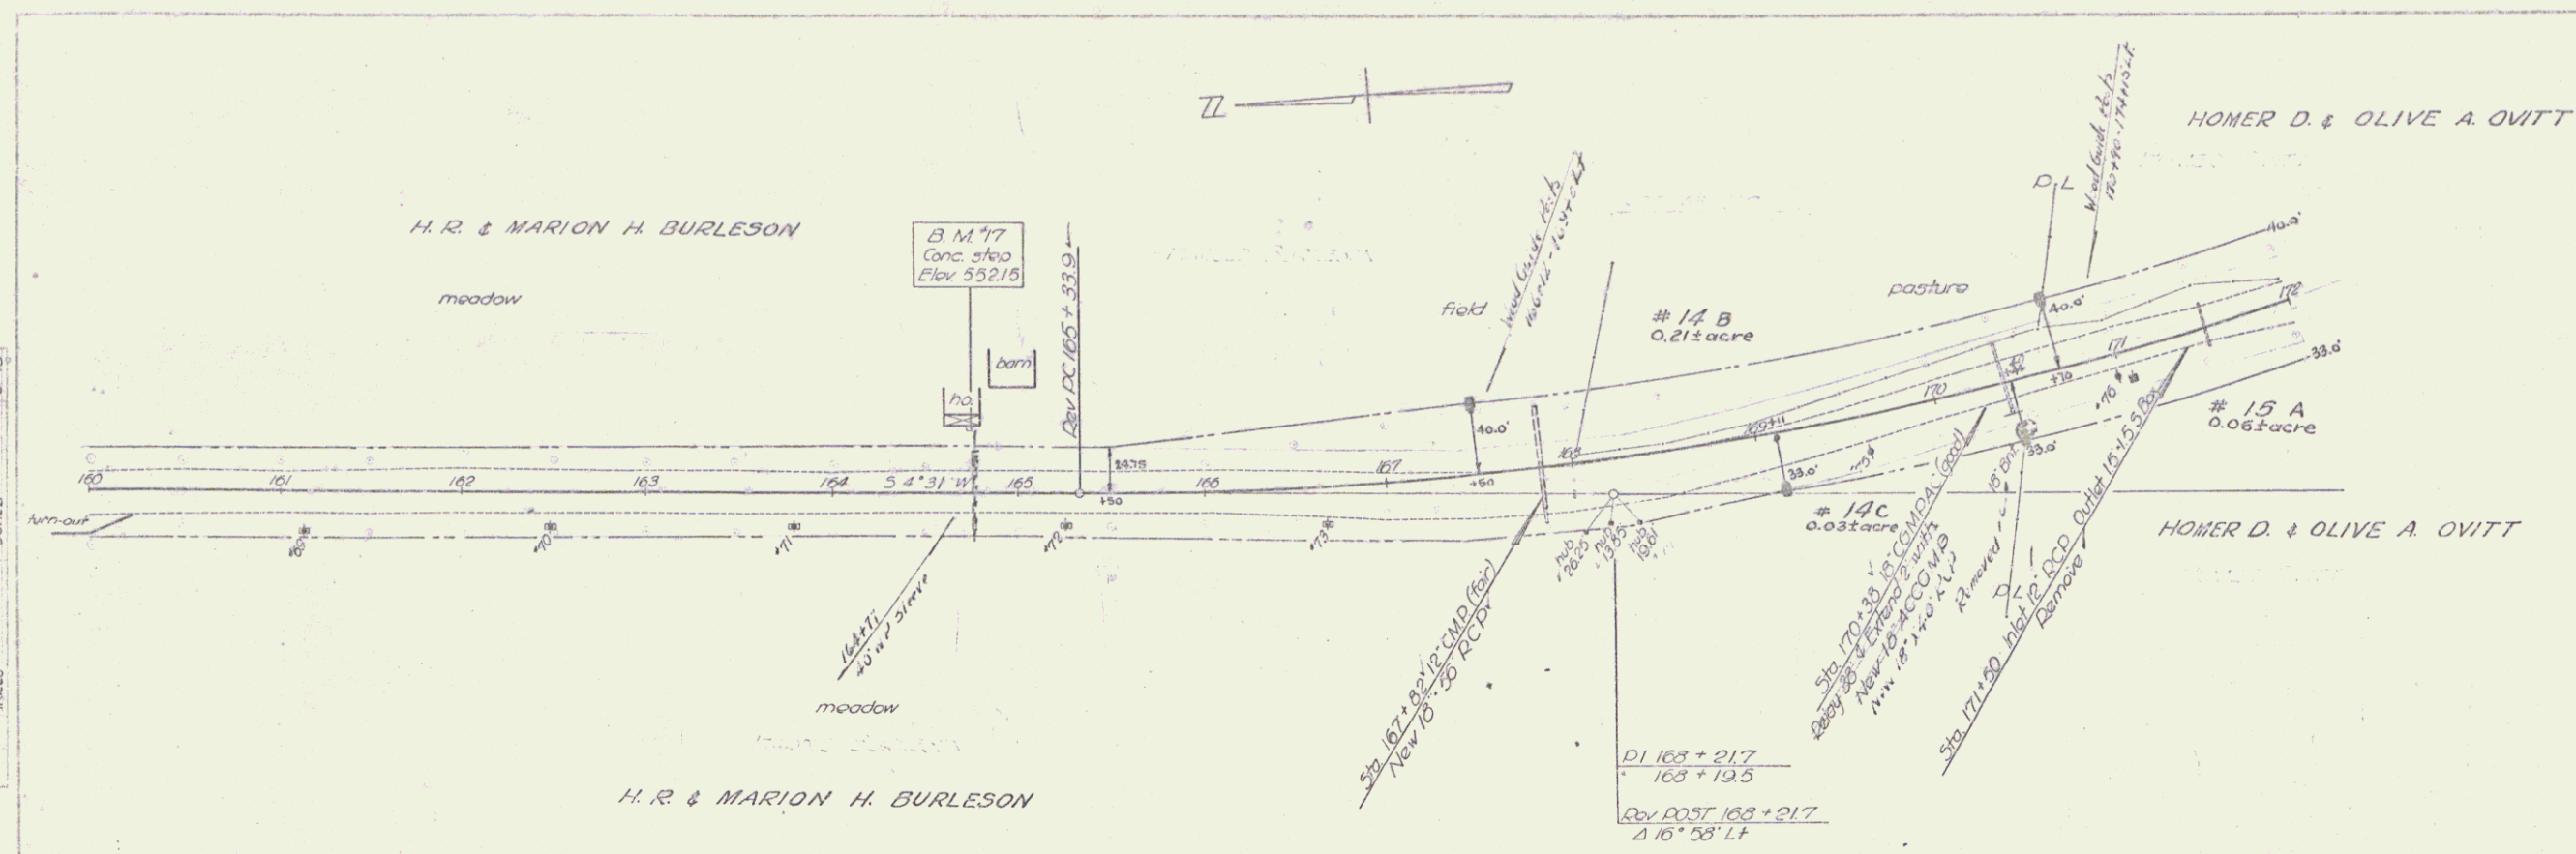

B. Fisher
Jones
11-17
6-18

B. Fisher
Jones
11-17
6-18