


Two Cable Girded Riv.

266+48 - 266+91	24
266+91 - 267+25	14
267+25 - 267+43	18
267+43 - 269+23	14
270+30 - 271+10	14
271+53 - 274+0	14

Δ 36° 56' 01"
 D 10'
 L 573.7
 T 191.6
 L 369.3
 E 31.0
 Bank 1/2 per ft

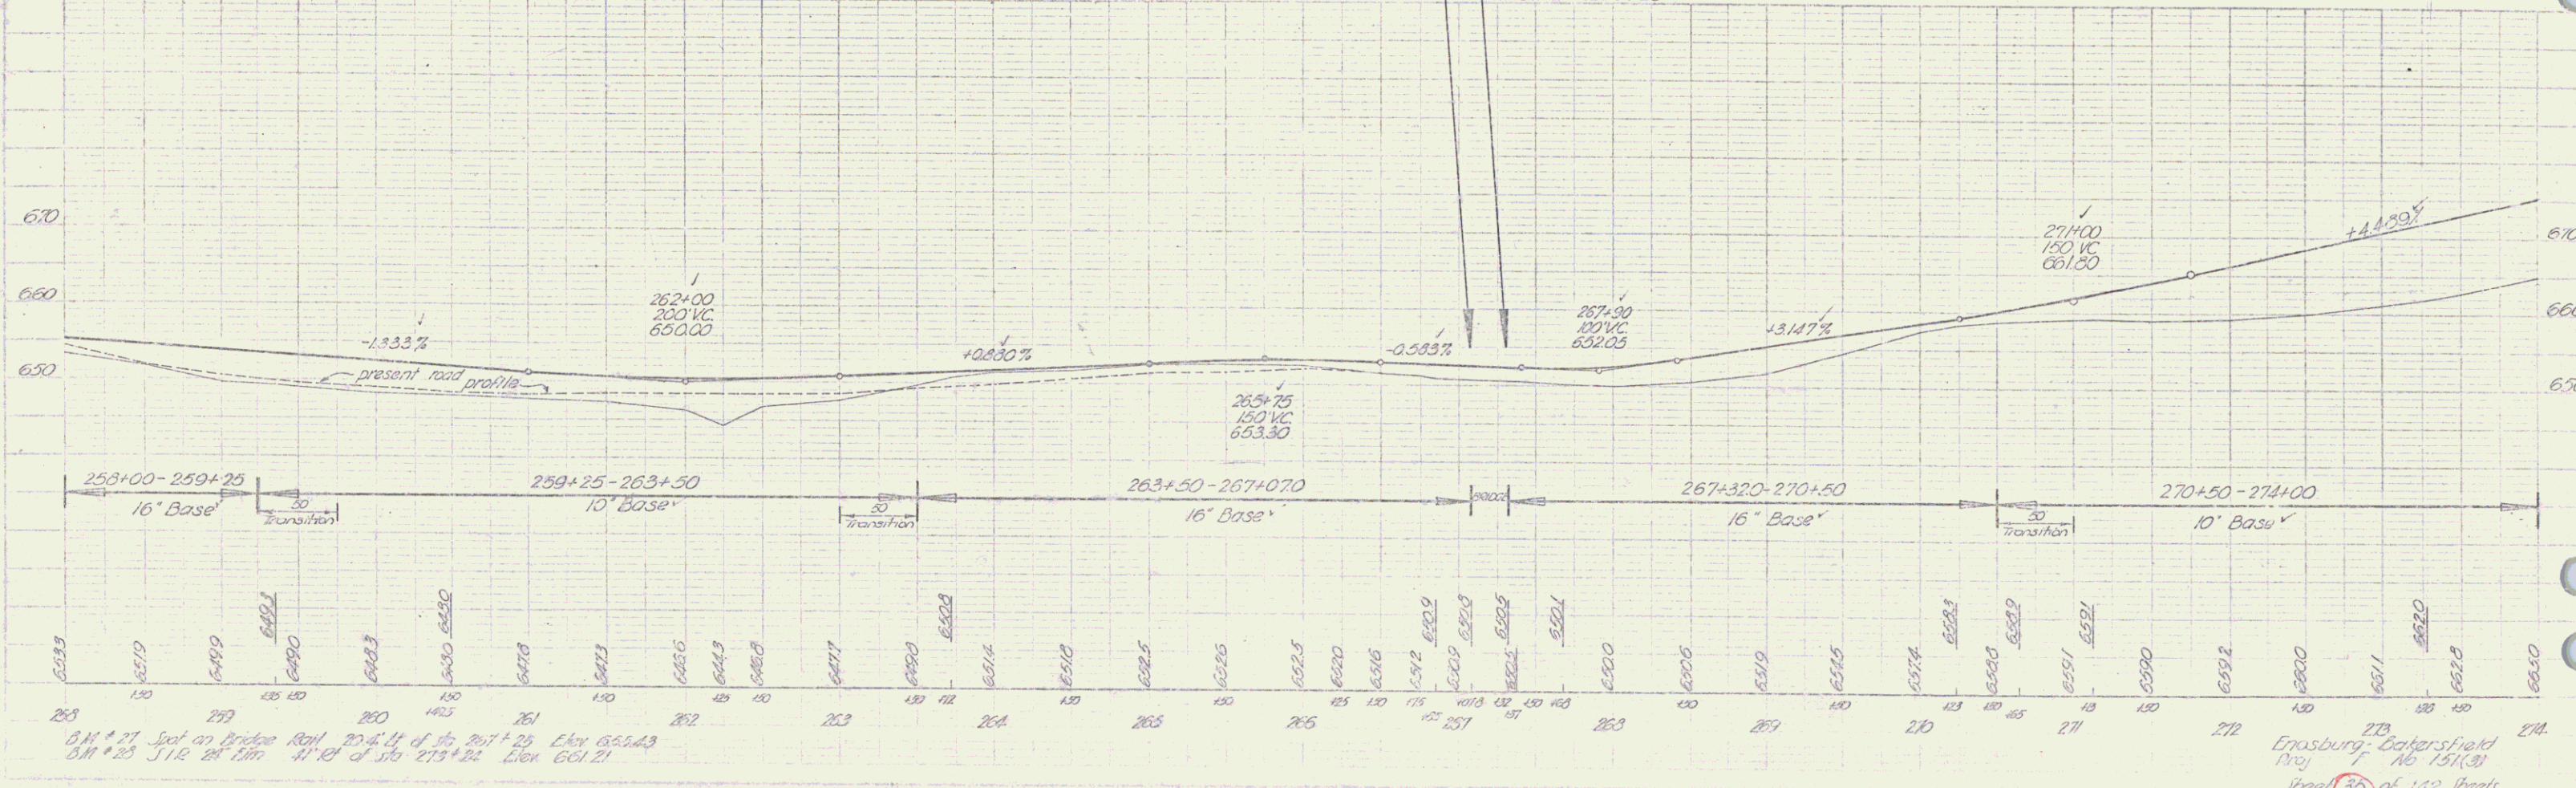

BM # 27 Set on Bridge Rail 20' E of Sta 267+25 Elev 655.43
 BM # 25 Set on Elm 41' E of Sta 273+24 Elev 661.21

Ernsburg-Dakota Field
 Proj No 151(3)
 Sheet 35 of 142 sheets