


PLAN  
 DRAWN BY  
 CHECKED BY  
 DATE  
 SHEET NO.

PROFILE  
 DRAWN BY  
 CHECKED BY  
 DATE  
 SHEET NO.

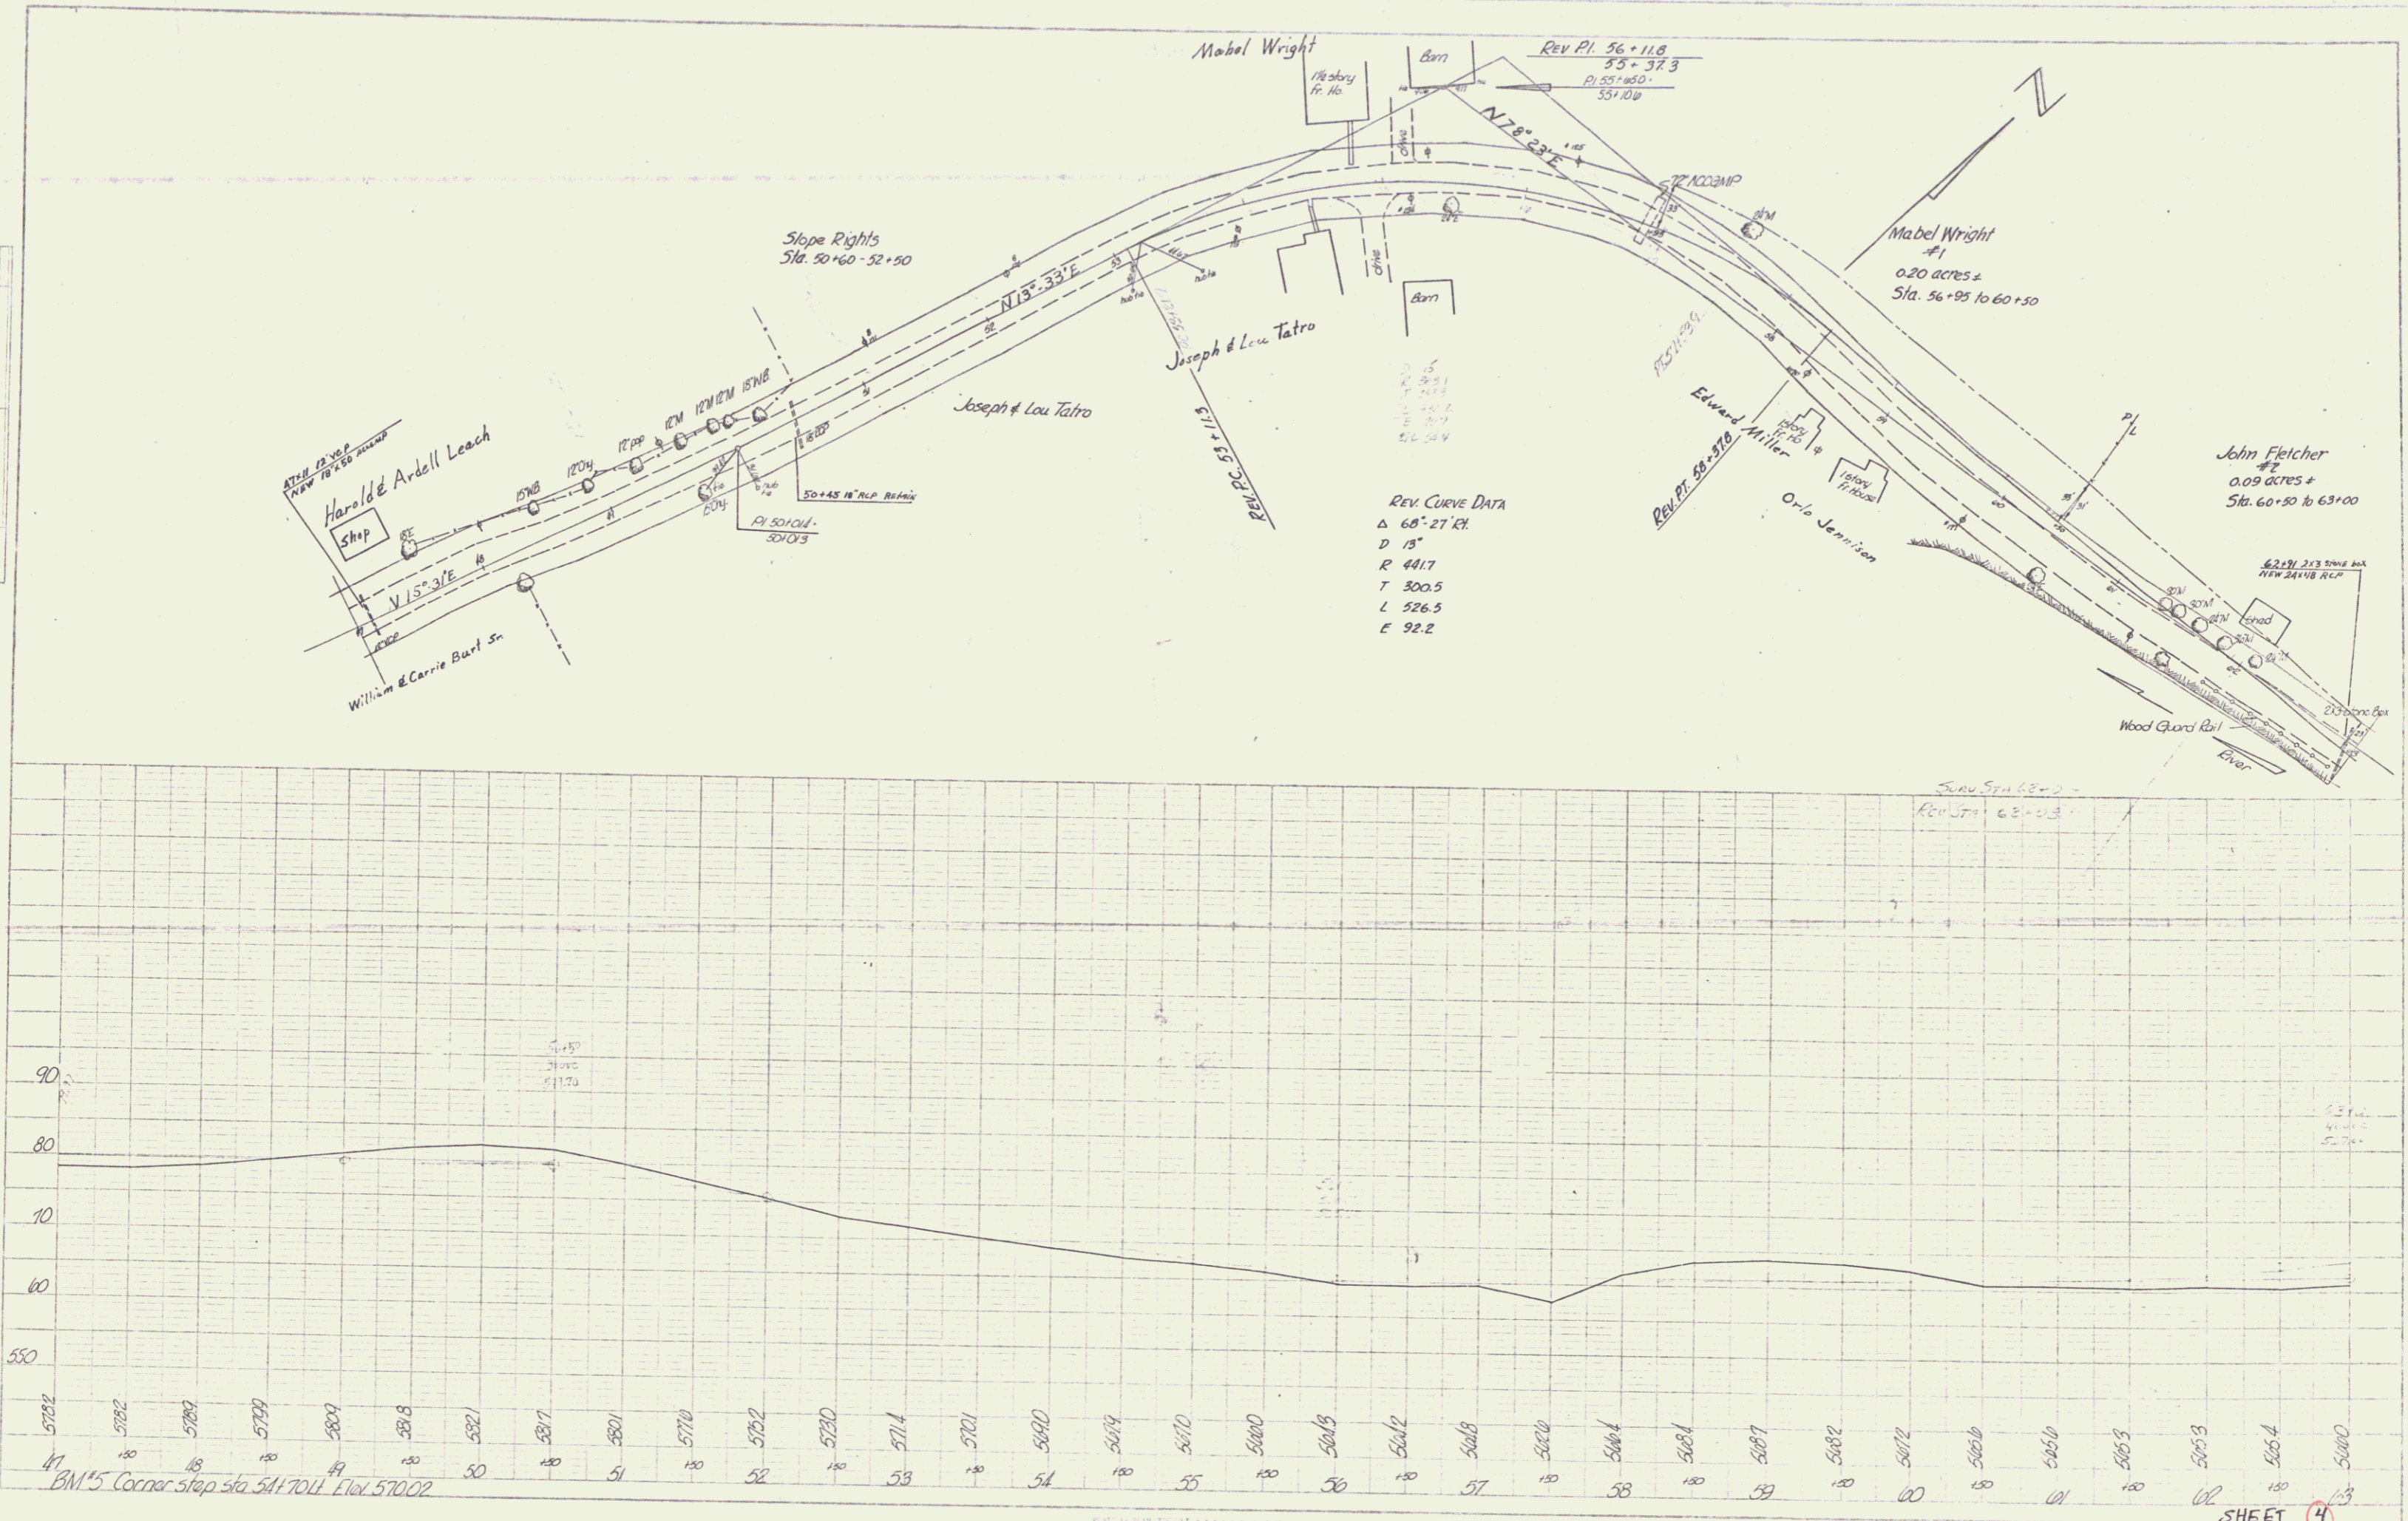

SHEET 4