


PLAN
 DATE: 12/30/33
 BY: C. J. Cummings
 CHECKED: C. J. Cummings
 NOTE BOOK: 12/30/33
 NO. 12/30/33

PROFILE
 DATE: 12/30/33
 BY: C. J. Cummings
 CHECKED: C. J. Cummings
 NOTE BOOK: 12/30/33
 NO. 12/30/33

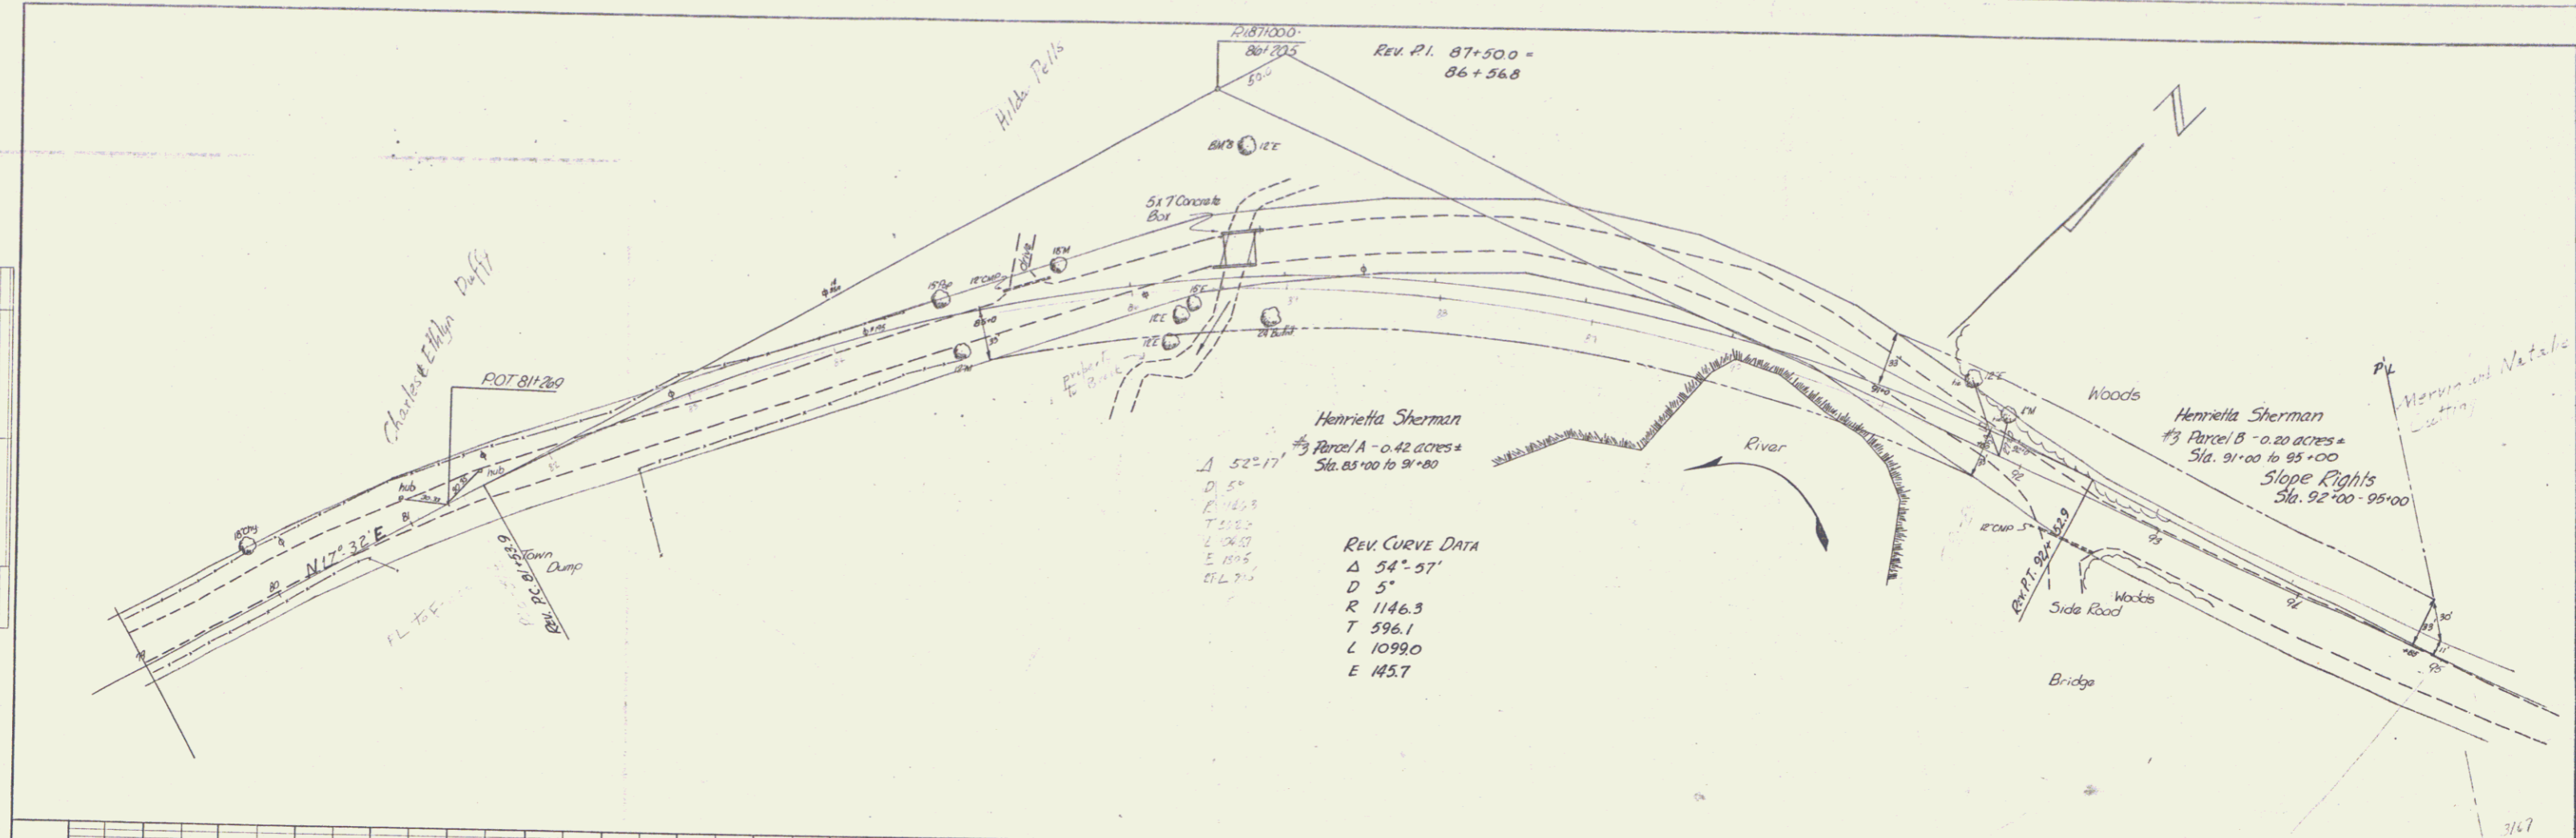

Henrietta Sherman
 Parcel A - 0.42 acres
 Sta. 83+00 to 91+00

REV CURVE DATA
 $\Delta 54^{\circ} 57'$
 $D 5'$
 $R 1146.3$
 $T 596.1$
 $L 1099.0$
 $E 145.7$

