
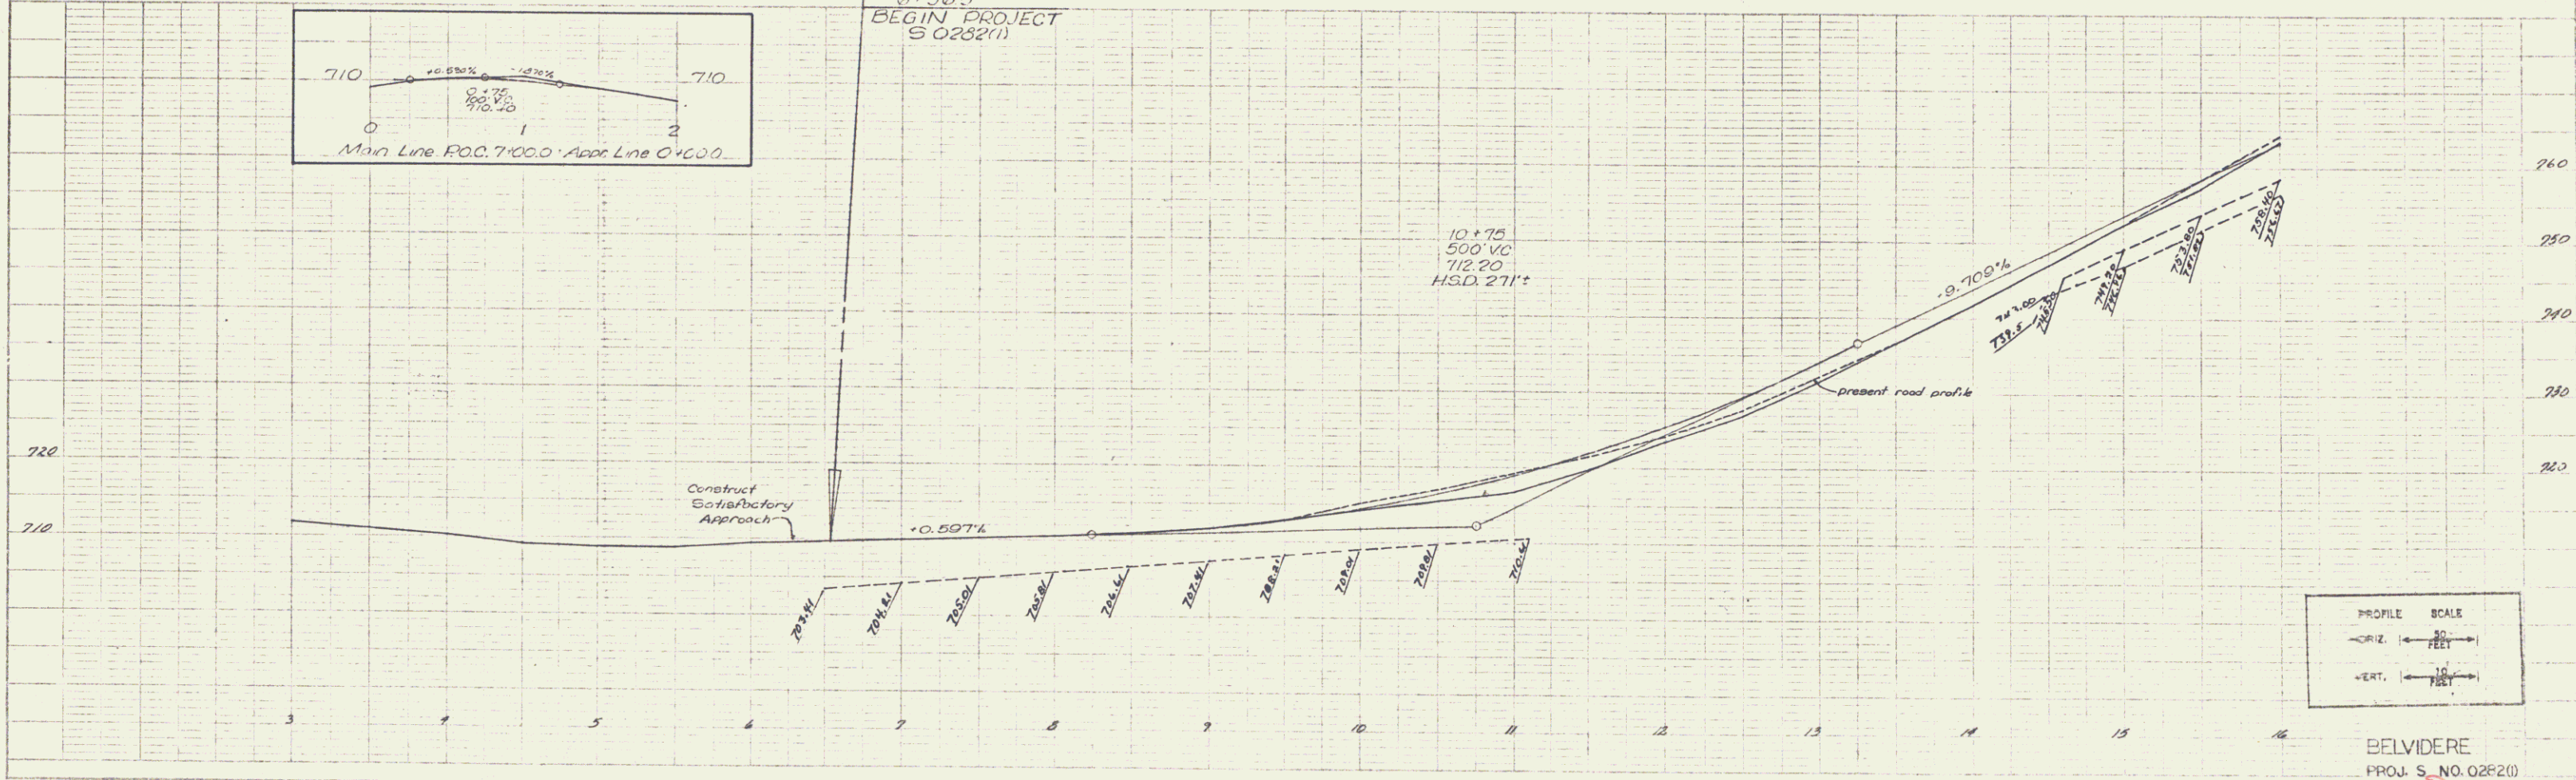


PLAN
 DRAWN BY: [Name]
 CHECKED BY: [Name]
 DATE: [Date]

PROFILE
 DRAWN BY: [Name]
 CHECKED BY: [Name]
 DATE: [Date]

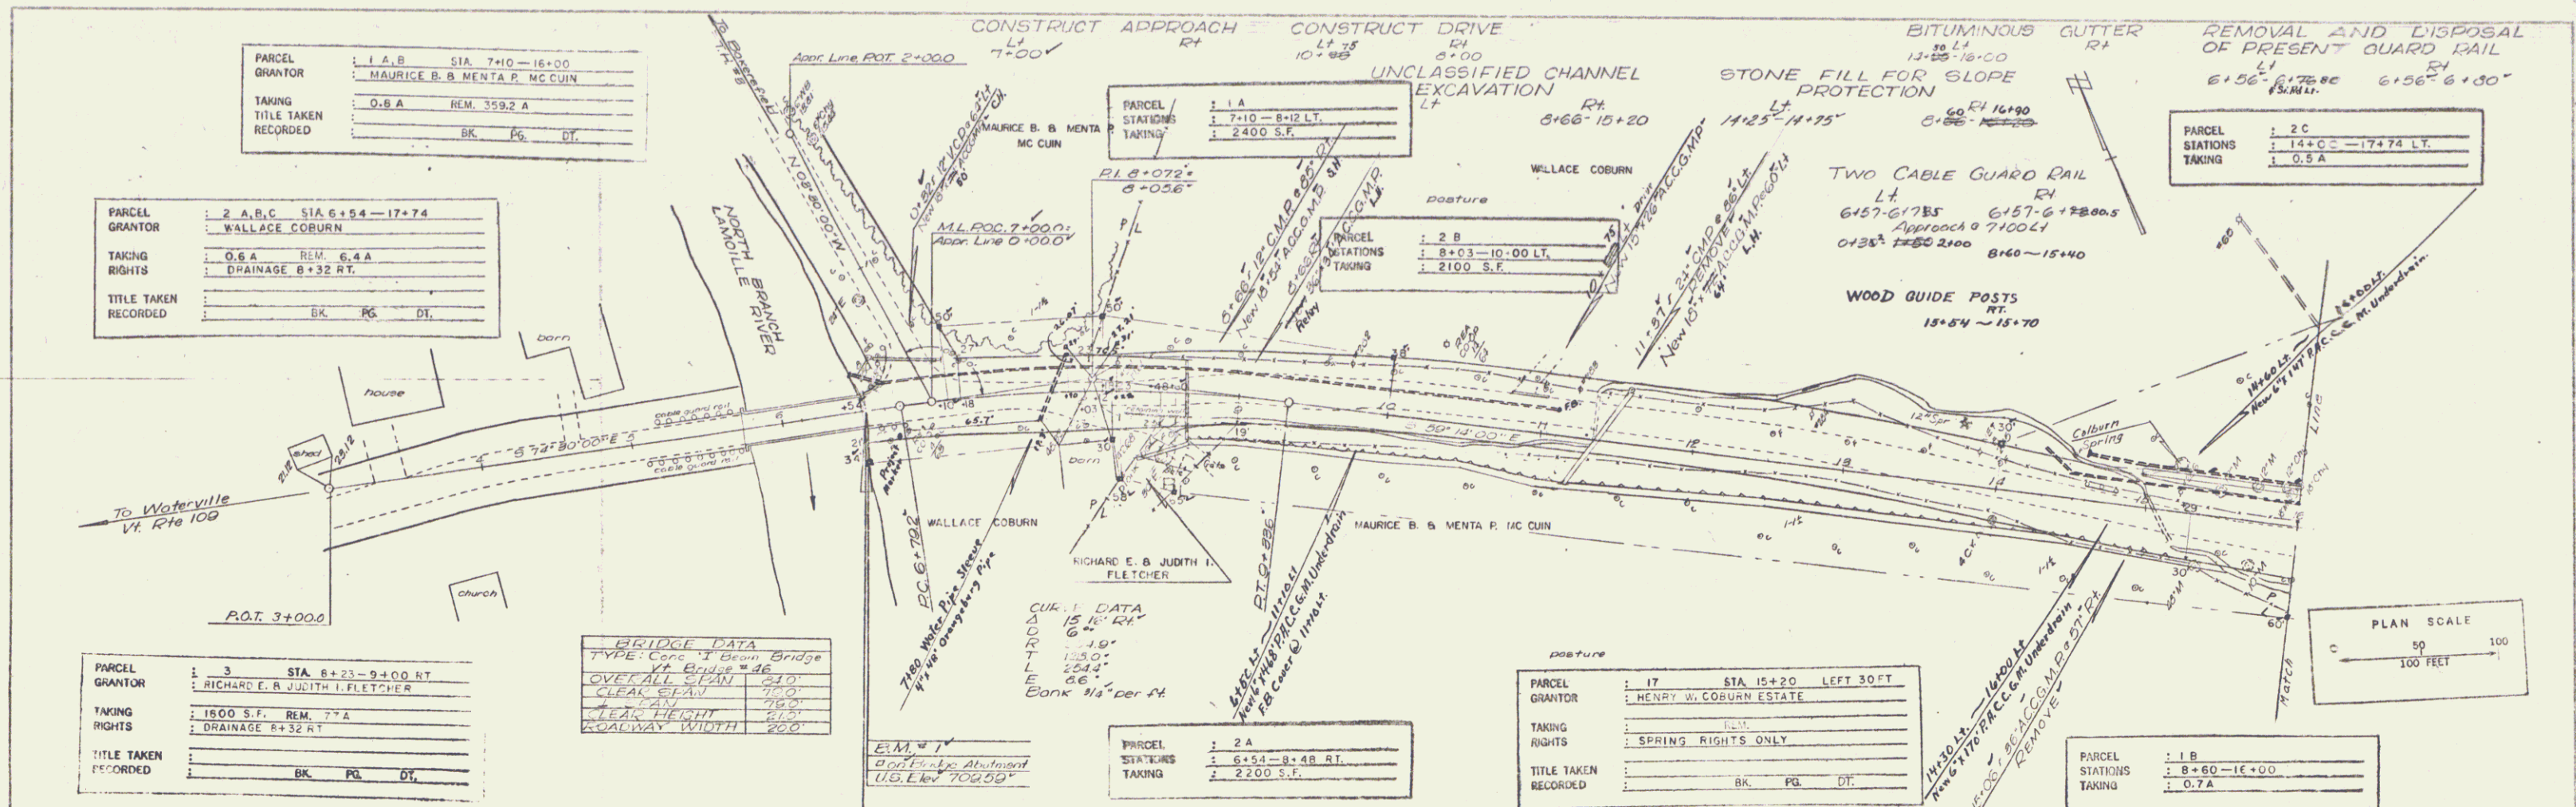

BELVIDERE
 PROJ. S. NO. 0282(1)
 SHEET 19 OF 36