
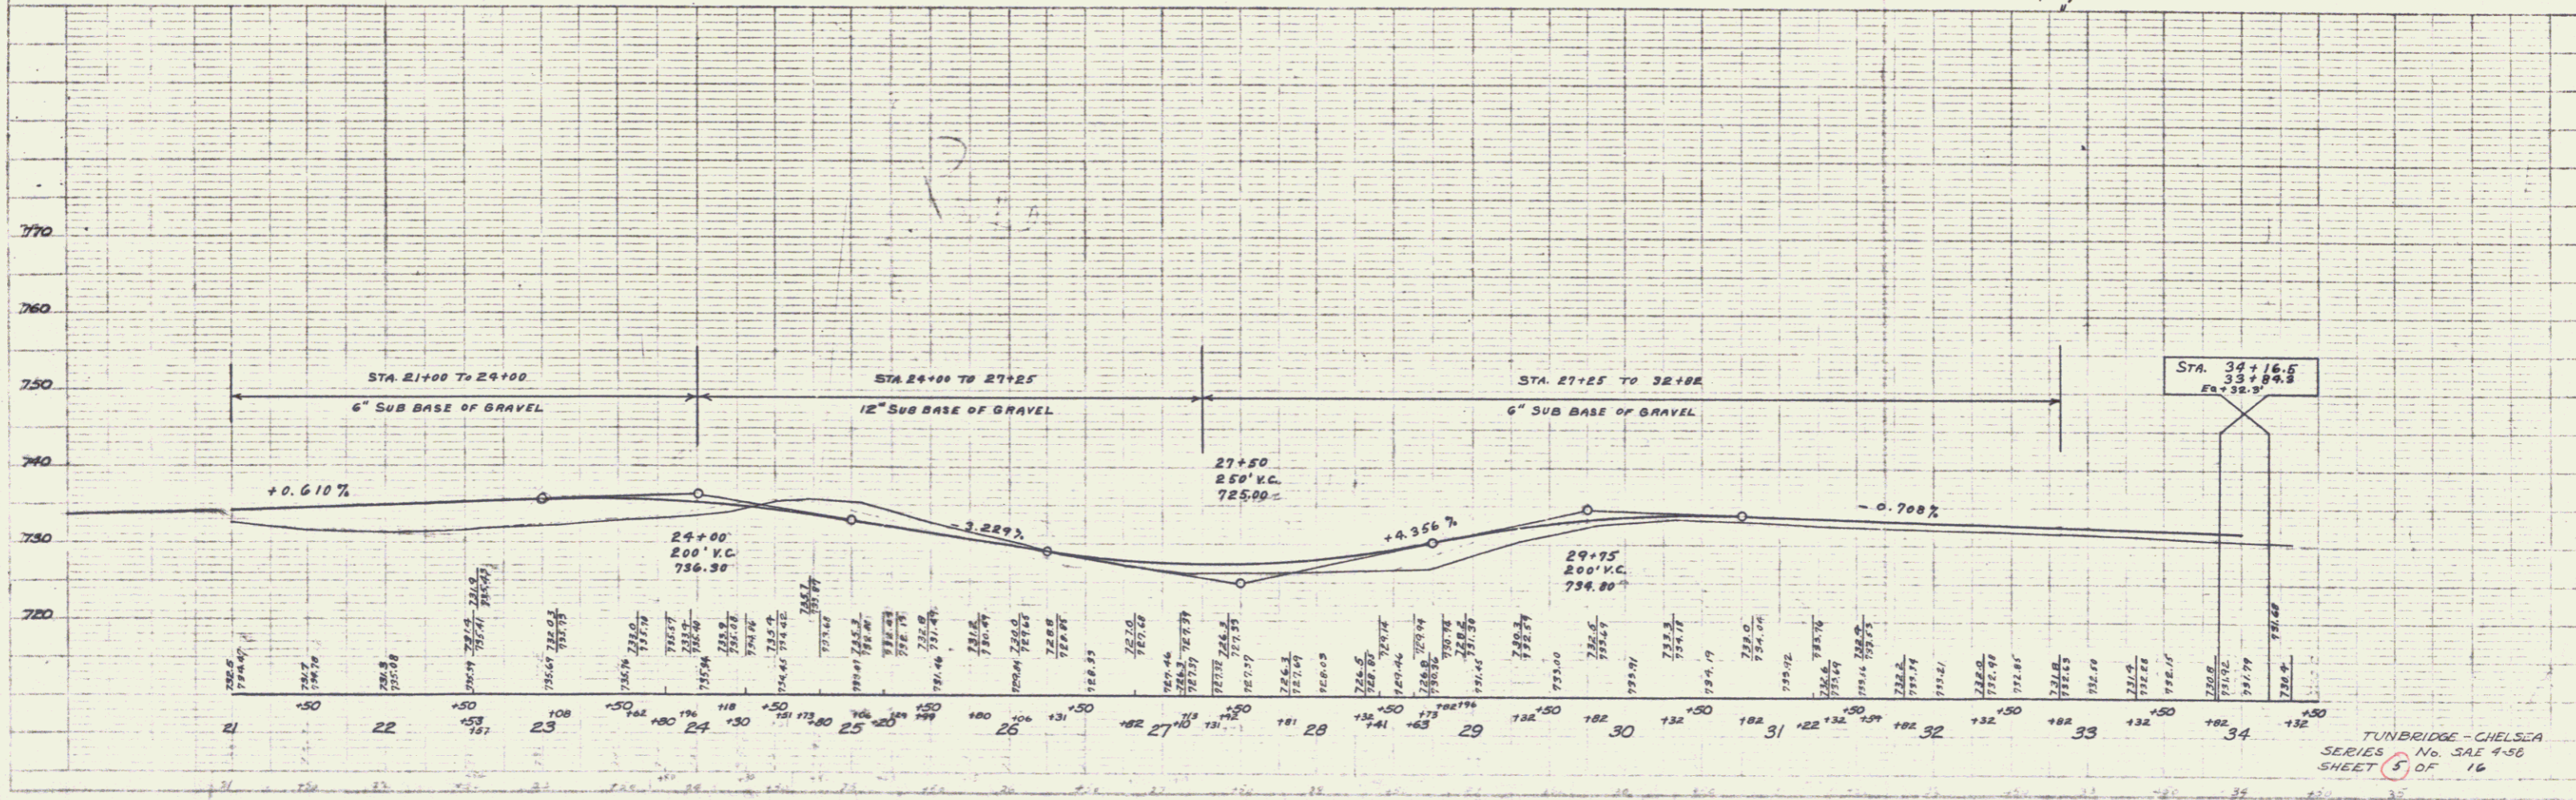


**CORRUGATED GALV METAL PIPE CULVERTS (BIT COATED)**

STA	DIA	LENGTH	CRM
27+13	15"	44	2.7
28+76	24"	46	5.4

PROJECT	STATE	NO.	DATE	SHEET	TOTAL
	MA	34E	4-58	5	16

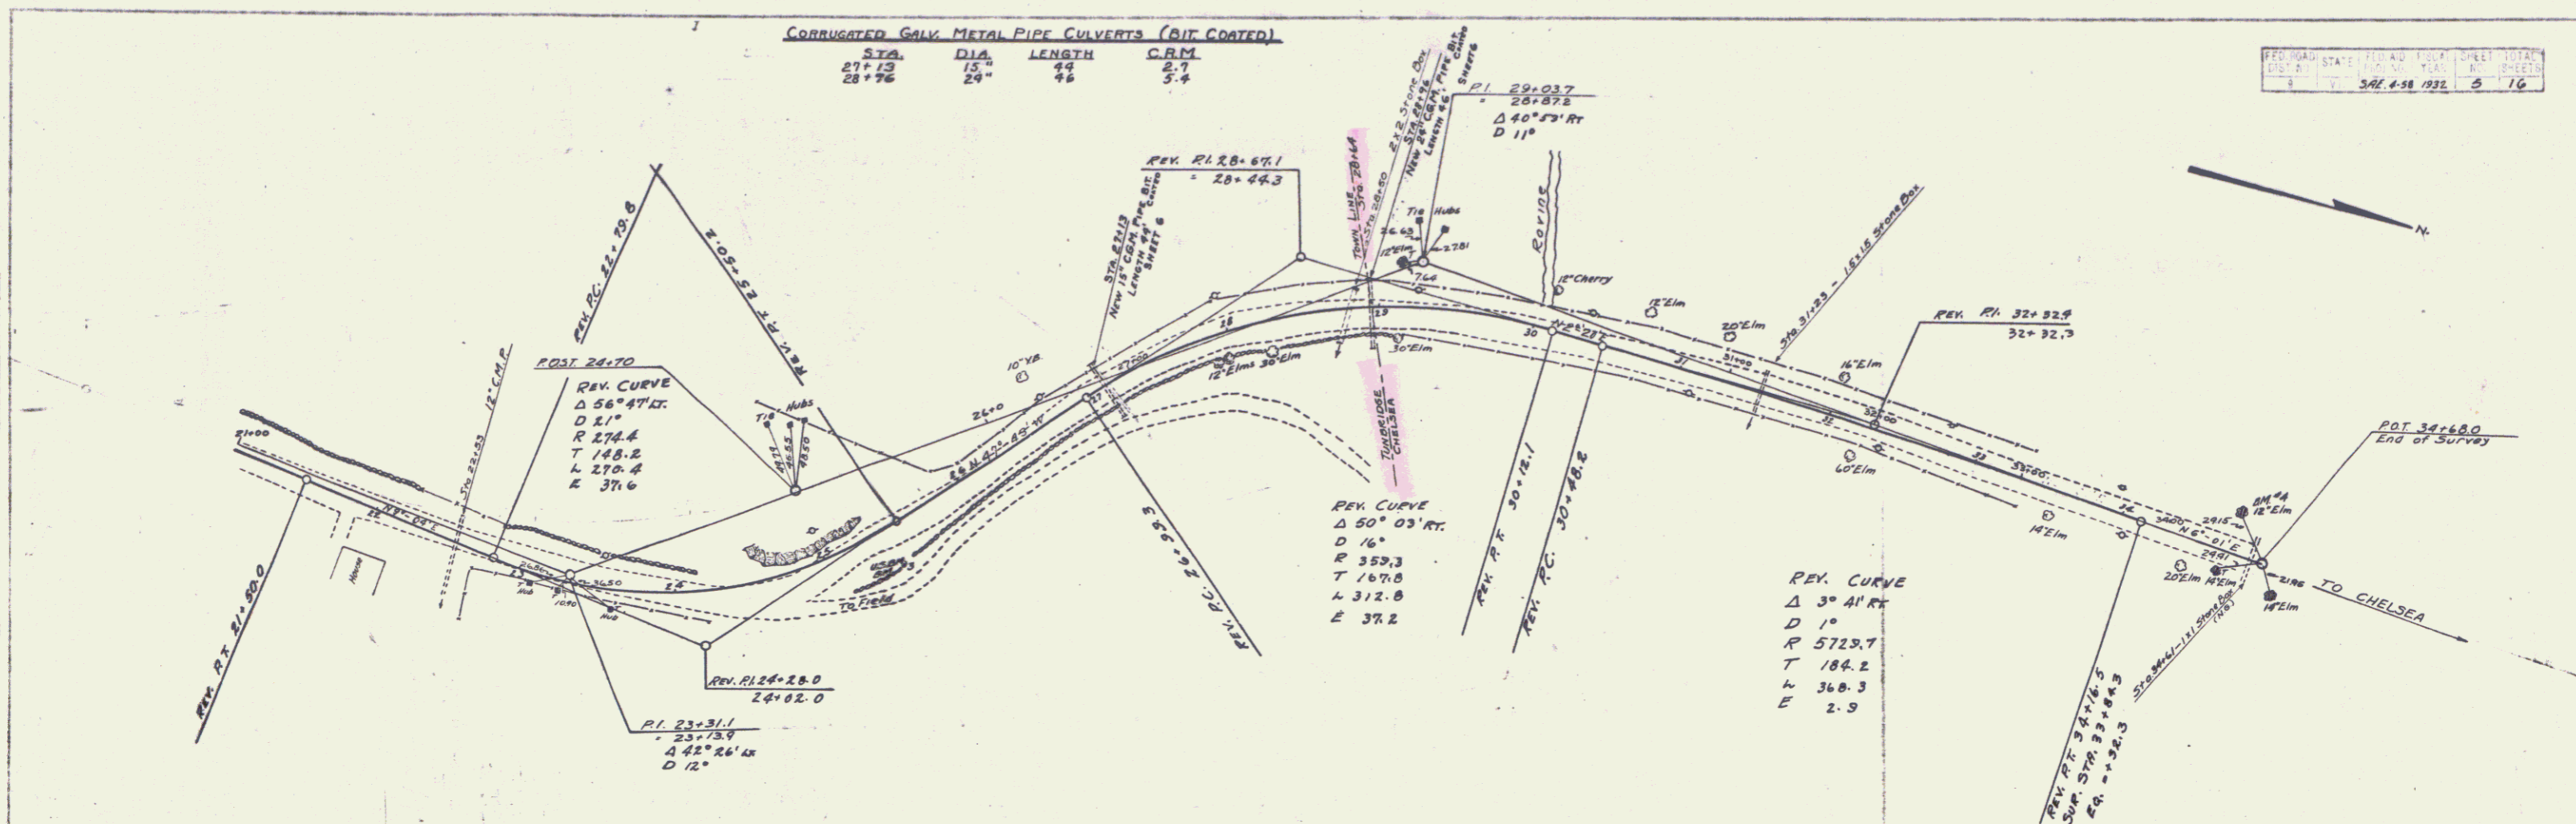

TUNBRIDGE-CHELSEA  
 SERIES No. 34E 4-58  
 SHEET 5 OF 16